


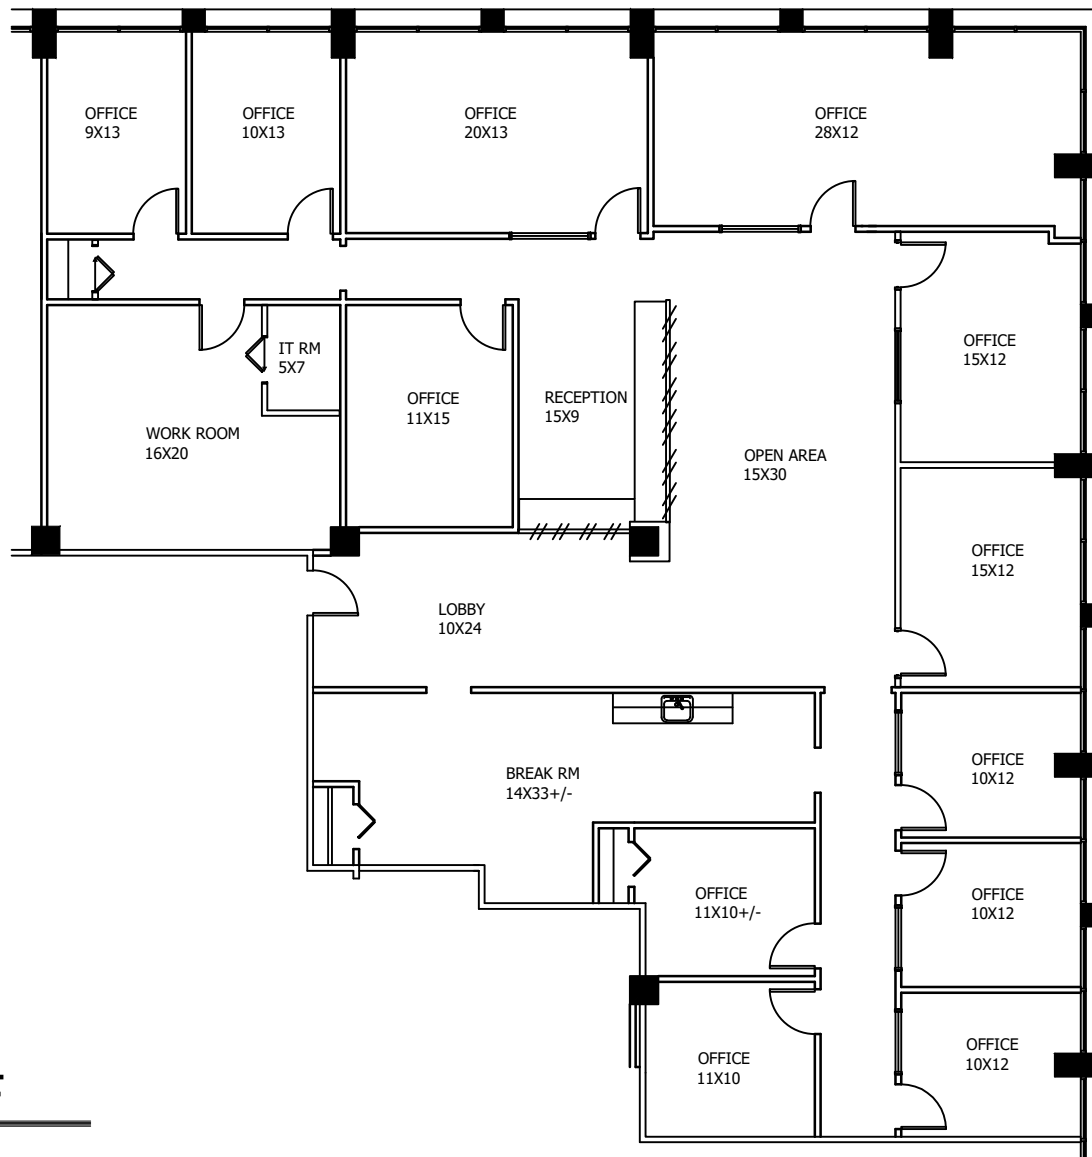

SUITE 440--4,352 RSF

SCALE: N.T.S.

TWO CROWN CENTER--AS-BUILT

1745 PHOENIX BLVD.
ATLANTA, GA 30349

7.2.23

ARCHITECTURAL DESIGN INNOVATIONS

ADI, Inc.