

AS BUILT-1 Main Level 1/8" = 1'-0"

Sheet Index		
AS Built Drawings		
	AS BUILT-1	0. Main Level
	AS BUILT-2	1. Upper Level
	AS BUILT-3	Generic View / MAIN
	AS BUILT-4	Generic View / UPPER

Building Area Schedule			
Home Story	Floor Area	Type	Area
Main Level			
	1. HEATED MAIN	Commercial Heated	2,743.57
	2. CAGES	Commercial Heated	612.28
	3. STORAGE	Internal N/H	32.32
	4.PORCH	External / Covered	68.53
	5. FRONT PORCH	External / Covered	60.00
Upper Level			
	1.APT. A	Internal Heated Zone	1,185.76
	2.APT B	Internal Heated Zone	391.11
	3. PORCH	External / Covered	76.09
			5,169.66 ft²




GENERAL NOTES:
1. DO NOT USE AS A BLUEPRINTS WITHOUT MR LLC PERMISSION.
2. PLEASE NOTE INTERIOR DIMENSIONS WERE NOT USED IN CALCULATING SQUARE FOOTAGE
3. SIZE OF HEATED AND NOT HEATED AREA AND OTHER INFORMATION WERE OBTAINED PER THE NC REAL ESTATE COMMISSION GUIDELINES (6" FOR EXTERNAL WALLS EXCEPT CONDOMINIUMS)
4. FOR REMODELING QUESTIONS OR MORE DETAILED CAD DRAWINGS (INC.SITE PLAN, SECTIONS, ELEVATIONS) ALSO 3D MODEL PLEASE CONTACT ALFRED ZALYS
MOB. 828 231 7305 E-MAIL: A.ZALYS@HOTMAIL.COM
5. THE FURNITURE SHOWN IS FOR ILLUSTRATIVE PURPOSES ONLY, INTENDED TO ENHANCE MARKETING VISUALS AND BETTER UNDERSTAND SPACE DESIGN

Client:

#Client E-mail
#Client Phone Number

LEGEND MAP:
HEATED COMMERC. FINISHED
HEATED RESIDENTIAL FINISHED
NOT HEATED/NOT FINISHED
COVERED PORCH
OPEN DECK

Revision History

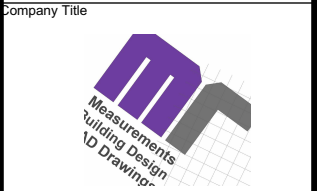


Company
Measure Rite LLC
103 Poplar Spring Trl. Hendersonville
Henderson County 28739

Site Address
**1275 Tunnel Rd, Asheville, NC
28805 Animal Hospital East**

Drawing Name
**Main Level, Building Area
Schedule, Sheet Index**

Drawing Status
AS BUILT

Contact Name
Alfred ZALYS
mob. 828 231 7305
Job Nr.
MR 1207
Date
7/29/2025
Drawing Scale
1/8" = 1'-0"
Layout Nr.
ANSI B
Paper Size
ANSI B
Layout ID
AS BUILT-1
Revision

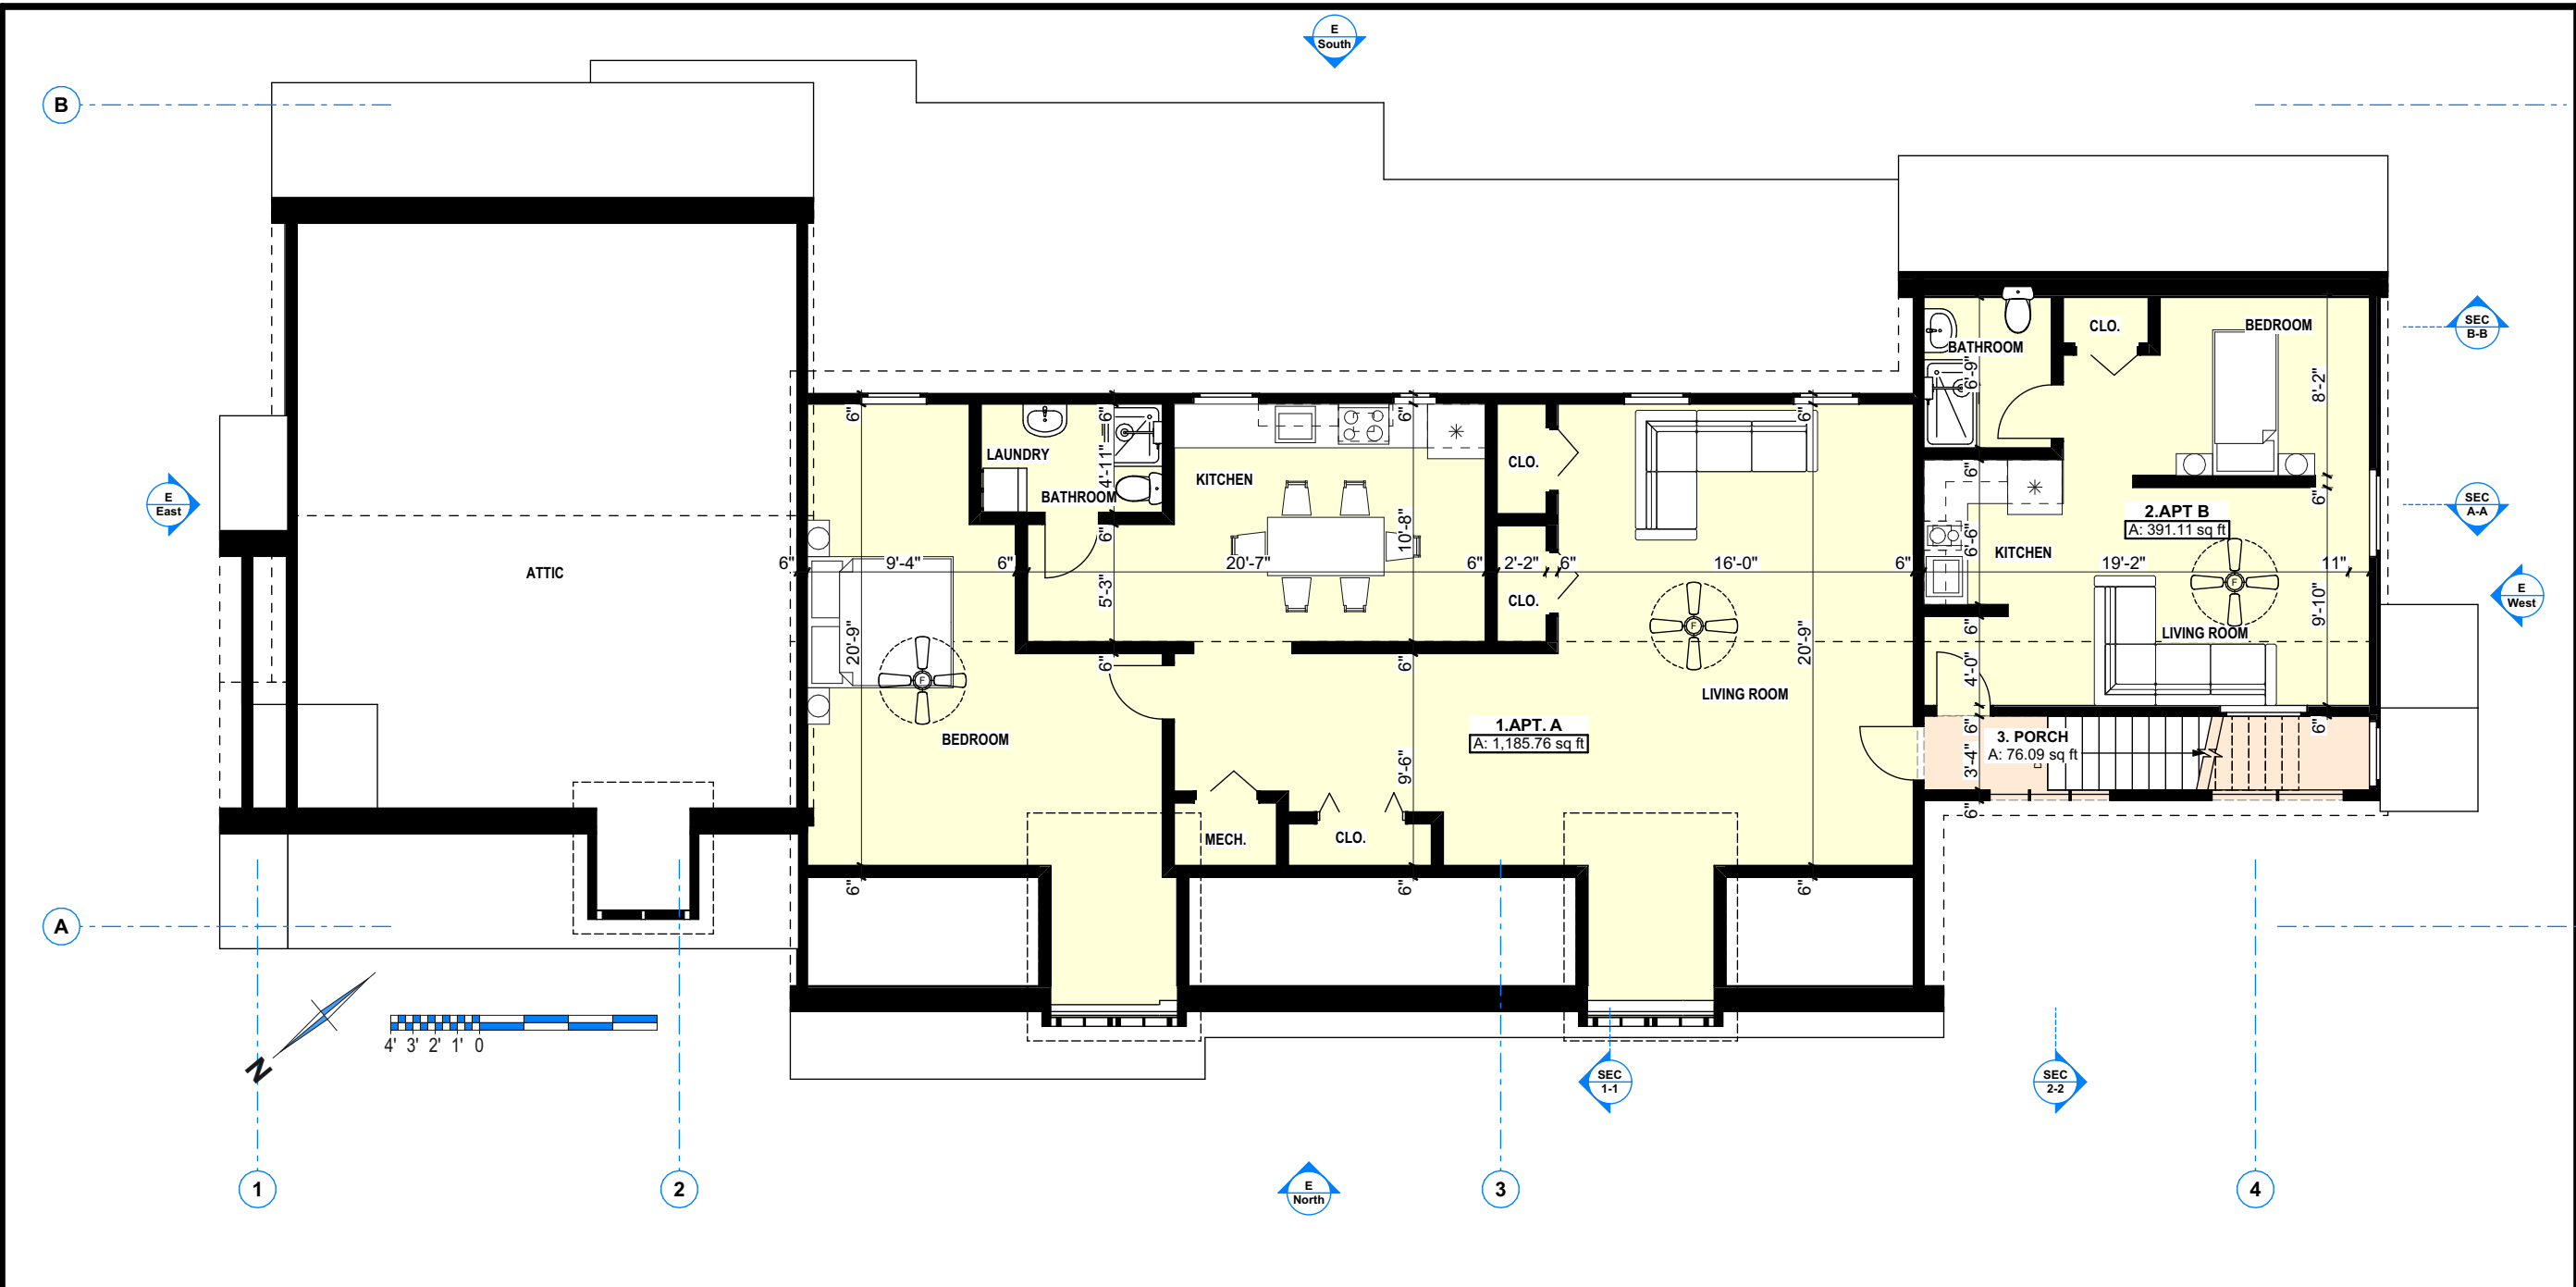

AS BUILT-2 Upper Level 1/8" = 1'-0"

Sheet Index		
AS Built Drawings		
	AS BUILT-1	0. Main Level
	AS BUILT-2	1. Upper Level
	AS BUILT-3	Generic View / MAIN
	AS BUILT-4	Generic View / UPPER

Building Area Schedule			
Home Story	Floor Area	Type	Area
Main Level			
	1. HEATED MAIN	Commercial Heated	2,743.57
	2. CAGES	Commercial Heated	612.28
	3. STORAGE	Internal N/H	32.32
	4.PORCH	External / Covered	68.53
	5. FRONT PORCH	External / Covered	60.00
Upper Level			
	1.APT. A	Internal Heated Zone	1,185.76
	2.APT B	Internal Heated Zone	391.11
	3. PORCH	External / Covered	76.09
			5,169.66 ft²




GENERAL NOTES:
1. DO NOT USE AS A BLUEPRINTS WITHOUT MR LLC PERMISSION.
2. PLEASE NOTE INTERIOR DIMENSIONS WERE NOT USED IN CALCULATING SQUARE FOOTAGE
3. SIZE OF HEATED AND NOT HEATED AREA AND OTHER INFORMATION WERE OBTAINED PER THE NC REAL ESTATE COMMISSION GUIDELINES (6" FOR EXTERNAL WALLS EXCEPT CONDOMINIUMS)
4. FOR REMODELING QUESTIONS OR MORE DETAILED CAD DRAWINGS (INC.SITE PLAN, SECTIONS, ELEVATIONS) ALSO 3D MODEL PLEASE CONTACT ALFRED ZALYS
MOB. 828 231 7305 E-MAIL: A.ZALYS@HOTMAIL.COM
5. THE FURNITURE SHOWN IS FOR ILLUSTRATIVE PURPOSES ONLY, INTENDED TO ENHANCE MARKETING VISUALS AND BETTER UNDERSTAND SPACE DESIGN

Client:

#Client E-mail
#Client Phone Number

LEGEND MAP:
HEATED COMMERC. FINISHED
HEATED RESIDENTIAL FINISHED
NOT HEATED/NOT FINISHED
COVERED PORCH
OPEN DECK

Revision History

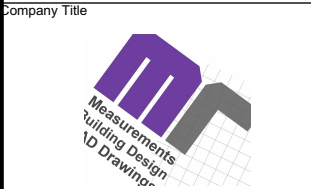


Company
Measure Rite LLC
103 Poplar Spring Trl. Hendersonville
Henderson County 28739

Site Address
**1275 Tunnel Rd, Asheville, NC
28805 Animal Hospital East**

Drawing Name
**Upper Level, Building Area
Schedule, Sheet Index**

Drawing Status
AS BUILT

Contact Name Alfred ZALYS mob. 828 231 7305	Job Nr. MR 1207 Date 7/20/2025
Drawing Scale 1/8" = 1'-0" 1:1.63, 1" = 1'-0"	Layouts Total 4 Paper Size ANSI B
Layout Nr. 1	Revision
Layout ID AS BUILT-2	

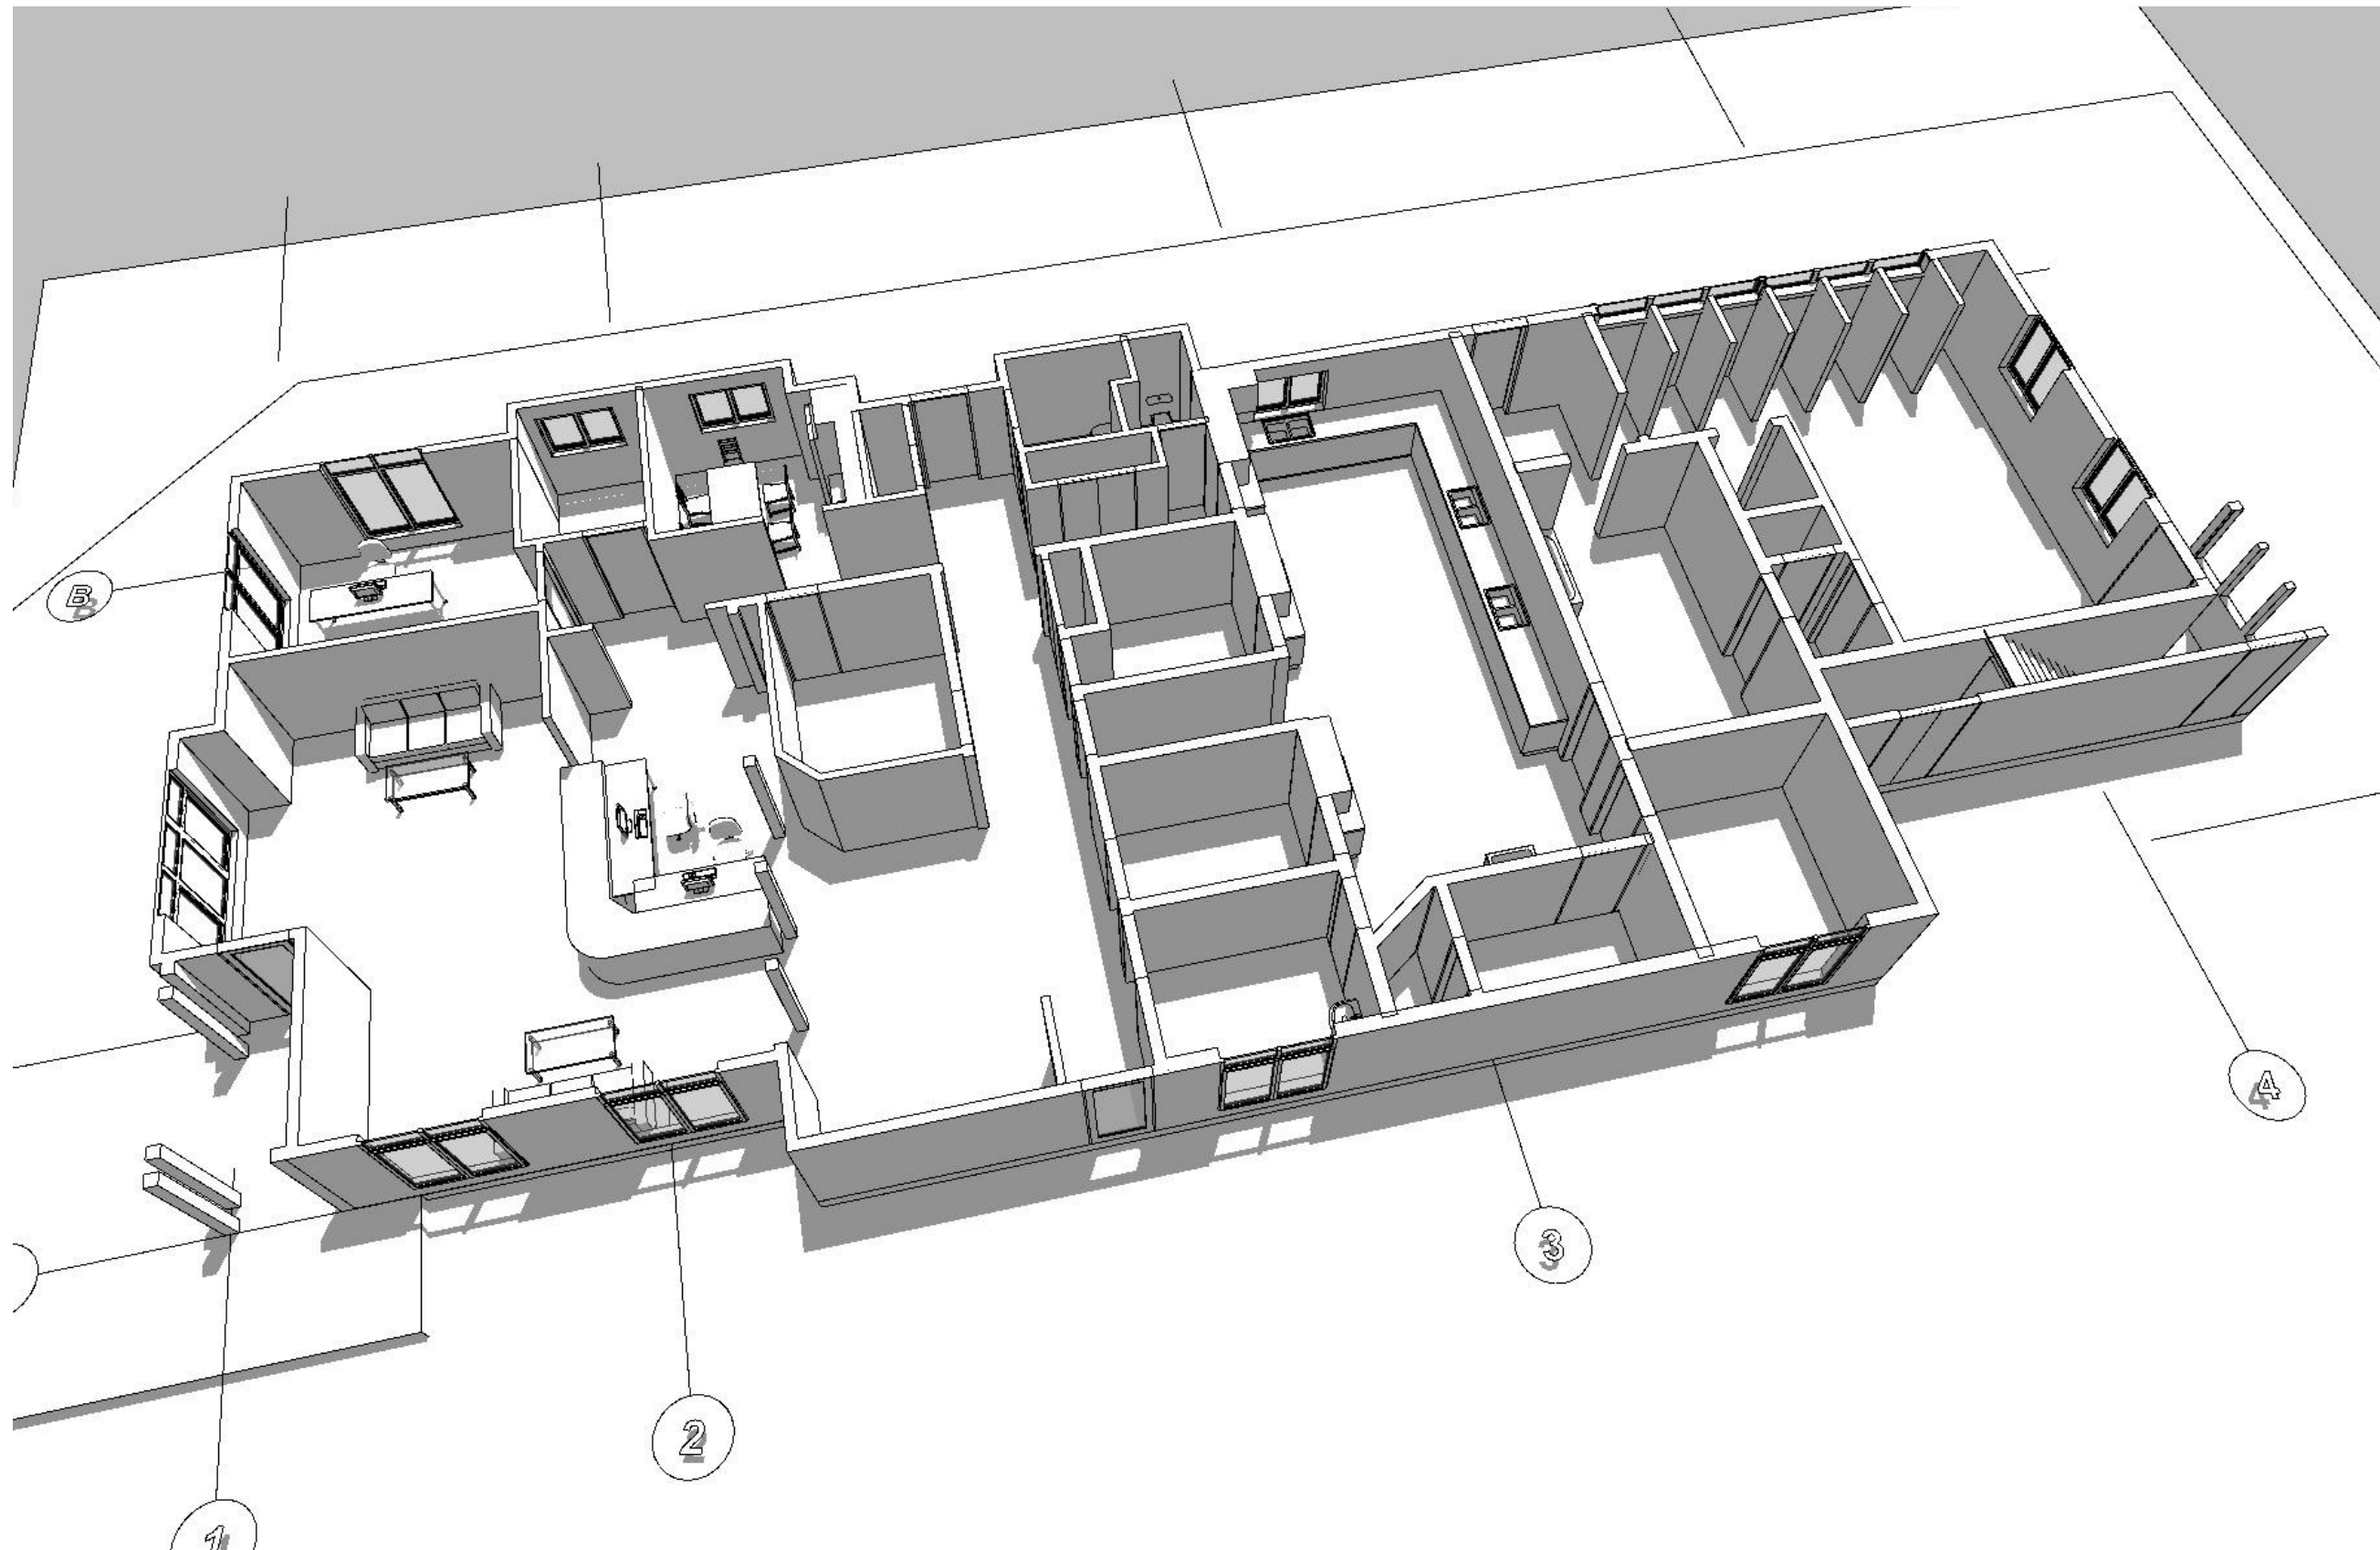

Generic Perspective / MAIN




GENERAL NOTES:
1. DO NOT USE AS A BLUEPRINTS WITHOUT MR LLC PERMISSION.
2. PLEASE NOTE INTERIOR DIMENSIONS WERE NOT USED IN CALCULATING SQUARE FOOTAGE.
3. SIZE OF HEATED AND NOT HEATED AREA AND OTHER INFORMATION WERE OBTAINED PER THE NC REAL ESTATE COMMISSION GUIDELINES (6" FOR EXTERNAL WALLS EXCEPT CONDOMINIUMS).
4. FOR REMODELING QUESTIONS OR MORE DETAILED CAD DRAWINGS (INC. SITE PLAN, SECTIONS, ELEVATIONS) ALSO 3D MODEL PLEASE CONTACT ALFRED ZALYS
MOB. 828 231 7305 E-MAIL: A.ZALYS@HOTMAIL.COM
5. THE FURNITURE SHOWN IS FOR ILLUSTRATIVE PURPOSES ONLY, INTENDED TO ENHANCE MARKETING VISUALS AND BETTER UNDERSTAND SPACE DESIGN

Client:

#Client E-mail
#Client Phone Number

LEGEND MAP:
HEATED COMMERC. FINISHED
HEATED RESIDENTIAL FINISHED
NOT HEATED/NOT FINISHED
COVERED PORCH
OPEN DECK

Revision History

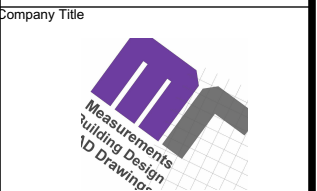


Company
Measure Rite LLC
103 Poplar Spring Trl. Hendersonville
Henderson County 28739

Site Address
**1275 Tunnel Rd, Asheville, NC
28805 Animal Hospital East**


Drawing Name
Generic Perspective / MAIN

Drawing Status
AS BUILT

Contact Name Alfred ZALYS mob. 828 231 7305	Job Nr. MR 1207 Date 7/29/2025
Drawing Scale 1/8"	Layouts Total 4
Layout Nr. 1	Paper Size ANSI B
Layout ID AS BUILT-3	Revision

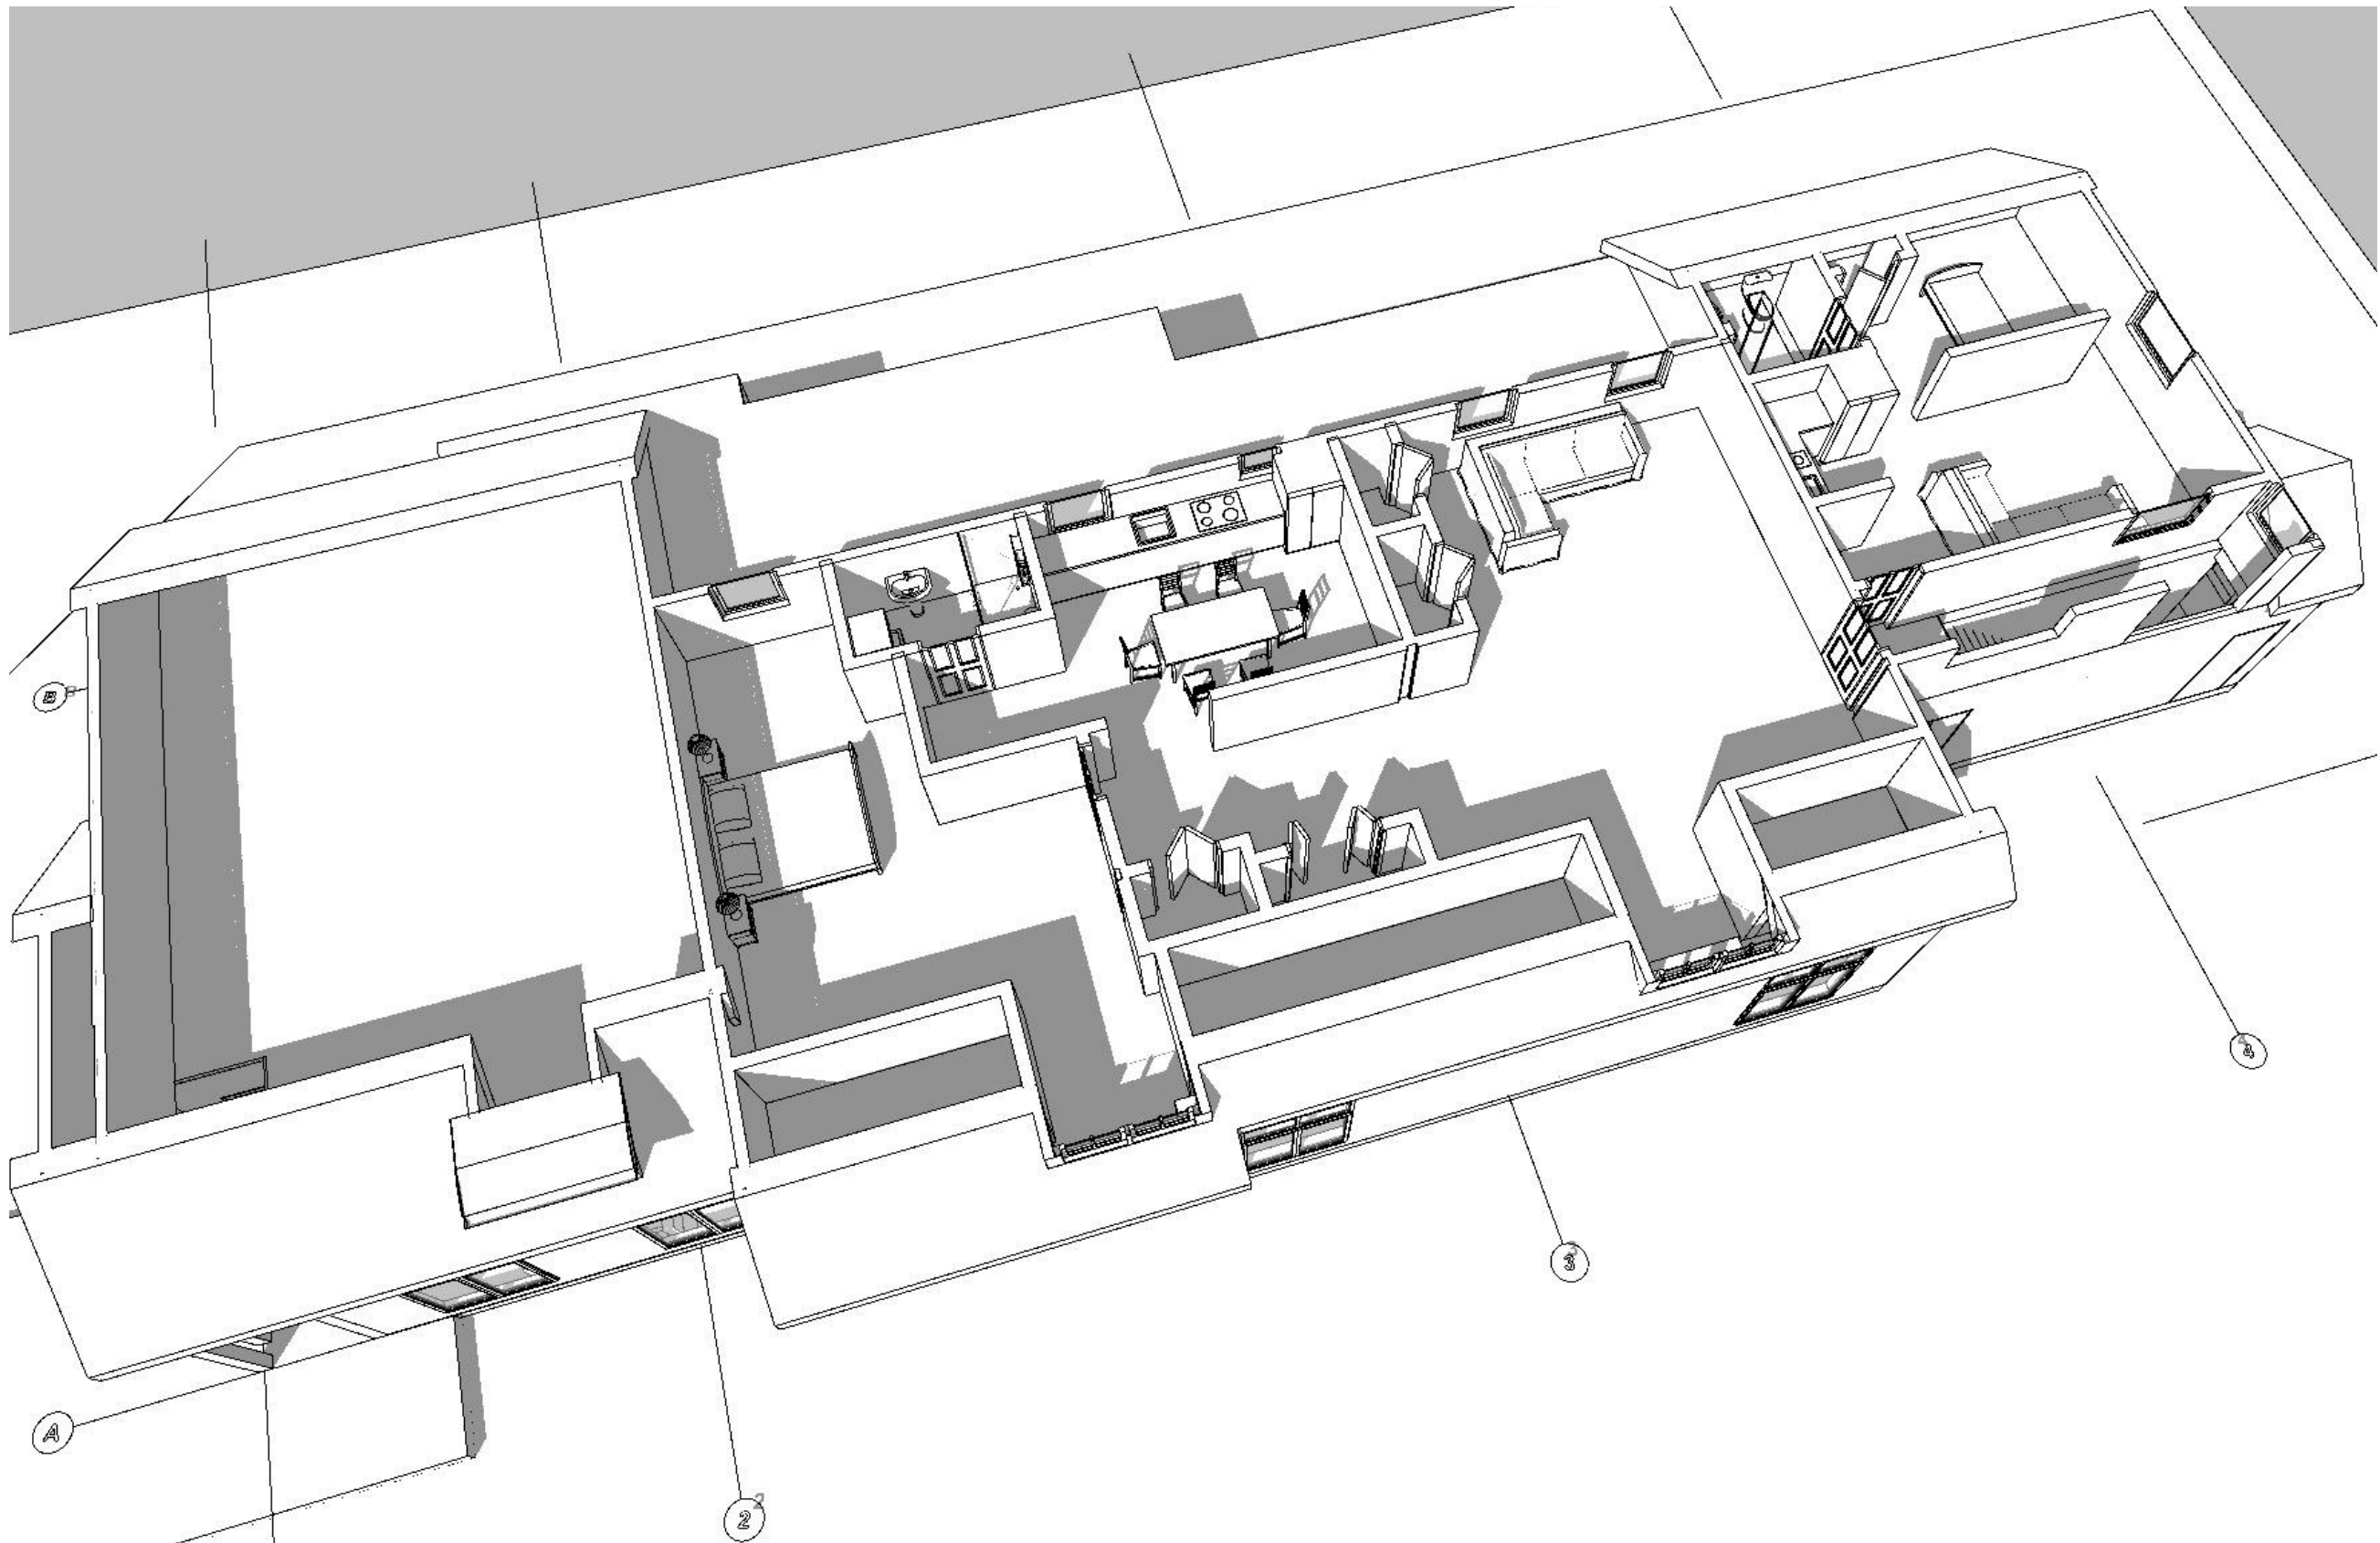

Generic Perspective /UPPER

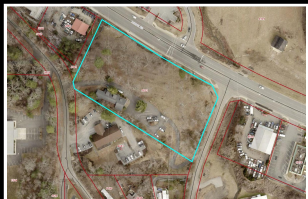

PROJECT LOCATION MAP


GENERAL NOTES:
1. DO NOT USE AS A BLUEPRINTS WITHOUT MR LLC PERMISSION.
2. PLEASE NOTE INTERIOR DIMENSIONS WERE NOT USED IN CALCULATING SQUARE FOOTAGE.
3. SIZE OF HEATED AND NOT HEATED AREA AND OTHER INFORMATION WERE OBTAINED PER THE NC REAL ESTATE COMMISSION GUIDELINES (6' FOR EXTERNAL WALLS EXCEPT CONDOMINIUMS).
4. FOR REMODELING QUESTIONS OR MORE DETAILED CAD DRAWINGS (INC.SITE PLAN, SECTIONS, ELEVATIONS) ALSO 3D MODEL PLEASE CONTACT ALFRED ZALYS
MOB. 828 231 7305 E-MAIL: A.ZALYS@HOTMAIL.COM
5. THE FURNITURE SHOWN IS FOR ILLUSTRATIVE PURPOSES ONLY, INTENDED TO ENHANCE MARKETING VISUALS AND BETTER UNDERSTAND SPACE DESIGN

Client:

#Client E-mail
#Client Phone Number

LEGEND MAP:
HEATED COMMERC. FINISHED
HEATED RESIDENTIAL FINISHED
NOT HEATED/NOT FINISHED
COVERED PORCH
OPEN DECK

Revision History

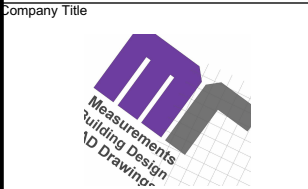

Company
Measure Rite LLC
103 Poplar Spring Trl. Hendersonville
Henderson County 28739

Site Address
**1275 Tunnel Rd, Asheville, NC
28805 Animal Hospital East**

Drawing Name
Generic Perspective /UPPER

Drawing Status
AS BUILT

Contact Name Alfred ZALYS mob. 828 231 7305	Job Nr. MR 1207 Date 7/20/2025 Layouts Total 4 Paper Size ANSI B
Drawing Scale 1/8" = 1'-0"	
Layout Nr. 1	
Layout ID AS BUILT-4	Revision