

5610 SOUTHWEST FREEWAY SUITE C  
5610 SOUTHWEST FREEWAY, SUITE C  
HOUSTON, TEXAS 77057


|  |  |
|--|--|
|  |  |
|  |  |
| VISA  |              |
|-------|--------------|
| DATE: | DESCRIPTION: |
|       |              |
|       |              |
|       |              |
|       |              |

DATE: 10/20/2020  
DRAWN BY: C.R.  
CHECKED BY: A.V.  
PROJECT: A.V.  
C NO:

AS-BUILT  
FLOOR PLAN

AB-2

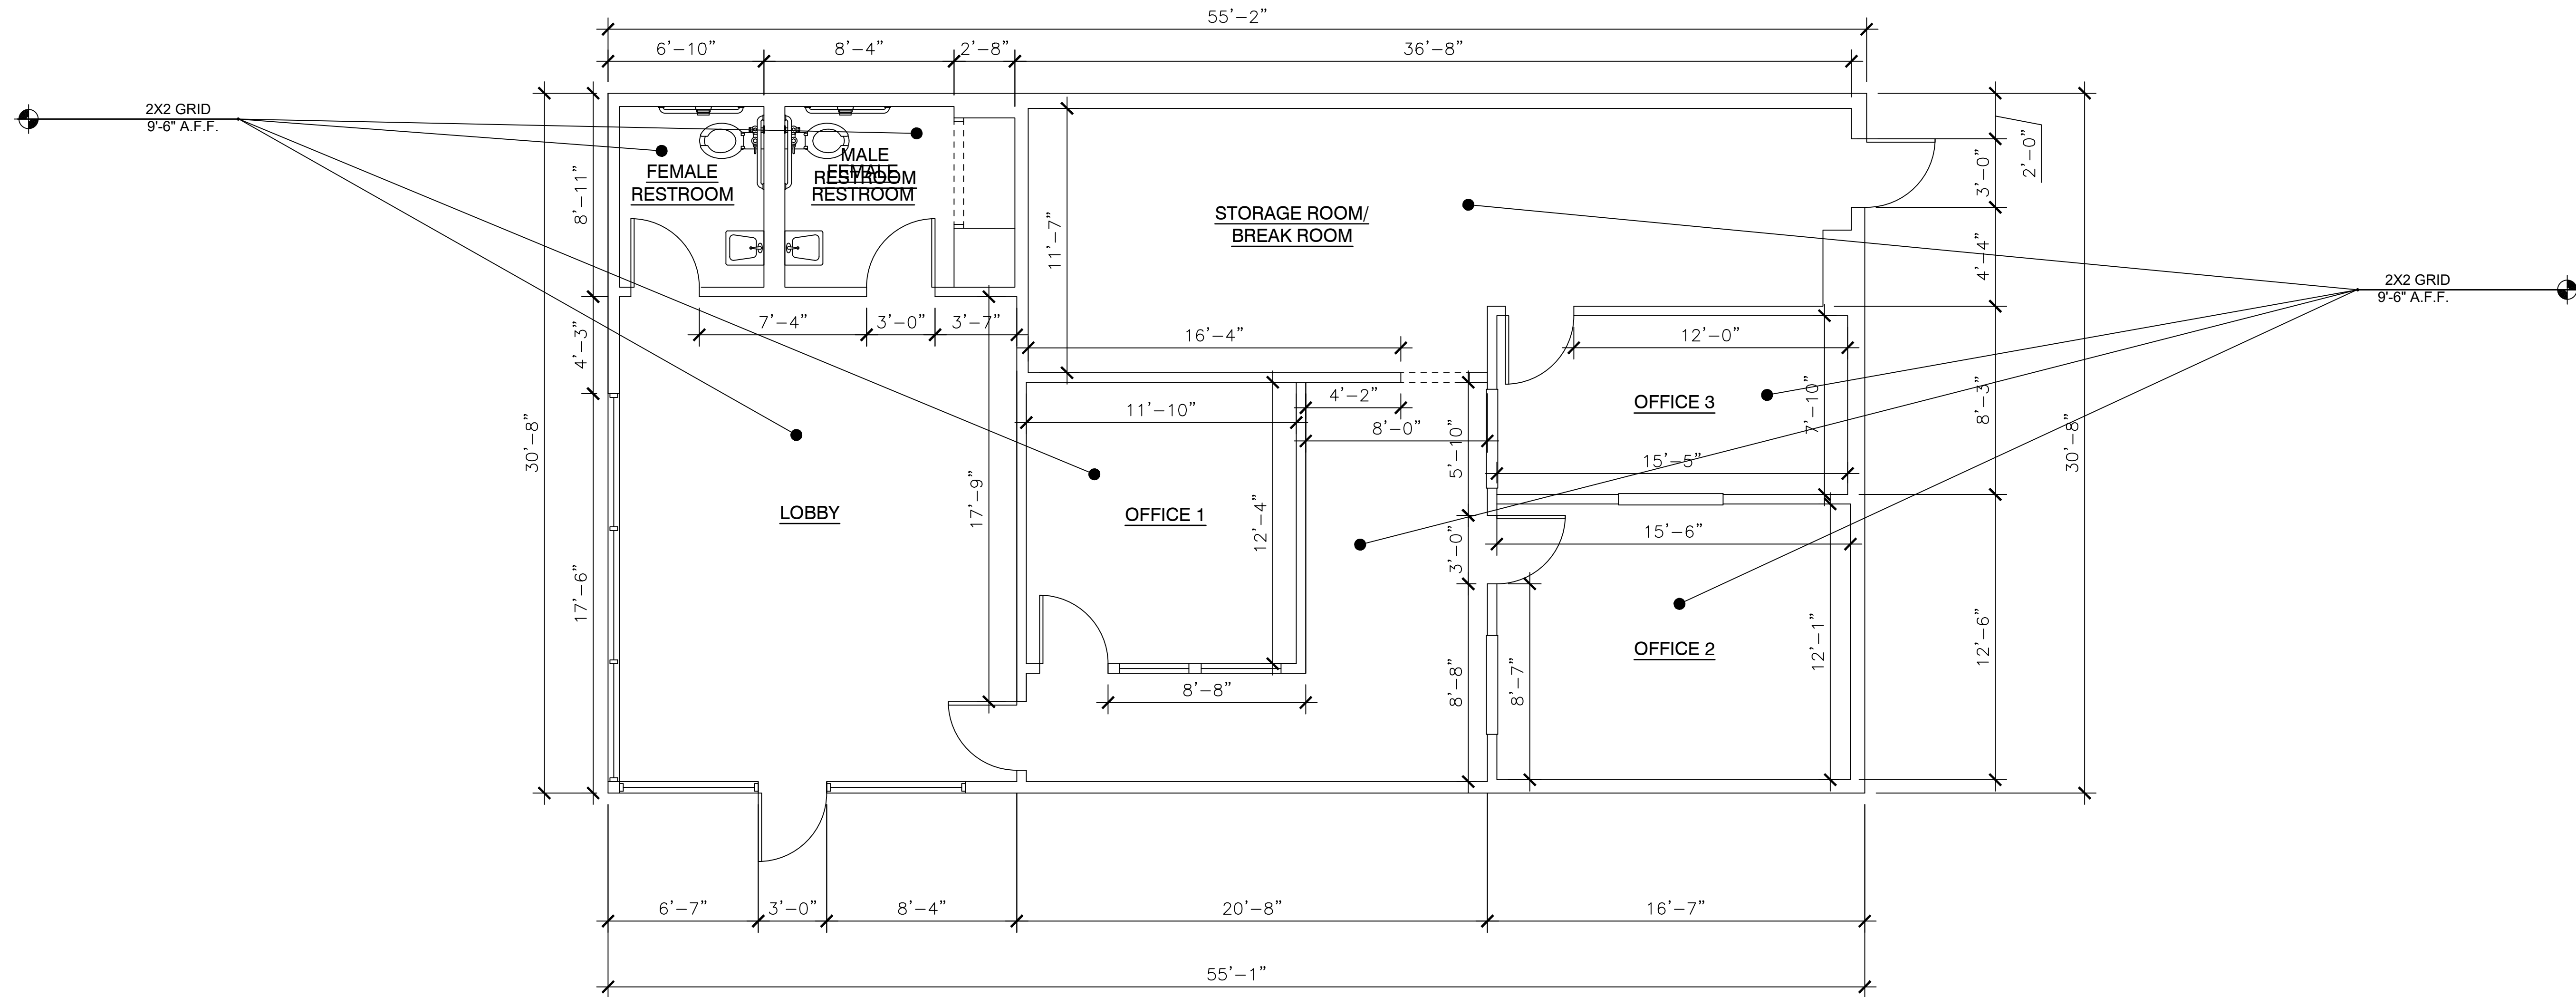

NOTES:  
SUITE D HAS 1,680 SQFT