



**WILDFLOWER**  
DESIGN STUDIO

© 2021 COPYRIGHT WILDFLOWER DESIGN STUDIO PC  
THIS DRAWING IS AN INSTRUMENT OF SERVICE UNIQUE  
TO THIS PROJECT. IT IS NOT TO BE REUSED OR  
REPRODUCED IN WHOLE OR IN PART WITHOUT  
WRITTEN PERMISSION FROM THE ARCHITECT.

**NOT FOR  
CONSTRUCTION**

NOTE: AS WITH ALL EXISTING  
BUILDINGS, THERE WILL BE MINOR  
DISCREPANCIES IN DIMENSIONS  
AND OTHER TOLERANCES TO  
ACCOUNT FOR MINOR  
IMPERFECTIONS  
AND CONSTRUCTION VARIATIONS.

No.	Description	Date
A	OWNER REVIEW	21 NOV 2025

TRIBE


**AS-BUILT PLANS  
FOR 127 W. ANTRIM  
FLOOR PLANS**

Project number	25-039
Date	21 NOV 2025
Drawn by	JAB
Checked by	JAB


**A1.1**

Scale 3/16" = 1'-0"

11/24/2025 10:06:01 AM

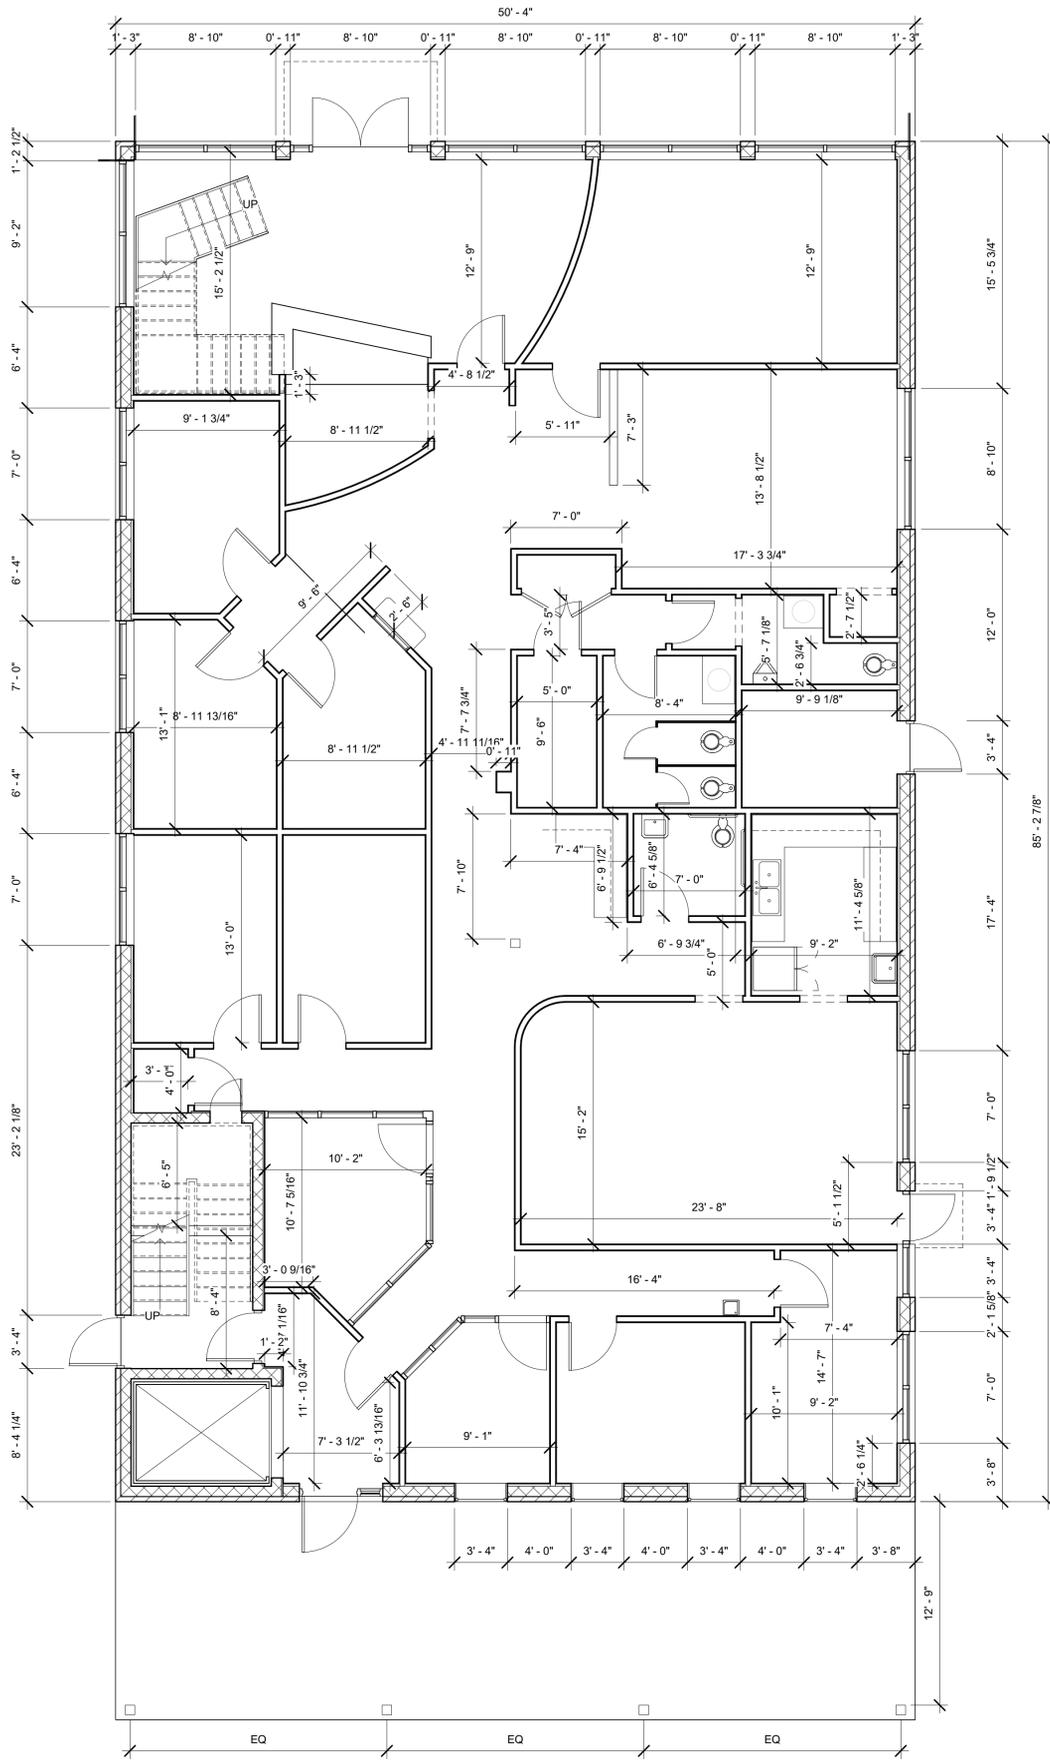

① Level 1  
3/16" = 1'-0"

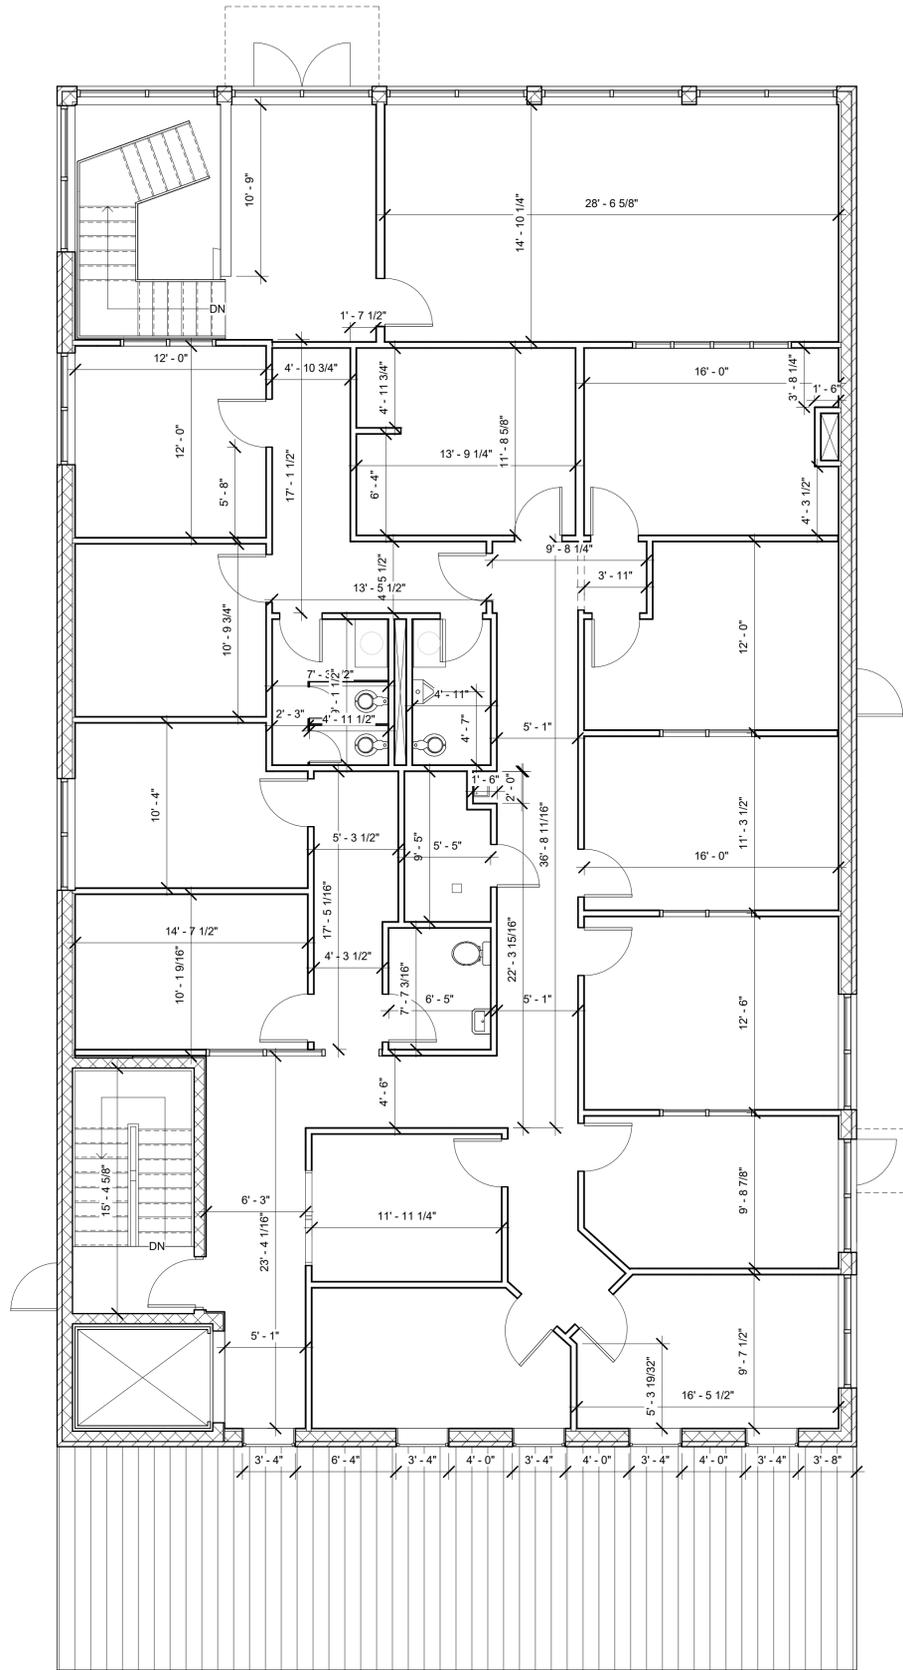

② Level 2  
3/16" = 1'-0"