

WINDOW SCHEDULE

<divHANDBRAIL NOTE:

AS DESCRIBED IN SEC. 1015.1 AND 1026.4.1, HANDRAILS SHALL FORM A VERTICAL PROTECTIVE BARRIER NOT LESS THAN 42 INCHES HIGH. OPEN HANDRAILS SHALL HAVE INTERMEDIATE RAILS SUCH THAT A 4-INCH DIA. SPHERE CANNOT PASS THROUGH AND A BOTTOM RAIL THAT REJECTS THE PASSAGE OF A 2-INCH SPHERE. CONSTRUCTION SHALL MEET THE REQUIREMENTS AS DESCRIBED IN SEC. 1608.2.

PLAN REVIEW NOTE:

OWNER AND/OR CONTRACTOR IS RESPONSIBLE TO REVIEW THE PERMITTED SET OF PLANS TO BE AWARE OF ANY CHANGES REQUIRED BY MONROE COUNTY THAT WERE MADE TO THE PLANS AFTER THEY WERE SUBMITTED.

WIND LOAD NOTE:

I HEREBY CERTIFY THAT THIS STRUCTURE IS
DESIGNED FOR A SUSTAINED WIND OF 134 M.P.H. AND
A PEAK WIND GUST FOR 3 SECONDS UP TO 150 M.P.H.
AS REQUIRED BY MONROE COUNTY.
THE DESIGN CRITERIA IS BASED ON ASCE 7-97, AND
TRUSSES, IF REQUIRED WILL BE DESIGNED THE SAME.

DOOR SCHEDULE

DOOR SCHEDULE						
MARK	UNIT DIMENSION		STOCK #	TYPE	MANUFACTURER	REMARKS
	WIDTH	HEIGHT				
A	3'-0"	6'-8"	OWNER	STEEL	OWNER	1 HR. FIRE RATED
B	2'-8"	6'-8"	OWNER	SOLID CORE	OWNER	FLUSH
C	4'-0"	6'-8"	OWNER	BI-FOLD	OWNER	LOUVRED
D	2'-6"	6'-8"	OWNER	HOLLOW CORE	OWNER	FLUSH

FIRST FLOOR PLAN

$$1/4'' = 1' - 0''$$

BLUE WATER ENGINEERING AND DESIGN, INC.
ISLAND COMMUNITY CHURCH, INC.


DATE
12-1-92
SCALE
1/4"=1'-0"
DRAWN BY
C.DAUBRESSE
JOB NUMBER
ICC-A1
SHEET OR
DRAWING NO.
A-1
R

DESIGNER HEREBY EXPRESSLY RESERVES HIS COMMON LAW COPYRIGHT AND OTHER PROPERTY RIGHTS IN THESE PLANS. THESE PLANS AND DRAWINGS ARE NOT TO BE REPRODUCED, CHANGED OR COPIED IN ANY FORM OR MANNER WHATSOEVER WITHOUT FIRST OBTAINING THE EXPRESS WRITTEN PERMISSION OF BLUEWATER ENGINEERING AND DESIGN, INC. NOR MAY THEY BE ASSIGNED TO ANY THIRD PARTY WITHOUT FIRST OBTAINING WRITTEN PERMISSION AND CONSENT.

WAYNE M. GRIERSON, P.E., CERTIFICATION NO. 22476
TO WHOM EVER PERTAIN: WITHOUT FIRST OBTAINING SAID WRITTEN PERMISSION AND CONSENT

also M.G
4/12/02

APPROVED FLOOR PLANS
6429 Sq. Ft. Building Area
Bedrooms
O.S.T.D.S. Permit No: ME 92-9
Approved by Melissa A. Elliott
Date 1-7-00
DOH - Meares County Health Department

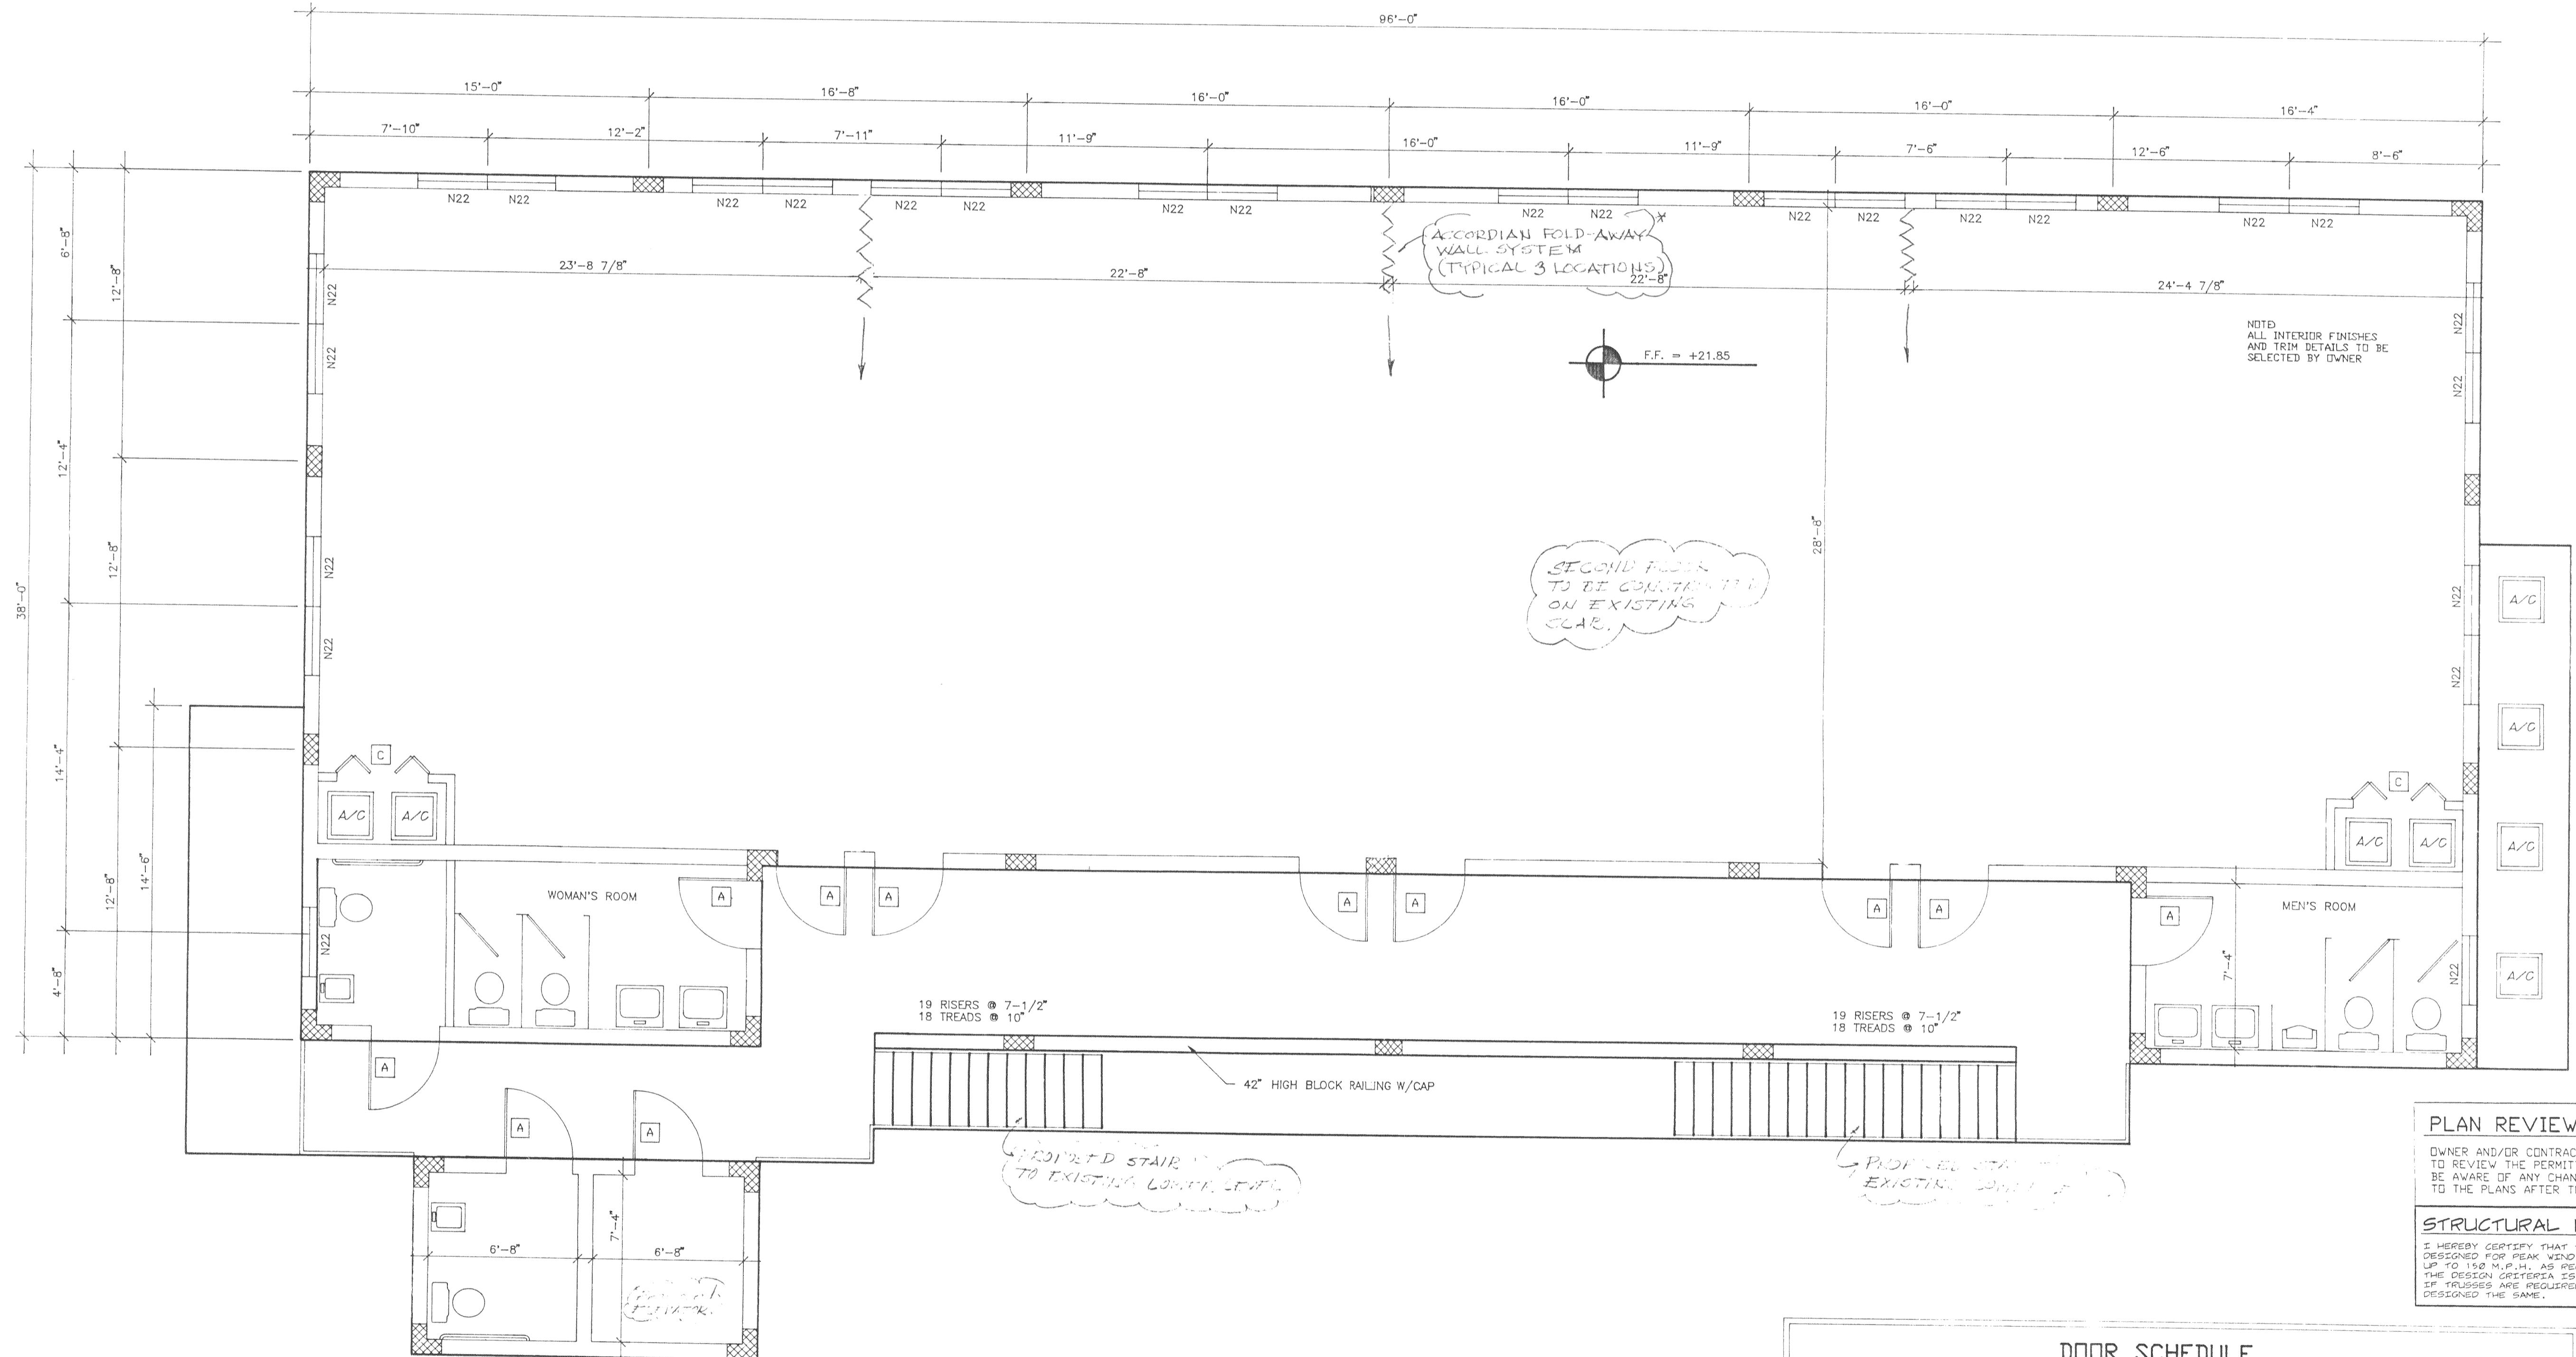

WINDOW SCHEDULE

PROPOSED
SECOND FLOOR PLAN

DOOR SCHEDULE

MARK	UNIT DIMENSION		STOCK #	TYPE	MANUFACTURER	REMARKS
	WIDTH	HEIGHT				
A	3'-0"	6'-8"	OWNER	STEEL	OWNER	1 HR. FIRE RATED
C	4'-0"	6'-8"	OWNER	BI-FOLD	OWNER	LOUVRED

TO REVIEW THE PERMITTED SET OF PLANS TO
BE AWARE OF ANY CHANGES THAT WERE MADE
TO THE PLANS AFTER THEY WERE SUBMITTED.

OWNER AND/OR CONTRACTOR IS RESPONSIBLE
TO REVIEW THE PERMITTED SET OF PLANS TO
BE AWARE OF ANY CHANGES THAT WERE MADE
TO THE PLANS AFTER THEY WERE SUBMITTED.

DESIGNER HEREBY EXPRESSLY RESERVES HIS COMMON LAW COPYRIGHT AND OTHER PROPERTY RIGHTS IN THESE PLANS. THESE PLANS AND DRAWINGS ARE NOT TO BE REPRODUCED, CHANGED OR COPIED IN ANY FORM OR MANNER WHATSOEVER WITHOUT FIRST OBTAINING THE EXPRESS WRITTEN PERMISSION OF BLUE WATER ENGINEERING AND DESIGN, INC. NOR ARE THEY TO BE ASSIGNED TO ANY THIRD PARTY WITHOUT OBTAINING THE WRITTEN PERMISSION OF THE DESIGNER. WAYNE M. GREERSON, P.E., CERTIFICATION NO. 22476
Date: N.Y. 1/13/98

Wayne M. Grierson 12/3/99
WAYNE M. GRIERSON, P.E., CERTIFICATION NO. 22476

DATE
12-1-92
SCALE
1/4"=1'-0"
DRAWN BY
GDAUBRESSE
JOB NUMBER
ICC-A1
SHEET OR
DRAWING NO.
A-2

REVISION	BY
2ND FLR	JTV
4/16/01	
ADD LIFT	JTV
4/09/02	

(305) 852-4245

BLUE WATER ENGINEERING AND DESIGN, INC.
ISLAND COMMUNITY CHURCH, INC.

DATE	12-1-92
SCALE	1/4"=1'-0"
DRAWN BY	C. DAUBRESE
JOB NUMBER	ICC-A1
SHEET NO.	A-3
DRAWING NO.	



1/12/01

PLAN REVIEW NOTE:

OWNER AND/OR CONTRACTOR IS RESPONSIBLE TO REVIEW THE PERMITTED SET OF PLANS TO BE AWARE OF ANY CHANGES REQUIRED BY MONROE COUNTY THAT WERE MADE TO THE PLANS AFTER THEY WERE SUBMITTED.

WIND LOAD NOTE:

I HEREBY CERTIFY THAT THIS STRUCTURE IS DESIGNED FOR A SUSTAINED WIND OF 134 M.P.H. AND A PEAK WIND GUST FOR 3 SECONDS UP TO 152 M.P.H. AS REQUIRED BY MONROE COUNTY. THE DESIGN CRITERIA IS BASED ON ASCE 7-97, AND TRUSSES, IF REQUIRED WILL BE DESIGNED THE SAME.

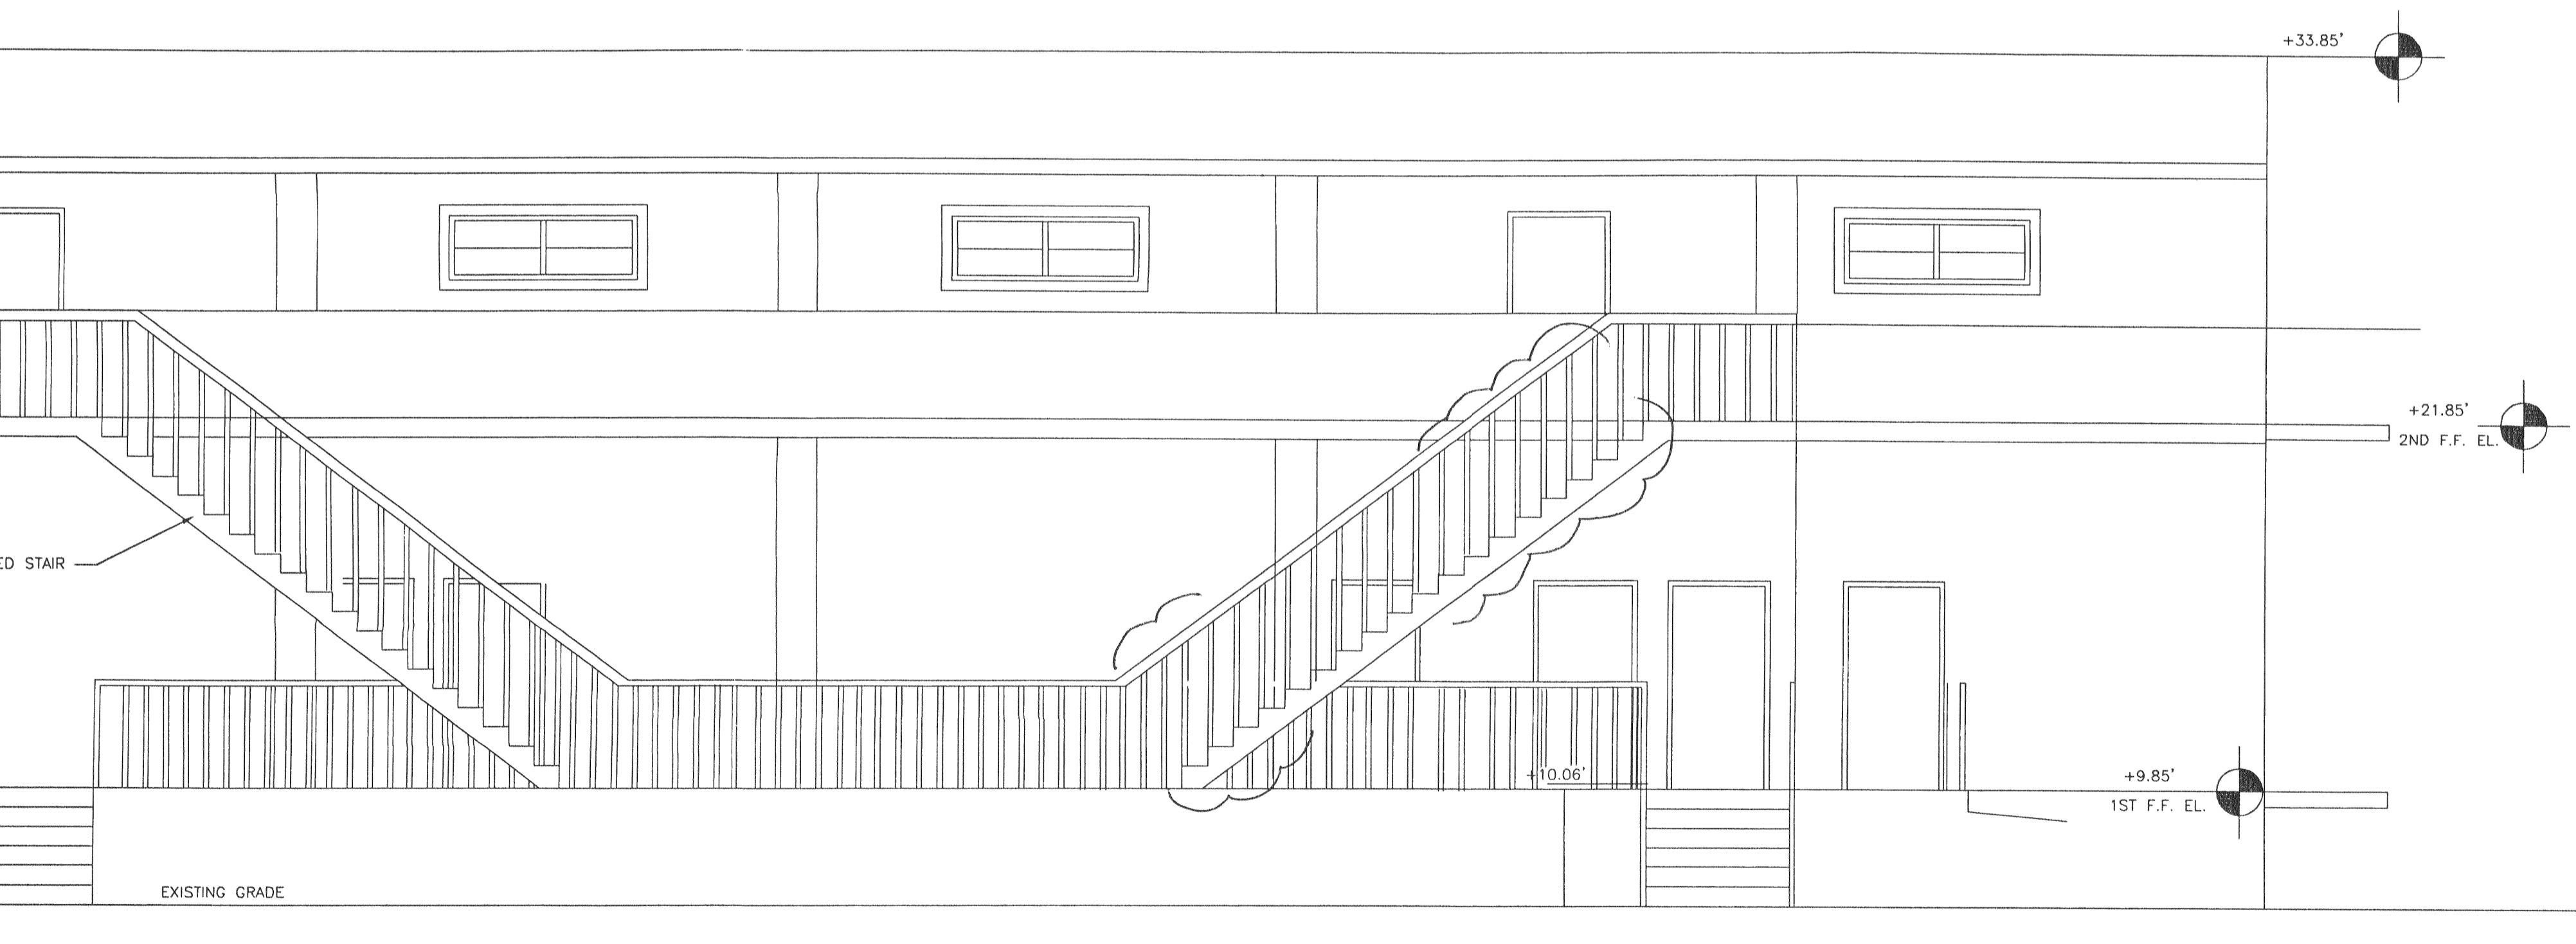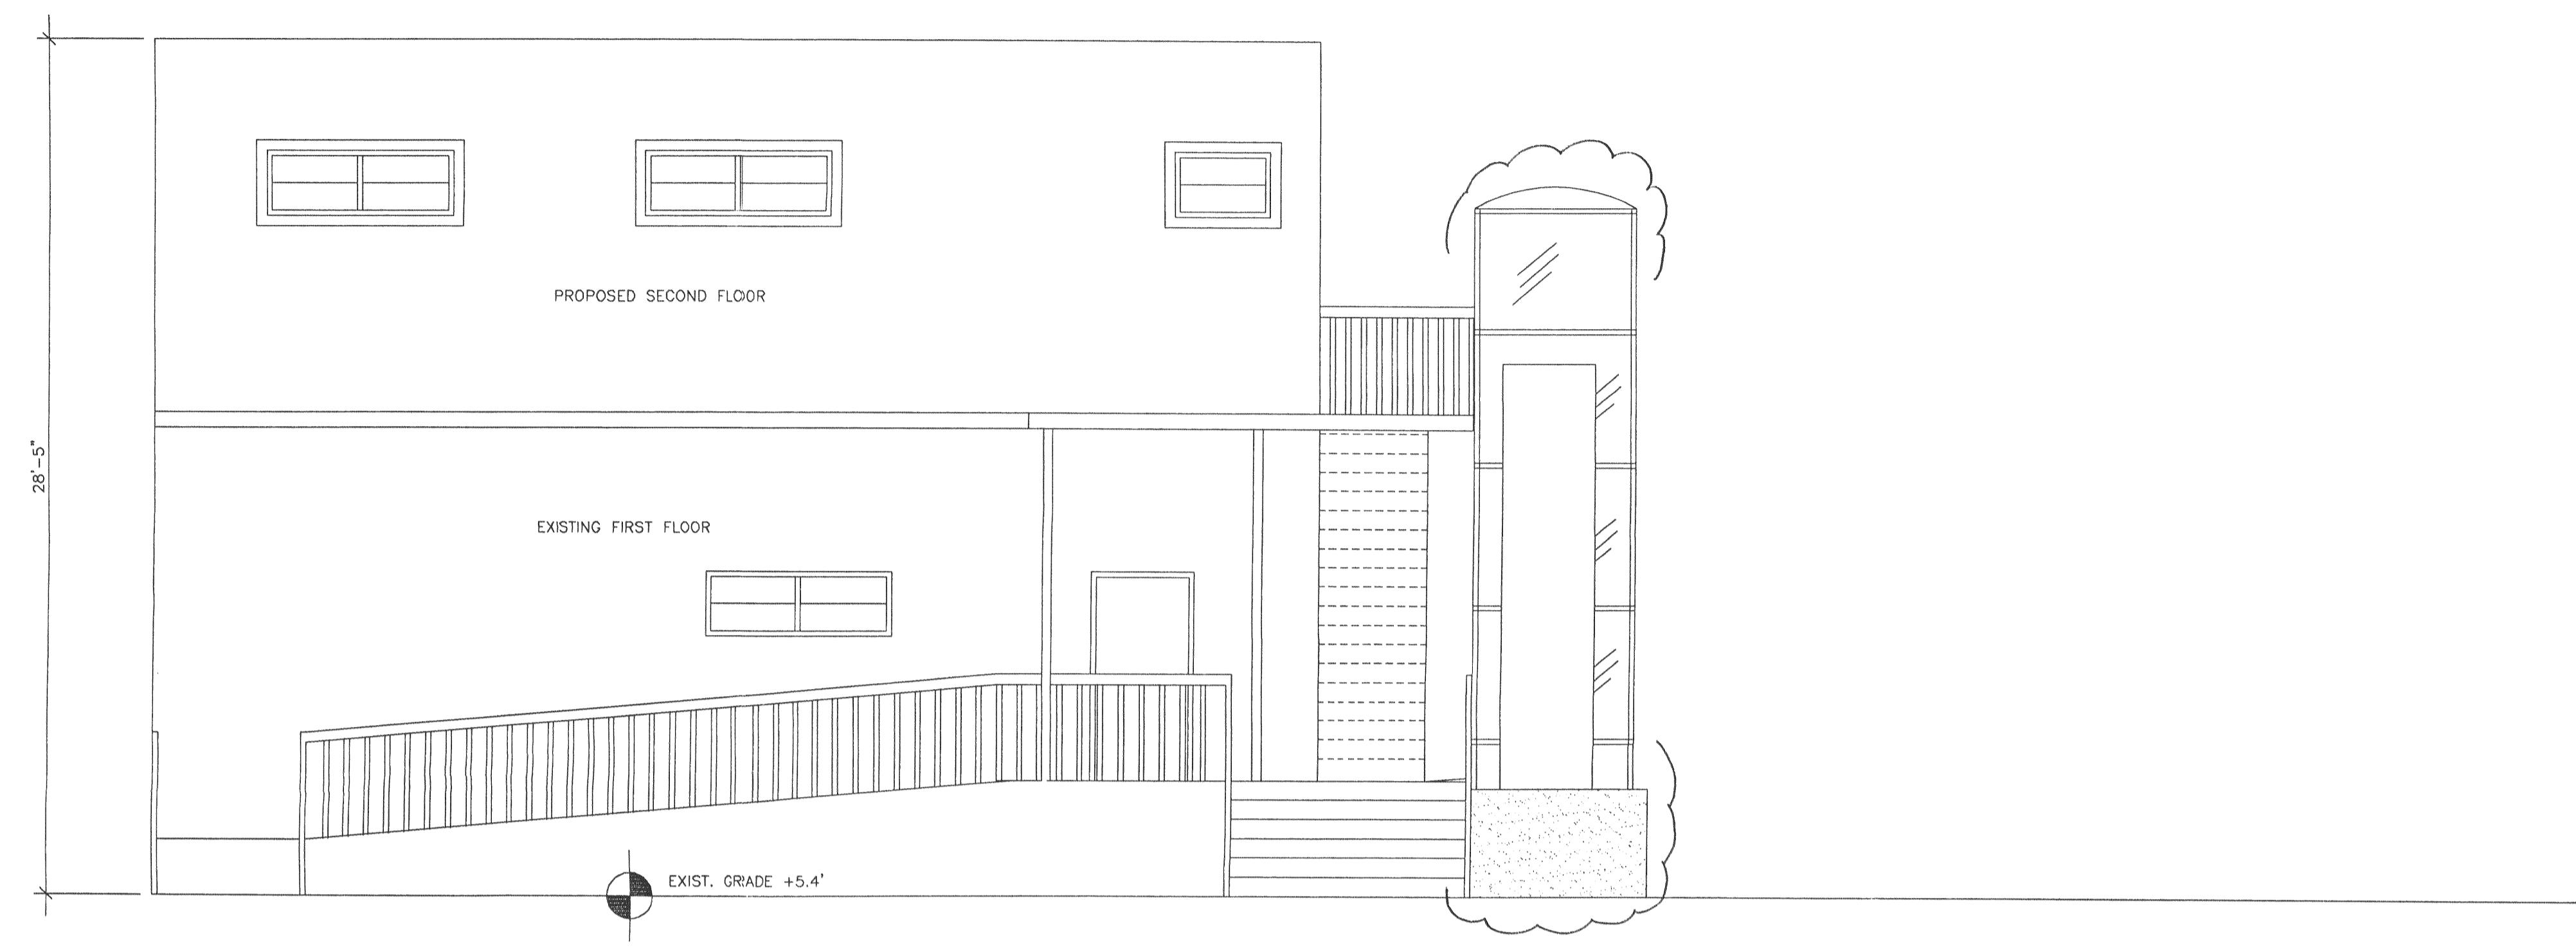

WAYNE M. GRIERSON, P.E., CERTIFICATION NO. 22476

1/12/01