


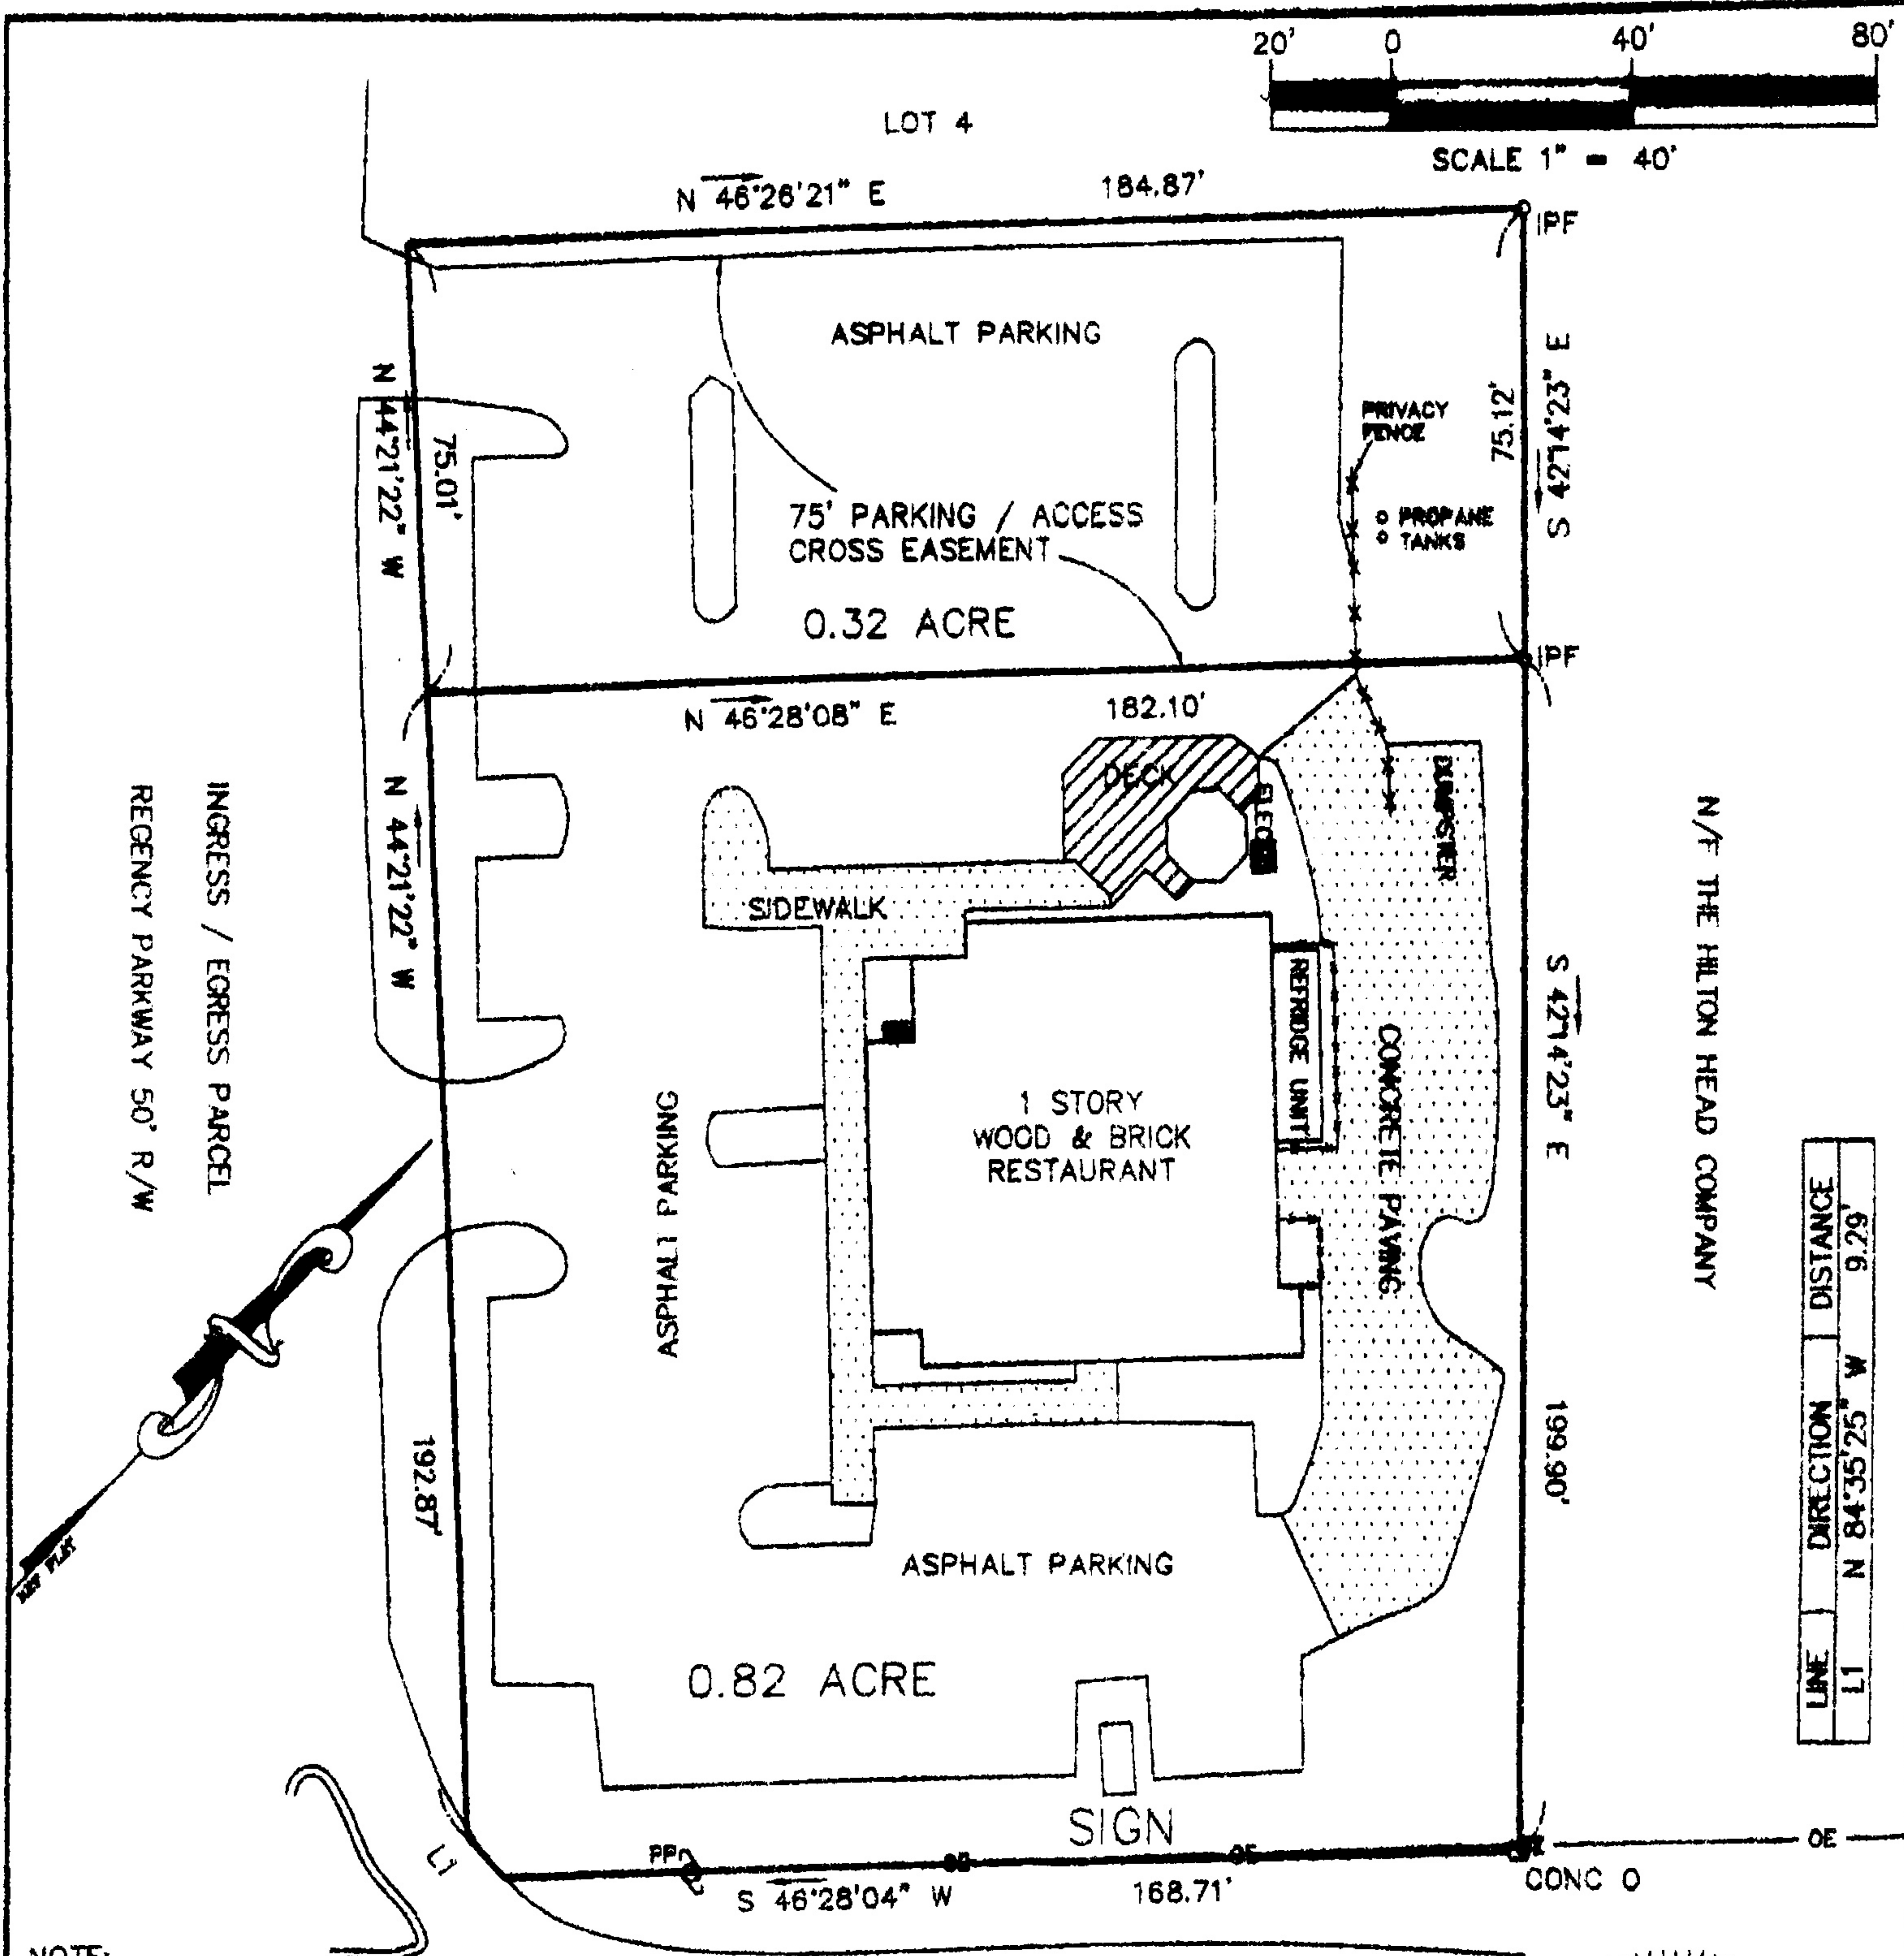

LINE	DIRECTION	DISTANCE
11	N 84°35'25"	62.6
	W	52.9

NOTE:

1) TAX ID# DIST-MAP-PAR 520-11-154

REFERENCE:

REGENCY PARK, A SECT. OF LONG COVE COMMERCIAL S/D

PLAT BOOK 32, PG. 221, DATED 5/21/84

IPS ● IRON PIN SET

IPF ○ IRON PIN FOUND

CONC. O. ■ CONCRETE MONUMENT FOUND

CONC. N. ■ CONCRETE MONUMENT SET

TEL ○ TELEPHONE BOX

SBL SETBACK LINE

S/D SUBDIVISION

PPC POWER POLE

WOOD DECK

OE OVERHEAD ELECTRIC LINE

CONCRETE PAVING

EP EDGE OF PAVEMENT

BRICK/TILE/PAVERS

GV GAS VALVE

POL POINT ON LINE

ESMT EASEMENT

SY SERVICE YARD


ELEC ELECTRIC TRANSFORMER

X FENCE

TV CABLE TV BOX

WV WATER VALVE

FH FIRE HYDRANT

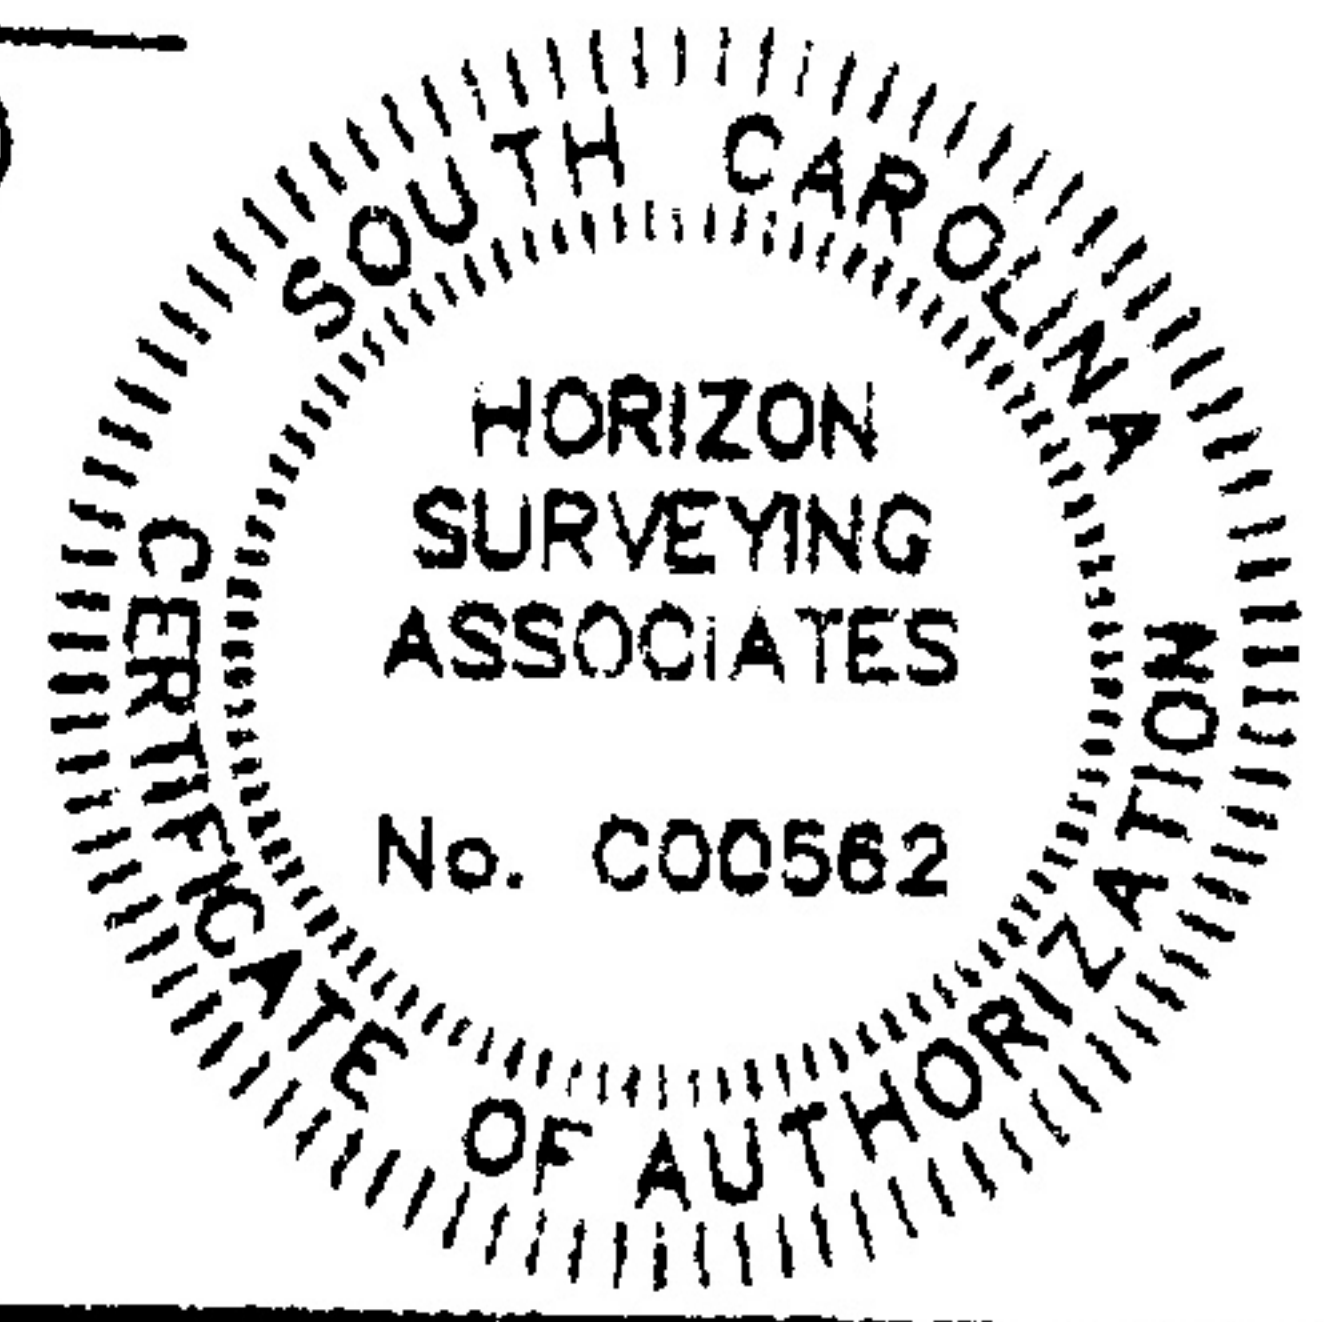

OCTOBER 19, 2005

ASBUILT SURVEY OF:

LOT 2 (#2 REGENCY PARKWAY)

REGENCY PARK, A SECTION OF LONG COVE COMMERCIAL S/D

HILTON HEAD ISLAND

PERIMETER SKETCH

