

**AS BUILT-1** **Main Level** **1/8" = 1'-0"**

Sheet Index		
AS Built Drawings		
AS BUILT-1	0. Main Level	
AS BUILT-2	1. Upper Level	
AS BUILT-3	Generic View / MAIN	
AS BUILT-4	Generic View / UPPER	

**Sheet Index**

Building Area Schedule			
Home Story	Floor Area	Type	Area
Lower Level			
	1. MECH.-STORAGE N/F	Internal Not Heated/Finished	451.04
Main Level			
	1. HEATED MAIN	Internal Heated Zone	1,210.00
	2. FRONT PORCH	External / Covered	330.00
	3. PORCH	External / Covered	240.00
Upper Level			
	1. HEATED UPPER	Internal Heated Zone	1,284.38
	2. OPEN DECK	External Zone/Open Deck	82.55
	3. PORCH	External / Covered	157.45
			<b>3,755.42 ft²</b>

**Building Area Schedule**




**General Notes:**

- DO NOT USE AS A BLUEPRINTS WITHOUT MR LLC PERMISSION.
- PLEASE NOTE INTERIOR DIMENSIONS WERE NOT USED IN CALCULATING SQUARE FOOTAGE
- SIZE OF HEATED AND NOT HEATED AREA AND OTHER INFORMATION WERE OBTAINED PER THE NC REAL ESTATE COMMISSION GUIDELINES ( 6" FOR EXTERNAL WALLS EXCEPT CONDOMINIUMS)
- FOR REMODELING QUESTIONS OR MORE DETAILED CAD DRAWINGS (INC.SITE PLAN, SECTIONS, ELEVATIONS) ALSO 3D MODEL PLEASE CONTACT **ALFRED ZALYS** MOB. 828 231 7305 E-MAIL: A.ZALYS@HOTMAIL.COM

**LEGEND MAP:**

- HEATED COMMERC. FINISHED
- HEATED RESIDENTIAL FINISHED
- NOT HEATED/NOT FINISHED
- COVERED PORCH
- OPEN DECK

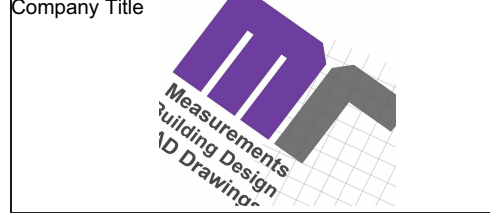

**Company Title**  
**Measure Rite LLC**  
 103 Poplar Spring Trl. Hendersonville  
 Henderson County 28739

**Site Address**  
**141 Merrimon Ave, Asheville,**  
**NC 28801**

**Drawing Name**  
**Main Level, Building Area**  
**Schedule, Sheet Index**

**Client:**

**#Client Phone Number**

**Drawing Status**  
**AS BUILT**

Contact Name <b>Alfred ZALYS</b> mob. 828 231 7305	Job Nr. <b>MR 1136</b> Date <b>9/16/2024</b>
--	---

Drawing Scale 1/8" = 1'-0", 1:1.63, 1:1.25	Layouts Total <b>4</b>
---	---------------------------

Layout Nr. <b>1</b>	Paper Size <b>ANSI B</b>
------------------------	-----------------------------

Layout ID **AS BUILT-1** Revision




**General Notes:**

- DO NOT USE AS A BLUEPRINTS WITHOUT MR LLC PERMISSION.
- PLEASE NOTE INTERIOR DIMENSIONS WERE NOT USED IN CALCULATING SQUARE FOOTAGE
- SIZE OF HEATED AND NOT HEATED AREA AND OTHER INFORMATION WERE OBTAINED PER THE NC REAL ESTATE COMMISSION GUIDELINES ( 6" FOR EXTERNAL WALLS EXCEPT CONDOMINIUMS)
- FOR REMODELING QUESTIONS OR MORE DETAILED CAD DRAWINGS (INC.SITE PLAN, SECTIONS, ELEVATIONS) ALSO 3D MODEL PLEASE CONTACT **ALFRED ZALYS** MOB. 828 231 7305 E-MAIL: A.ZALYS@HOTMAIL.COM

**LEGEND MAP:**

- HEATED COMMERC. FINISHED
- HEATED RESIDENTIAL FINISHED
- NOT HEATED/NOT FINISHED
- COVERED PORCH
- OPEN DECK

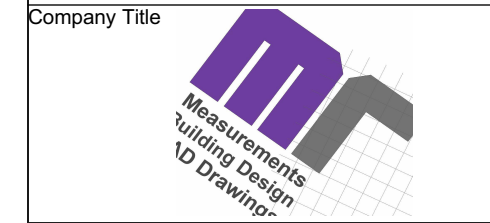

**Company**  
**Measure Rite LLC**  
 103 Poplar Spring Trl. Hendersonville  
 Henderson County 28739

**Site Address**  
**141 Merrimon Ave, Asheville,  
 NC 28801**

**Drawing Name**  
**Upper Level, Building Area  
 Schedule, Sheet Index**

**Client:**  
**#Client Phone Number**

**Drawing Status**  
**AS BUILT**

**Contact Name**  
**Alfred ZALYS**  
 mob. 828 231 7305

**Job Nr.**  
**MR 1136**  
 Date  
**9/16/2024**

**Drawing Scale**  
 1/8" = 1'-0", 1:1.63, 1:1.25

**Layouts Total**  
**4**

**Layout Nr.**  
**2**

**Paper Size**  
**ANSI B**

**Layout ID**  
**AS BUILT-2**


**Revision**

Sheet Index		
<b>AS Built Drawings</b>		
AS BUILT-1	0. Main Level	
AS BUILT-2	1. Upper Level	
AS BUILT-3	Generic View / MAIN	
AS BUILT-4	Generic View / UPPER	


**Sheet Index**

Building Area Schedule			
Home Story	Floor Area	Type	Area
Lower Level			
	1. MECH.-STORAGE N/F	Internal Not Heated/Finished	451.04
Main Level			
	1. HEATED MAIN	Internal Heated Zone	1,210.00
	2. FRONT PORCH	External / Covered	330.00
	3. PORCH	External / Covered	240.00
Upper Level			
	1. HEATED UPPER	Internal Heated Zone	1,284.38
	2. OPEN DECK	External Zone/Open Deck	82.55
	3. PORCH	External / Covered	157.45
			<b>3,755.42 ft²</b>

**Building Area Schedule**

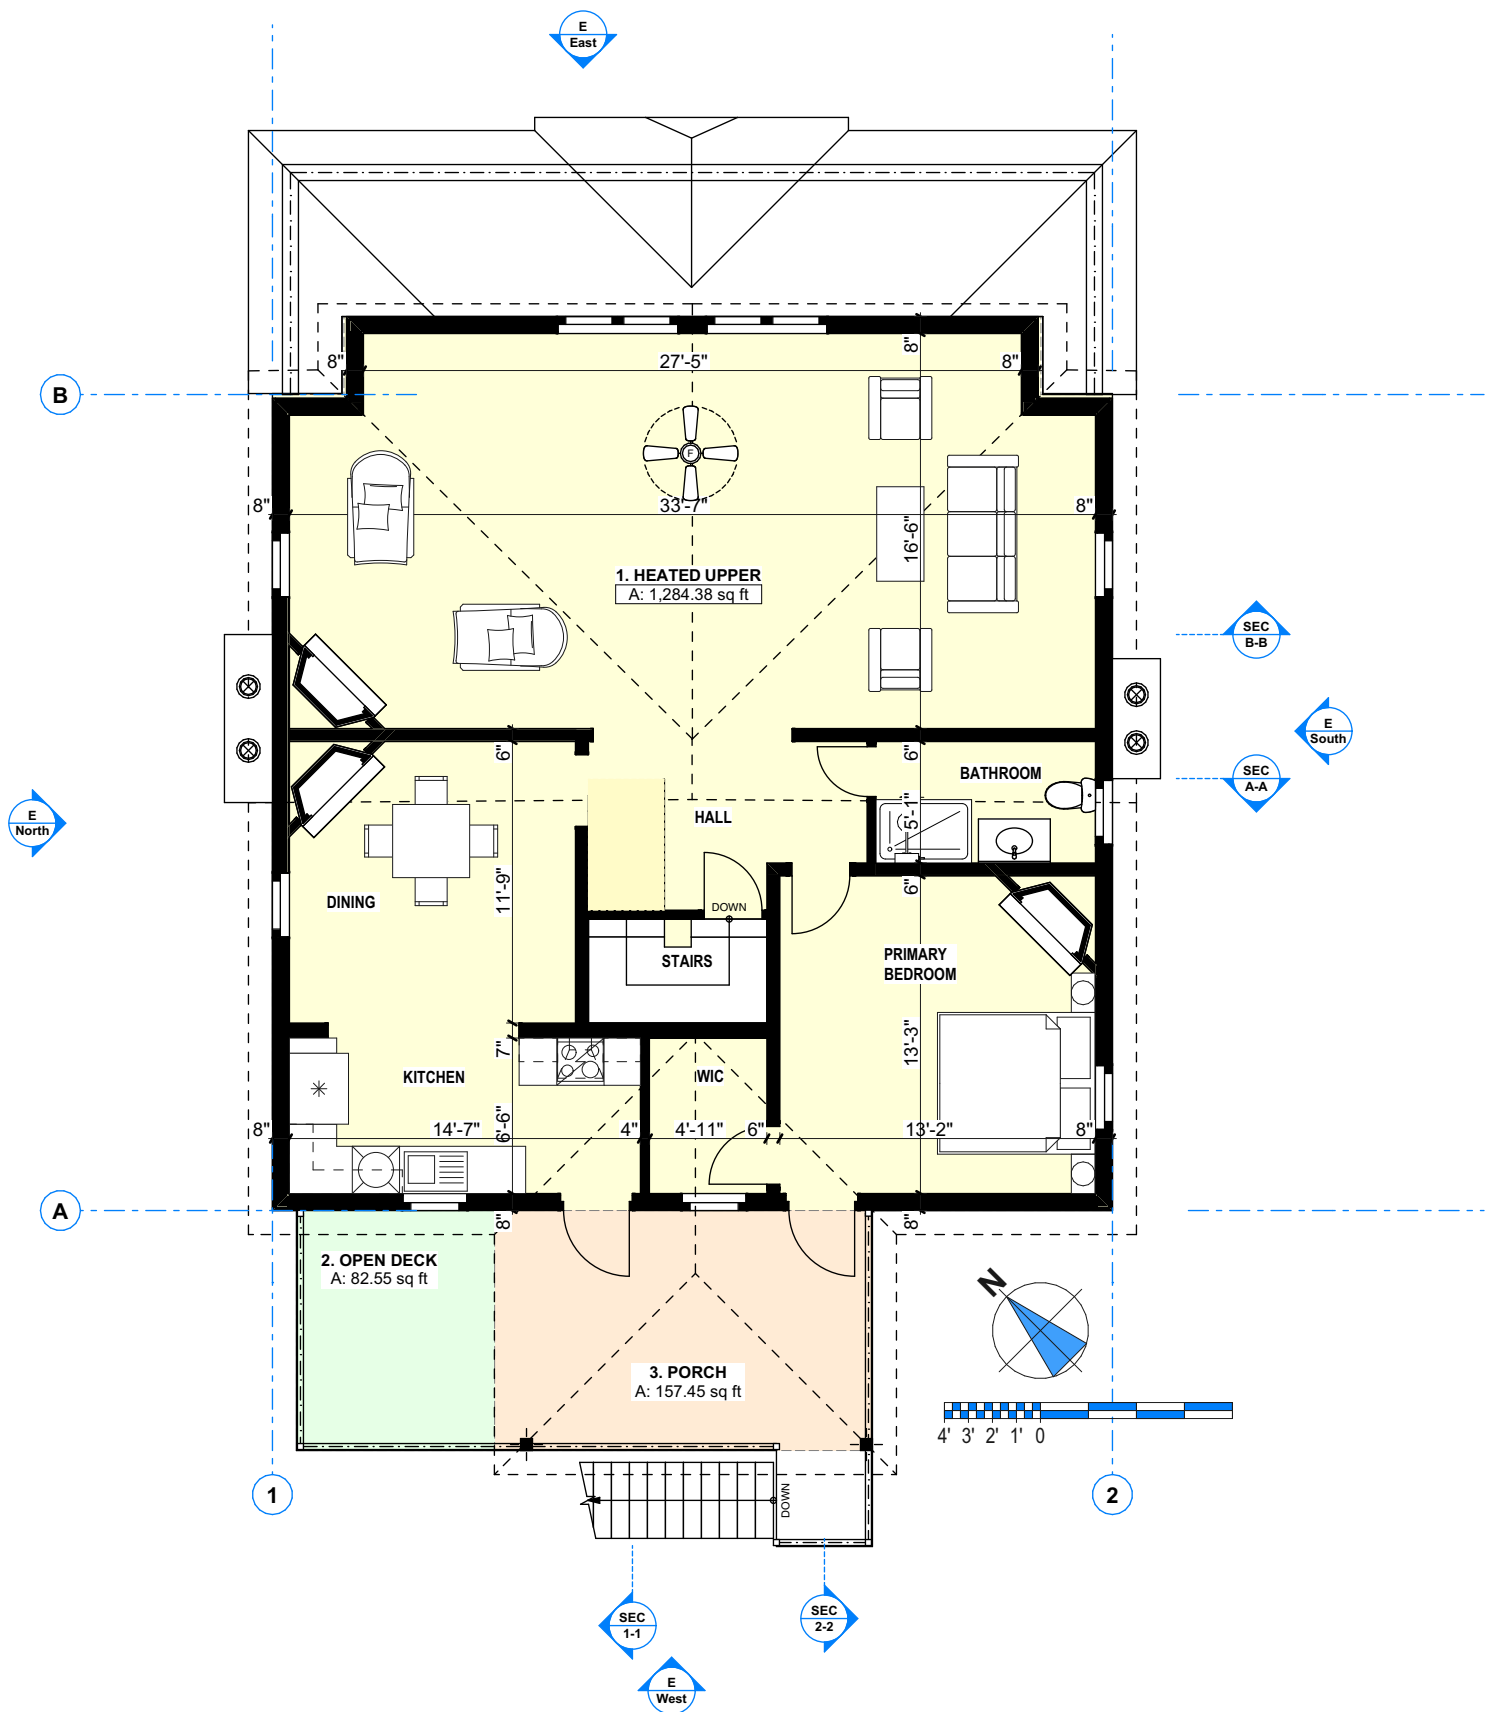

**AS BUILT-2** **Upper Level** **1/8" = 1'-0"**

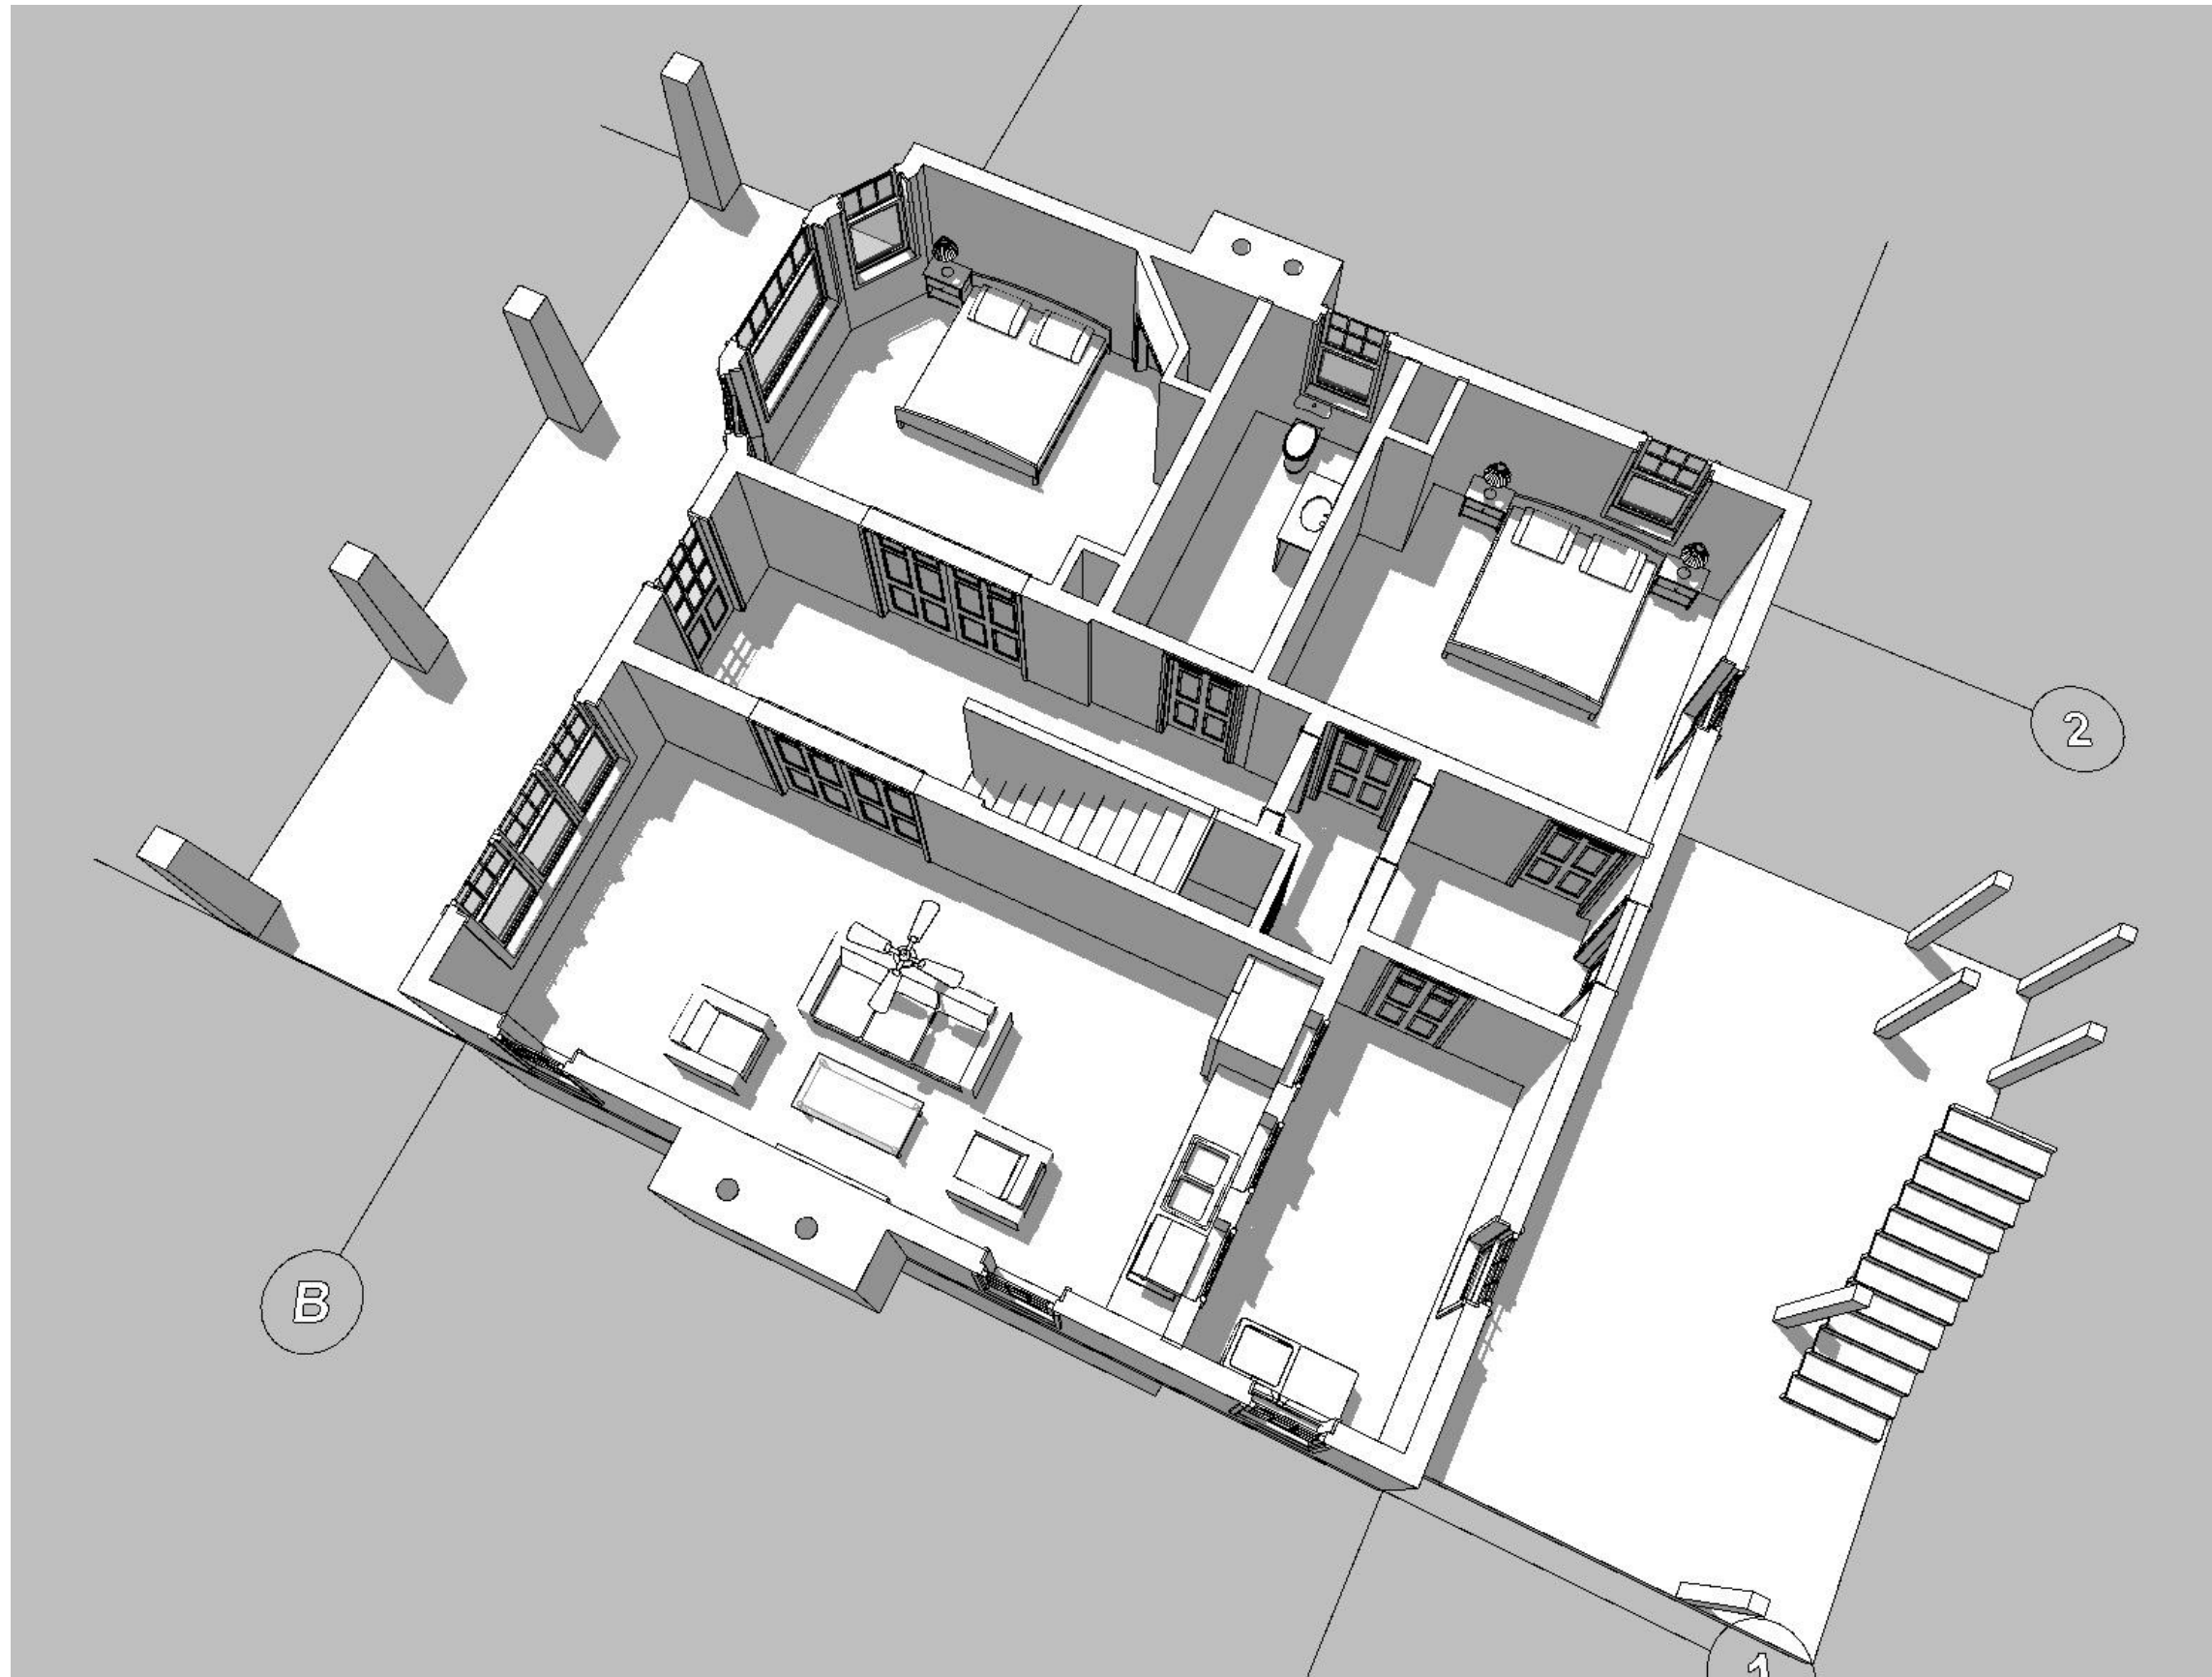

**Generic Perspective / MAIN**




**General Notes:**

1. DO NOT USE AS A BLUEPRINTS WITHOUT MR LLC PERMISSION.
2. PLEASE NOTE INTERIOR DIMENSIONS WERE NOT USED IN CALCULATING SQUARE FOOTAGE
3. SIZE OF HEATED AND NOT HEATED AREA AND OTHER INFORMATION WERE OBTAINED PER THE NC REAL ESTATE COMMISSION GUIDELINES ( 6" FOR EXTERNAL WALLS EXEPT CONDOMINIUMS)
4. FOR REMODELING QUESTIONS OR MORE DETAILED CAD DRAWINGS (INC.SITE PLAN, SECTIONS, ELEVATIONS) ALSO 3D MODEL PLEASE CONTACT **ALFRED ZALYS** MOB. 828 231 7305 E-MAIL: A.ZALYS@HOTMAIL.COM

**LEGEND MAP:**

	HEATED COMMERC. FINISHED
	HEATED RESIDENTIAL FINISHED
	NOT HEATED/NOT FINISHED
	COVERED PORCH
	OPEN DECK

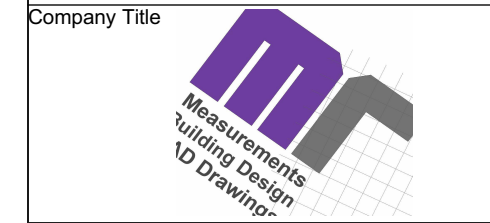

Company  
**Measure Rite LLC**  
 103 Poplar Spring Trl. Hendersonville  
 Henderson County 28739

Site Address  
**141 Merrimon Ave, Asheville,  
 NC 28801**

Drawing Name  
**Generic Perspective / MAIN**

Client:  
**#Client Phone Number**

Drawing Status  
**AS BUILT**


Contact Name <b>Alfred ZALYS</b> mob. 828 231 7305	Job Nr. <b>MR 1136</b> Date <b>9/16/2024</b>
--	---

Drawing Scale 1:174.55	Layouts Total <b>4</b>
---------------------------	---------------------------

Layout Nr. <b>3</b>	Paper Size <b>ANSI B</b>
------------------------	-----------------------------

Layout ID **AS BUILT-3** Revision



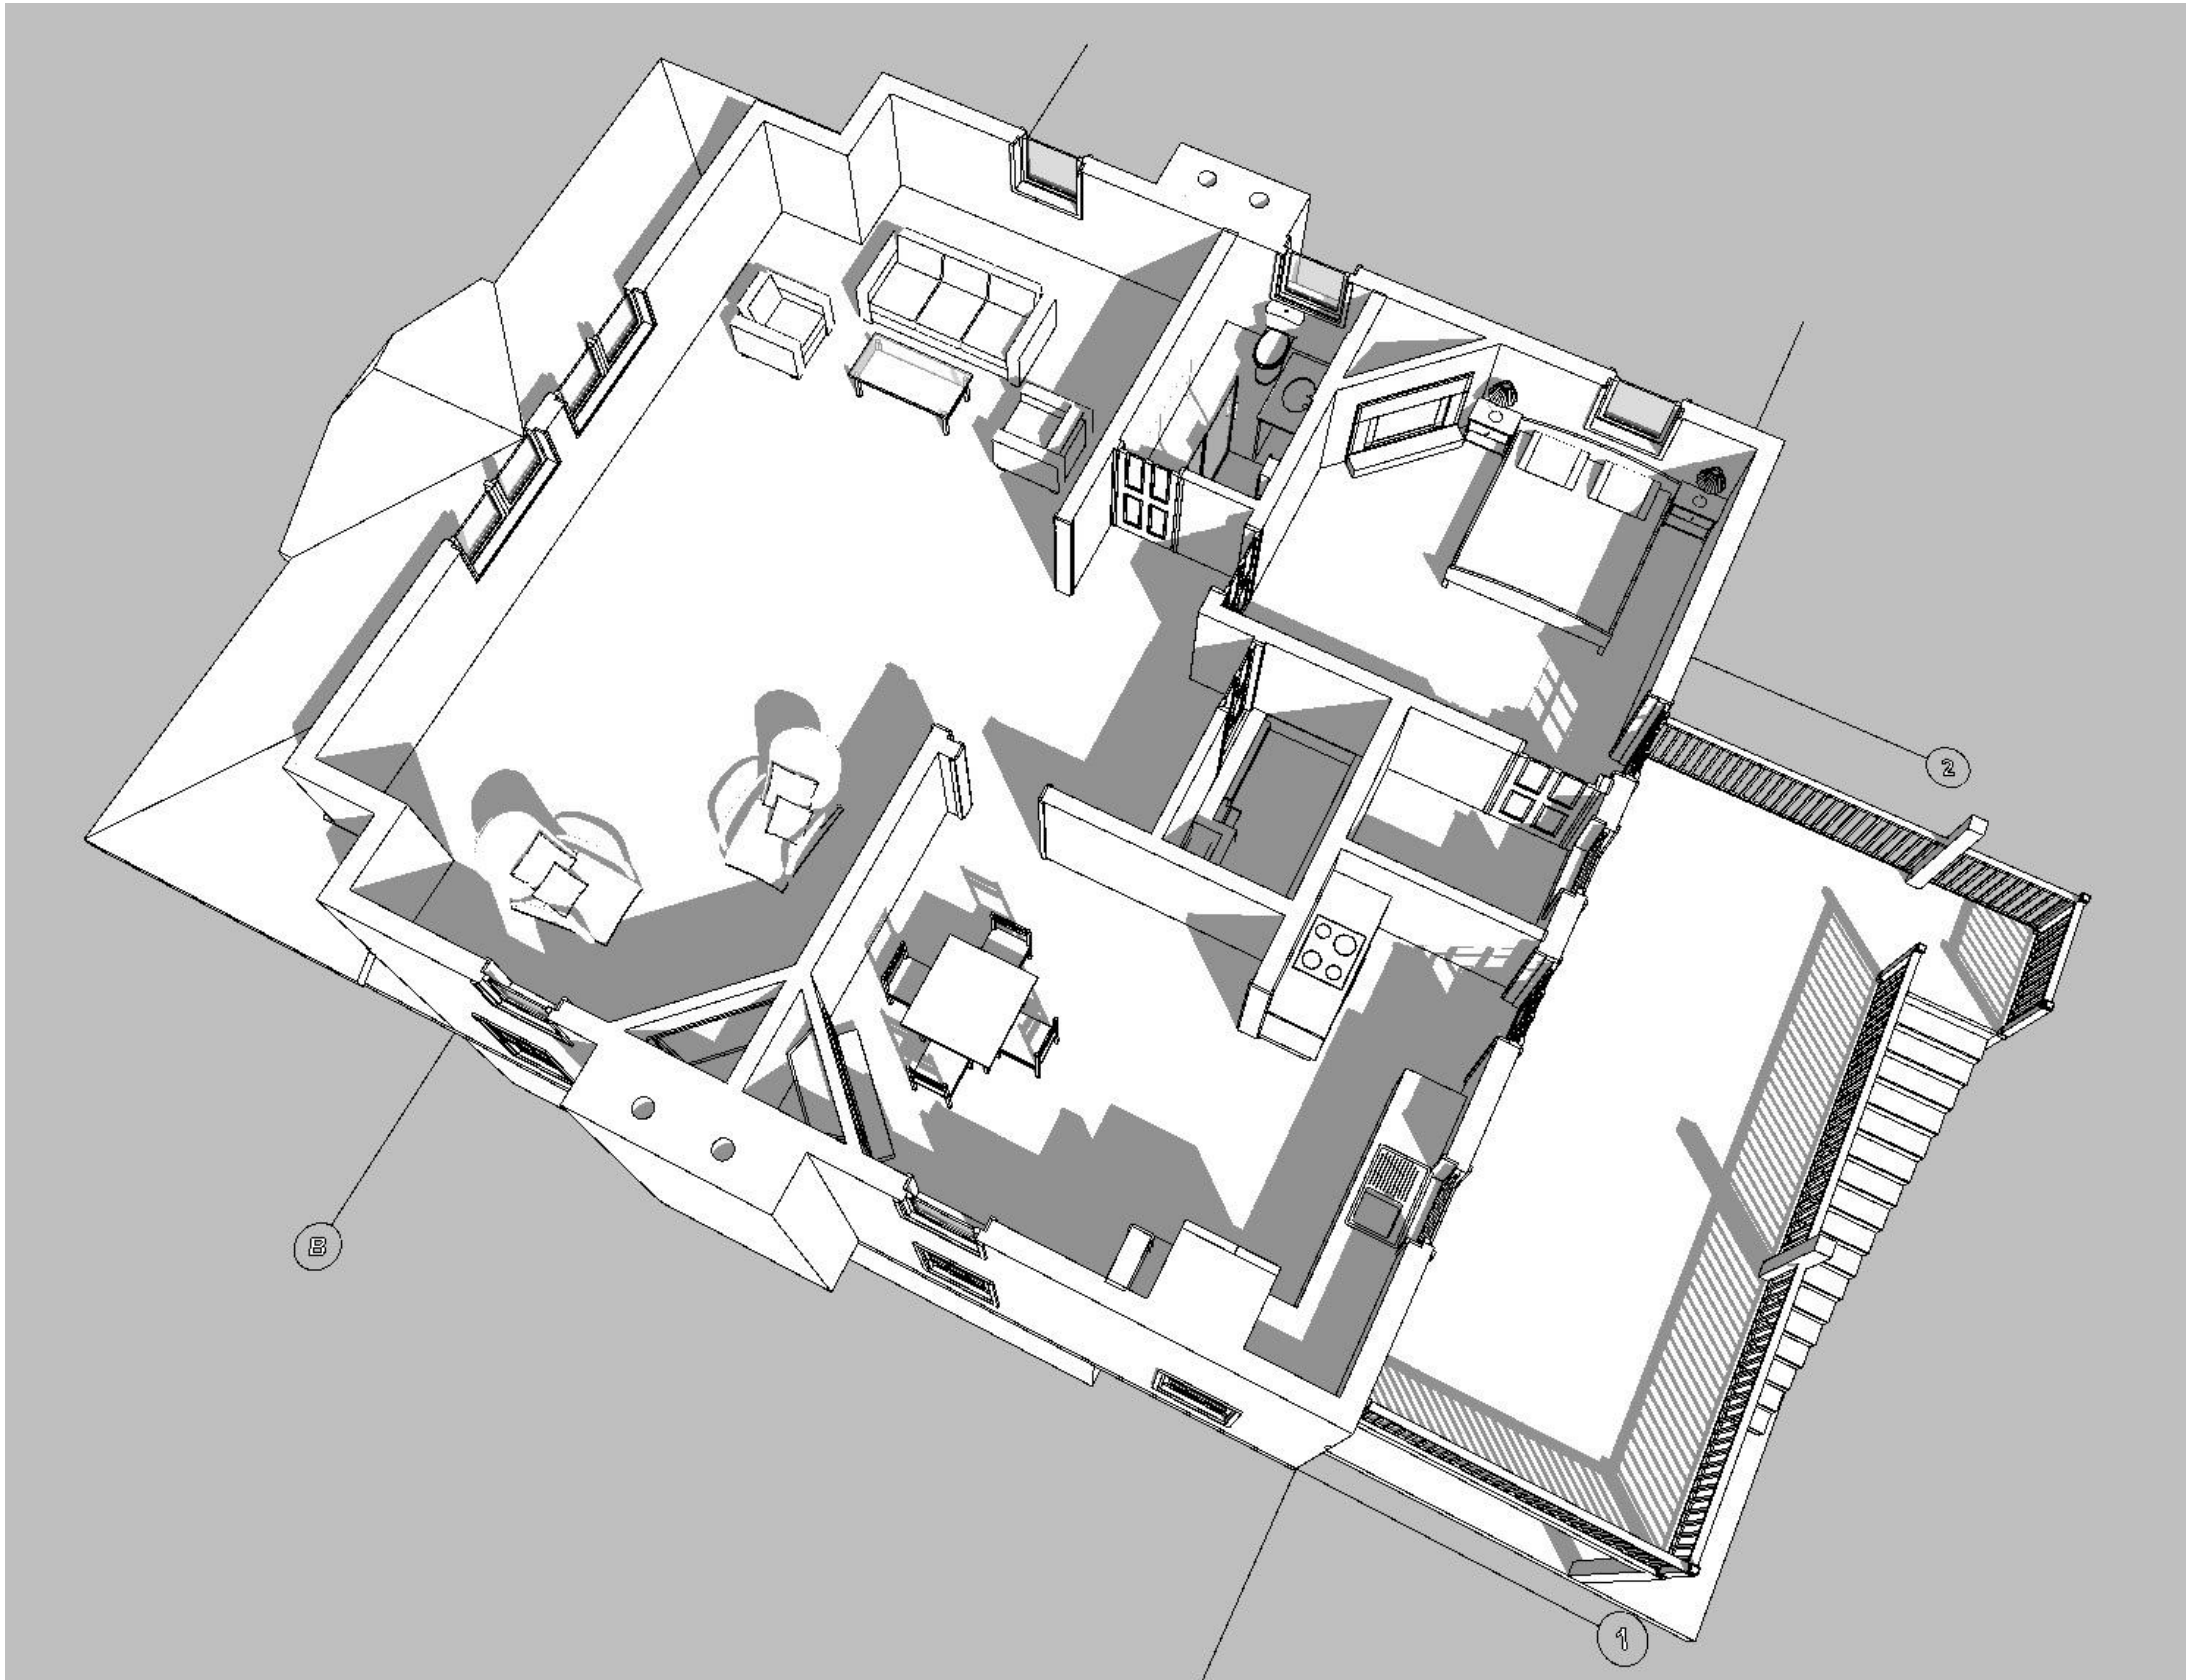


**Generic Perspective /UPPER**



- General Notes:**
1. DO NOT USE AS A BLUEPRINTS WITHOUT MR LLC PERMISSION.
  2. PLEASE NOTE INTERIOR DIMENSIONS WERE NOT USED IN CALCULATING SQUARE FOOTAGE
  3. SIZE OF HEATED AND NOT HEATED AREA AND OTHER INFORMATION WERE OBTAINED PER THE NC REAL ESTATE COMMISSION GUIDELINES ( 6" FOR EXTERNAL WALLS EXCEPT CONDOMINIUMS)
  4. FOR REMODELING QUESTIONS OR MORE DETAILED CAD DRAWINGS (INC.SITE PLAN, SECTIONS, ELEVATIONS) ALSO 3D MODEL PLEASE CONTACT **ALFRED ZALYS** MOB. 828 231 7305 E-MAIL: A.ZALYS@HOTMAIL.COM

- LEGEND MAP:**
- HEATED COMMERC. FINISHED
  - HEATED RESIDENTIAL FINISHED
  - NOT HEATED/NOT FINISHED
  - COVERED PORCH
  - OPEN DECK

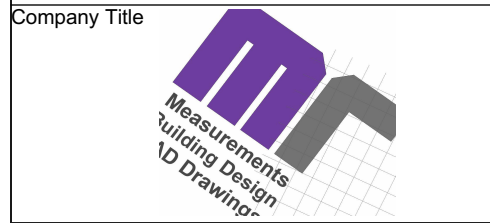

Company  
**Measure Rite LLC**  
 103 Poplar Spring Trl. Hendersonville  
 Henderson County 28739

Site Address  
**141 Merrimon Ave, Asheville,  
 NC 28801**

Drawing Name  
**Generic Perspective /UPPER**

Client:  
**#Client Phone Number**

Drawing Status  
**AS BUILT**

Contact Name <b>Alfred ZALYS</b> mob. 828 231 7305	Job Nr. <b>MR 1136</b> Date <b>9/16/2024</b>
--	---

Drawing Scale 1:87.27	Layouts Total <b>4</b>
--------------------------	---------------------------

Layout Nr. <b>4</b>	Paper Size <b>ANSI B</b>
------------------------	-----------------------------

Layout ID **AS BUILT-4** Revision