



REVISION

AALFS
DEVELOPMENT SERVICES
106 ZACKRY TRACE, FLINTSTONE, GA 30725
PH: (423) 463-8593
EMAIL: BAALFS@OUTLOOK.COM




MIDTOWN - BUILDING 5700
AS-BUILT DRAWINGS

951 EASTGATE LOOP
CHATTANOOGA, TN 37411

AS-BUILT
FLOOR PLAN

4-21-25
2505

A1.0

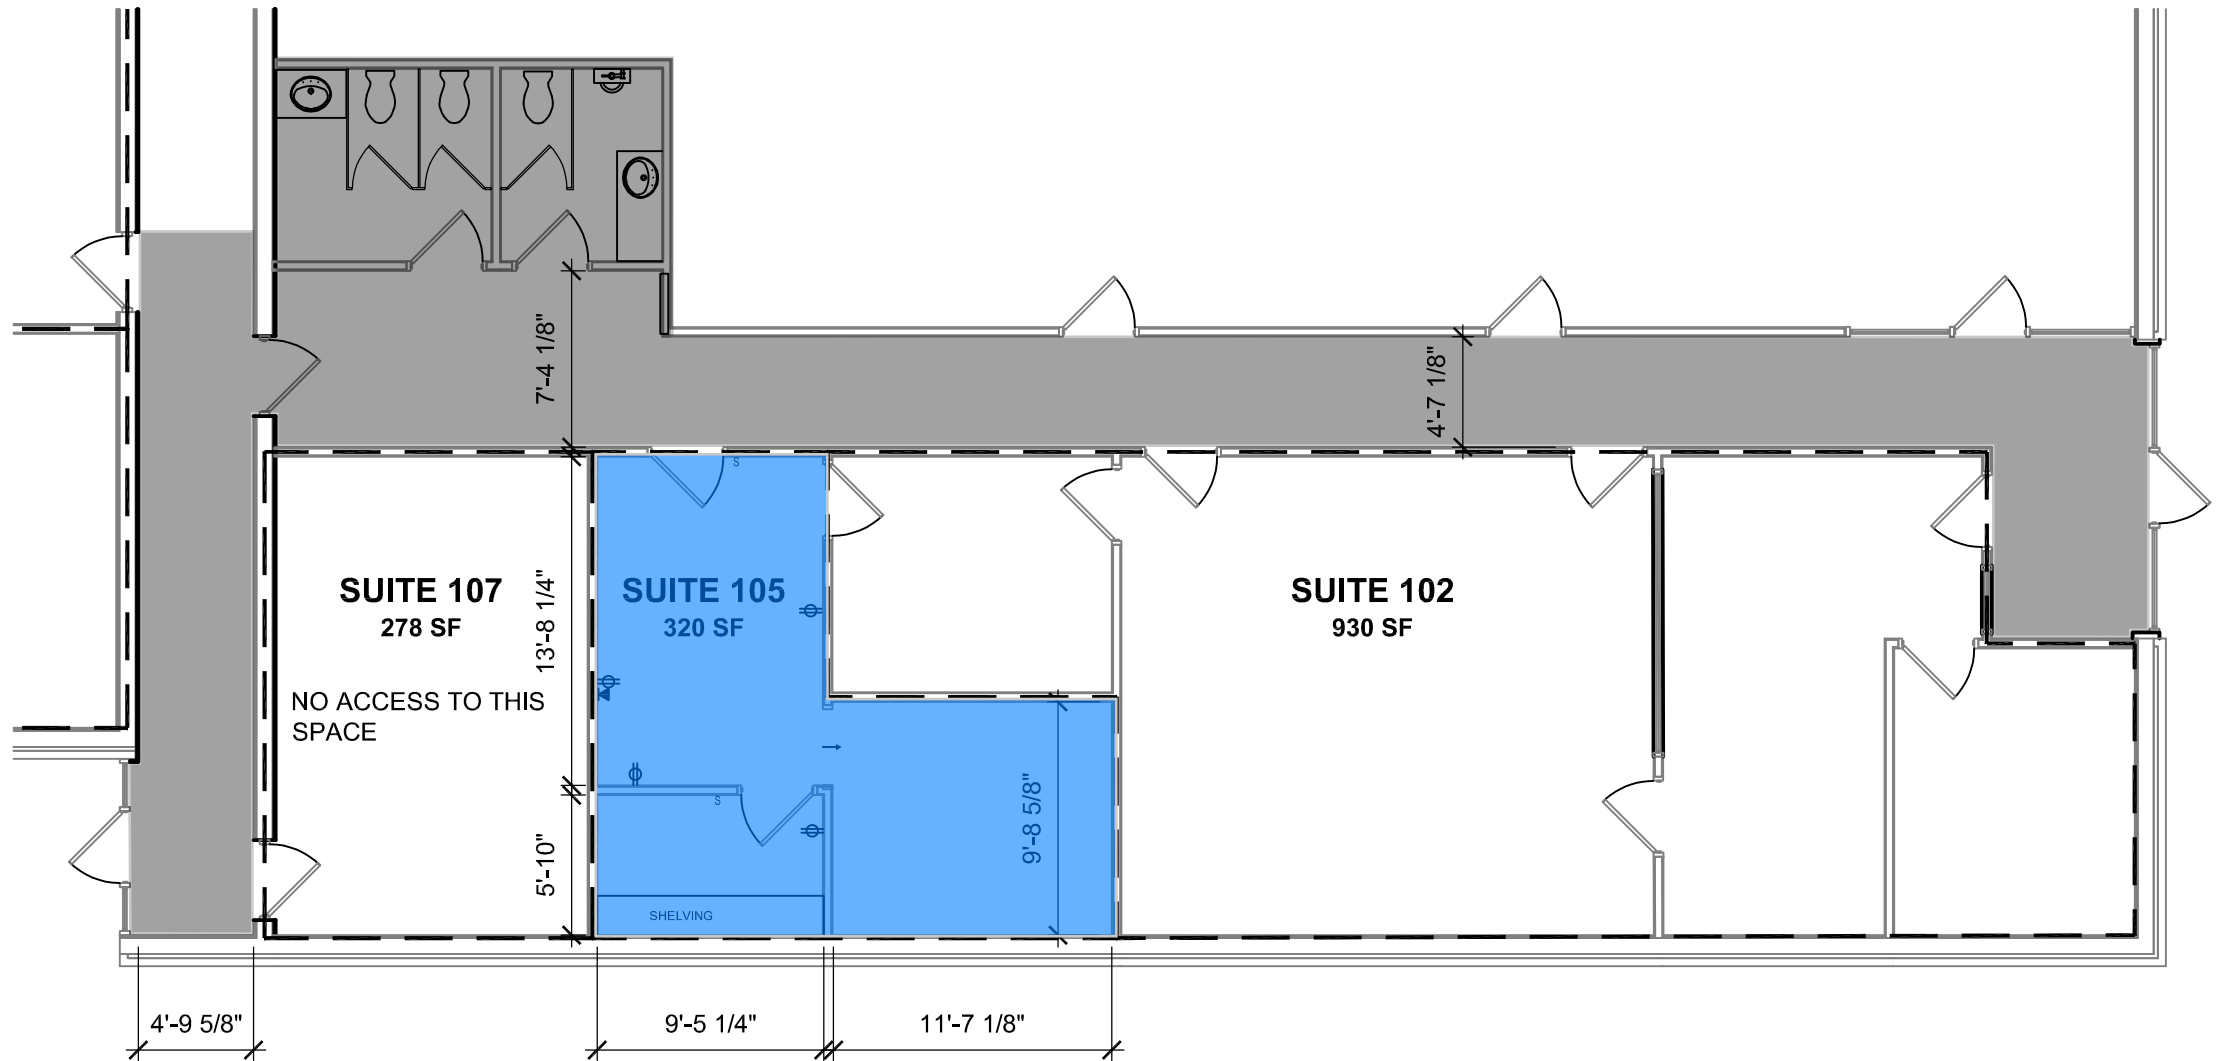

FLOOR PLAN

SCALE: 1/8"=1'-0"



MIDTOWN - 5700 BLDG
AS-BUILT DRAWINGS

951 EASTGATE LOOP
CHATTANOOGA, TN 37411

SUITE 105
AS-BUILT

4-28-25


2505

AAFS

DEVELOPMENT SERVICES

106 ZACKRY TRACE, FLINTSTONE, GA 30725
PH: (423) 463-8593
EMAIL: BAALFS@OUTLOOK.COM

REVISION

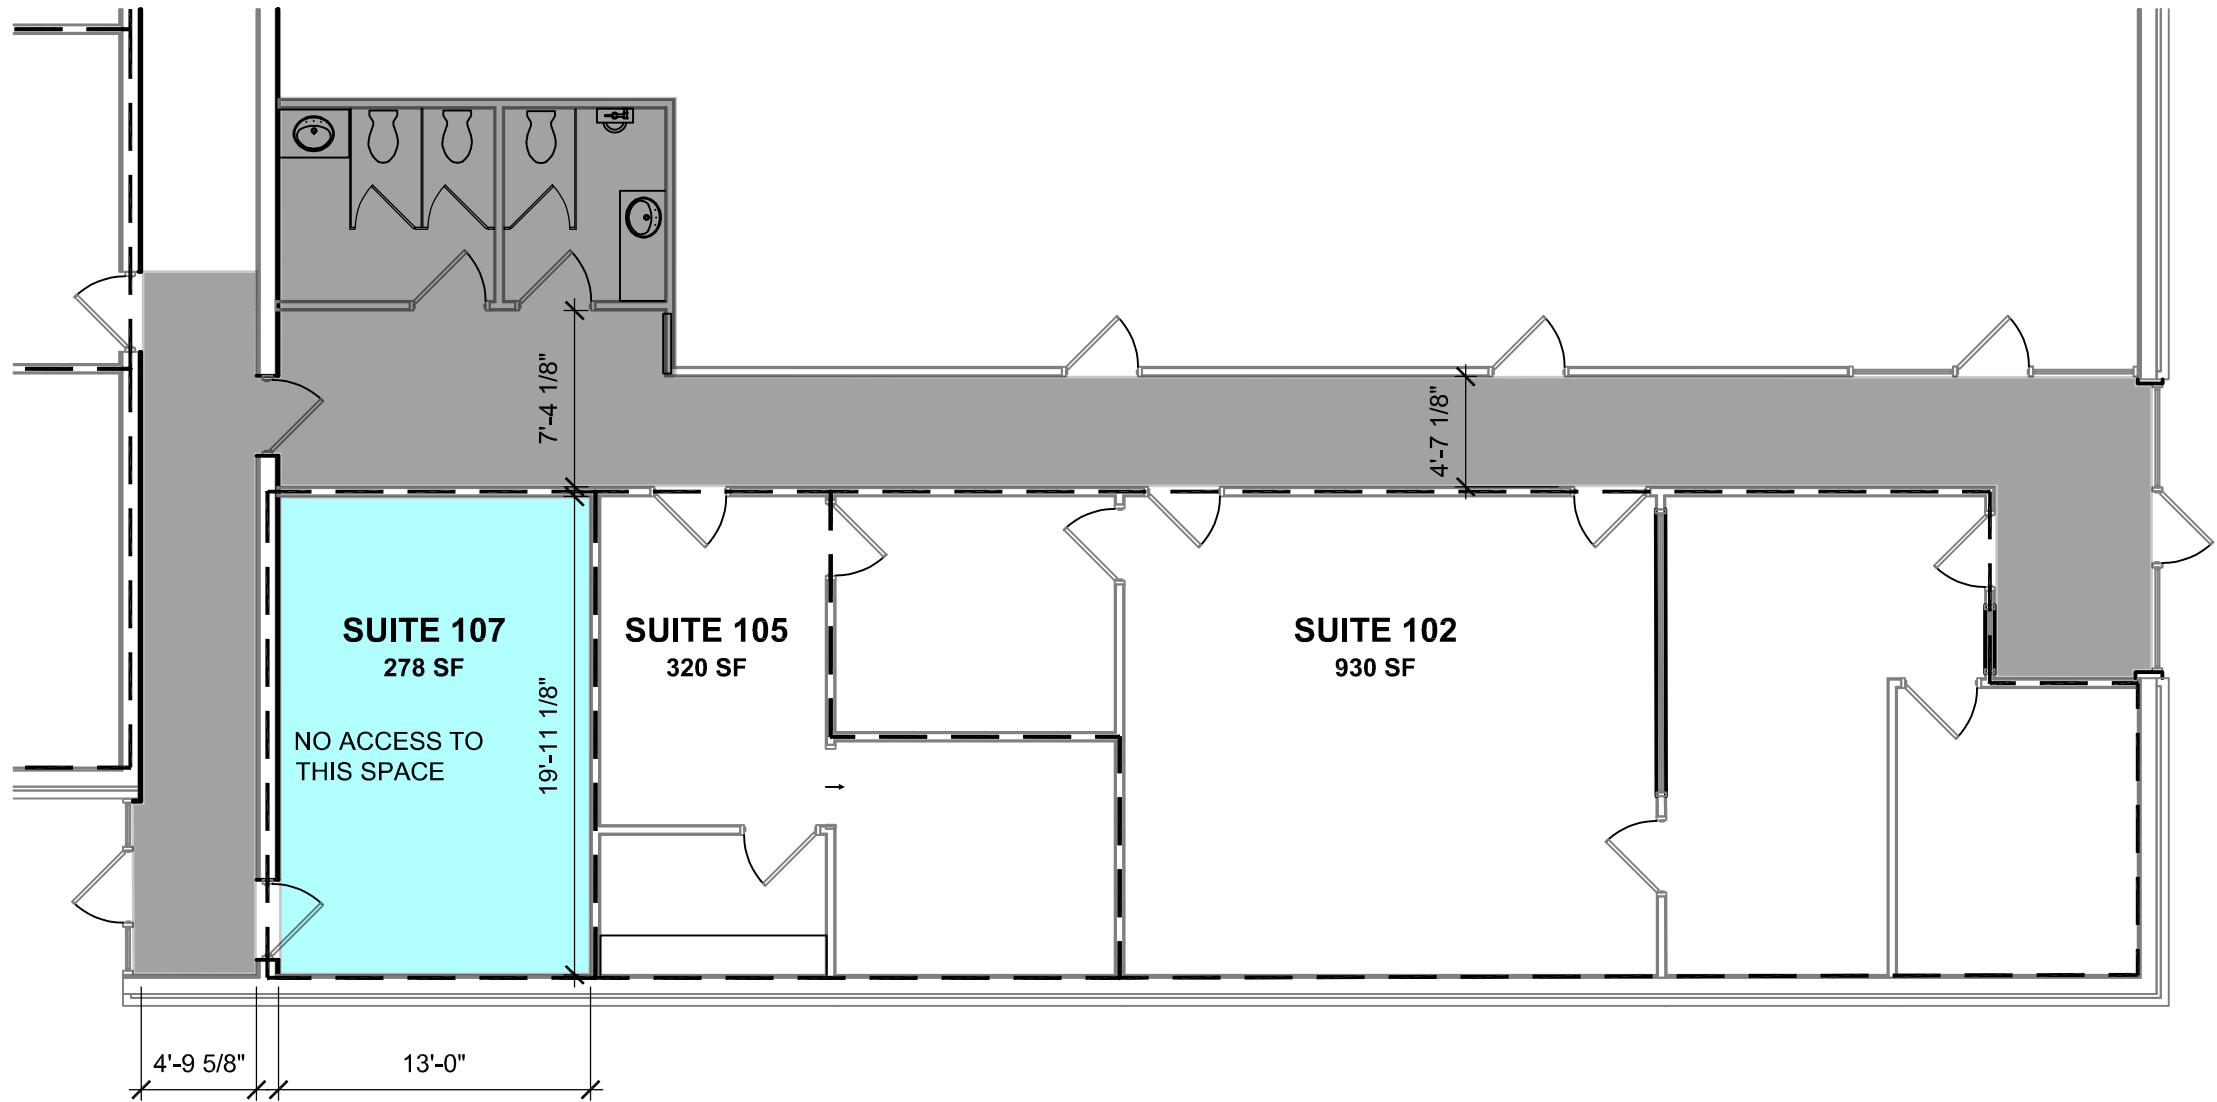

FLOOR PLAN


SCALE: 1/8"=1'-0"

REVISION

AALFS
DEVELOPMENT SERVICES
106 ZACKRY TRACE, FLINTSTONE, GA 30725
PH: (423) 463-8593
EMAIL: BAALFS@OUTLOOK.COM



MIDTOWN - 5700 BLDG
AS-BUILT DRAWINGS
951 EASTGATE LOOP
CHATTANOOGA, TN 37411

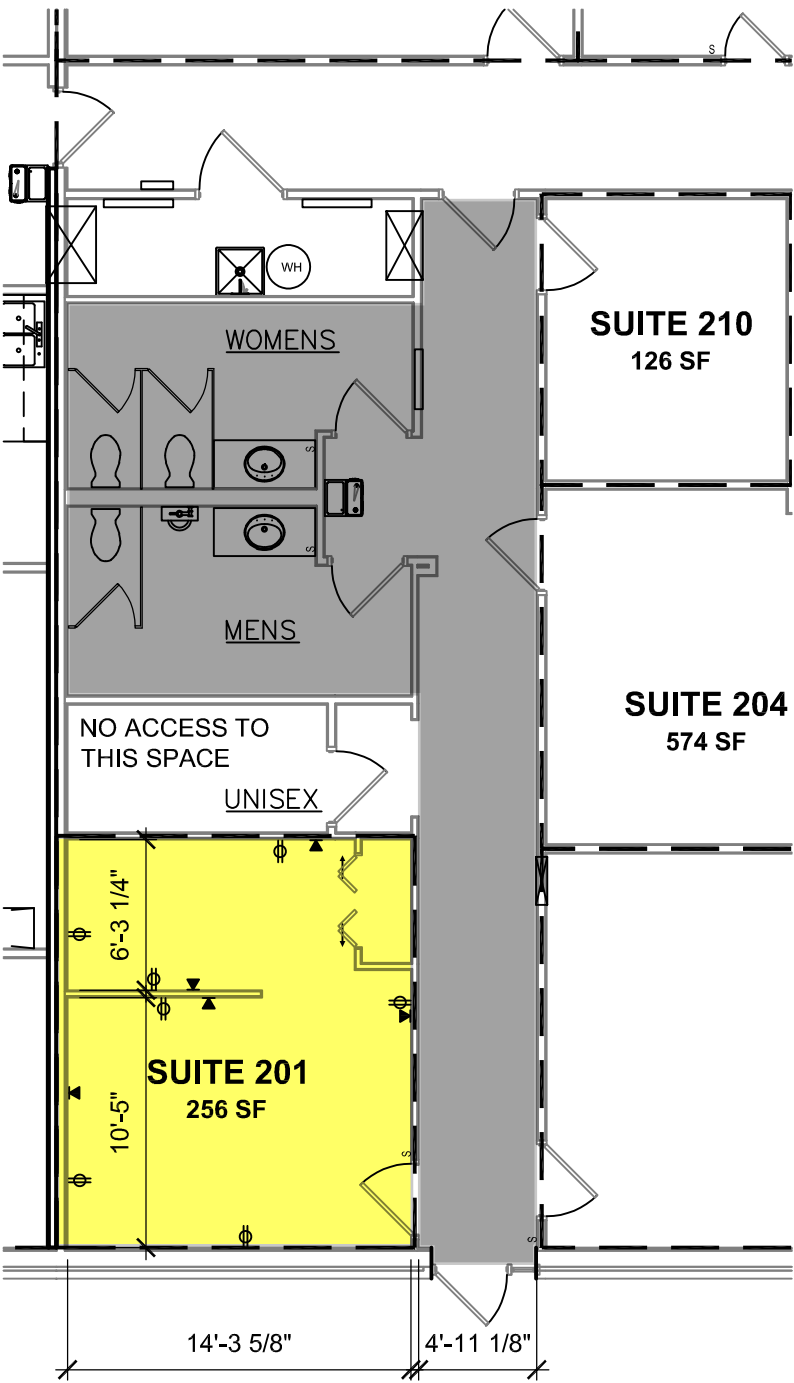

FLOOR PLAN

SCALE: 1/8"=1'-0"

SUITE 201
AS-BUILT

4-28-25

2505

201


MIDTOWN - 5700 BLDG
AS-BUILT DRAWINGS

951 EASTGATE LOOP
CHATTANOOGA, TN 37411



AAFS
DEVELOPMENT SERVICES
106 ZACKRY TRACE, FLINTSTONE, GA 30725
PH: (423) 463-8593
EMAIL: BAALFS@OUTLOOK.COM

REVISION

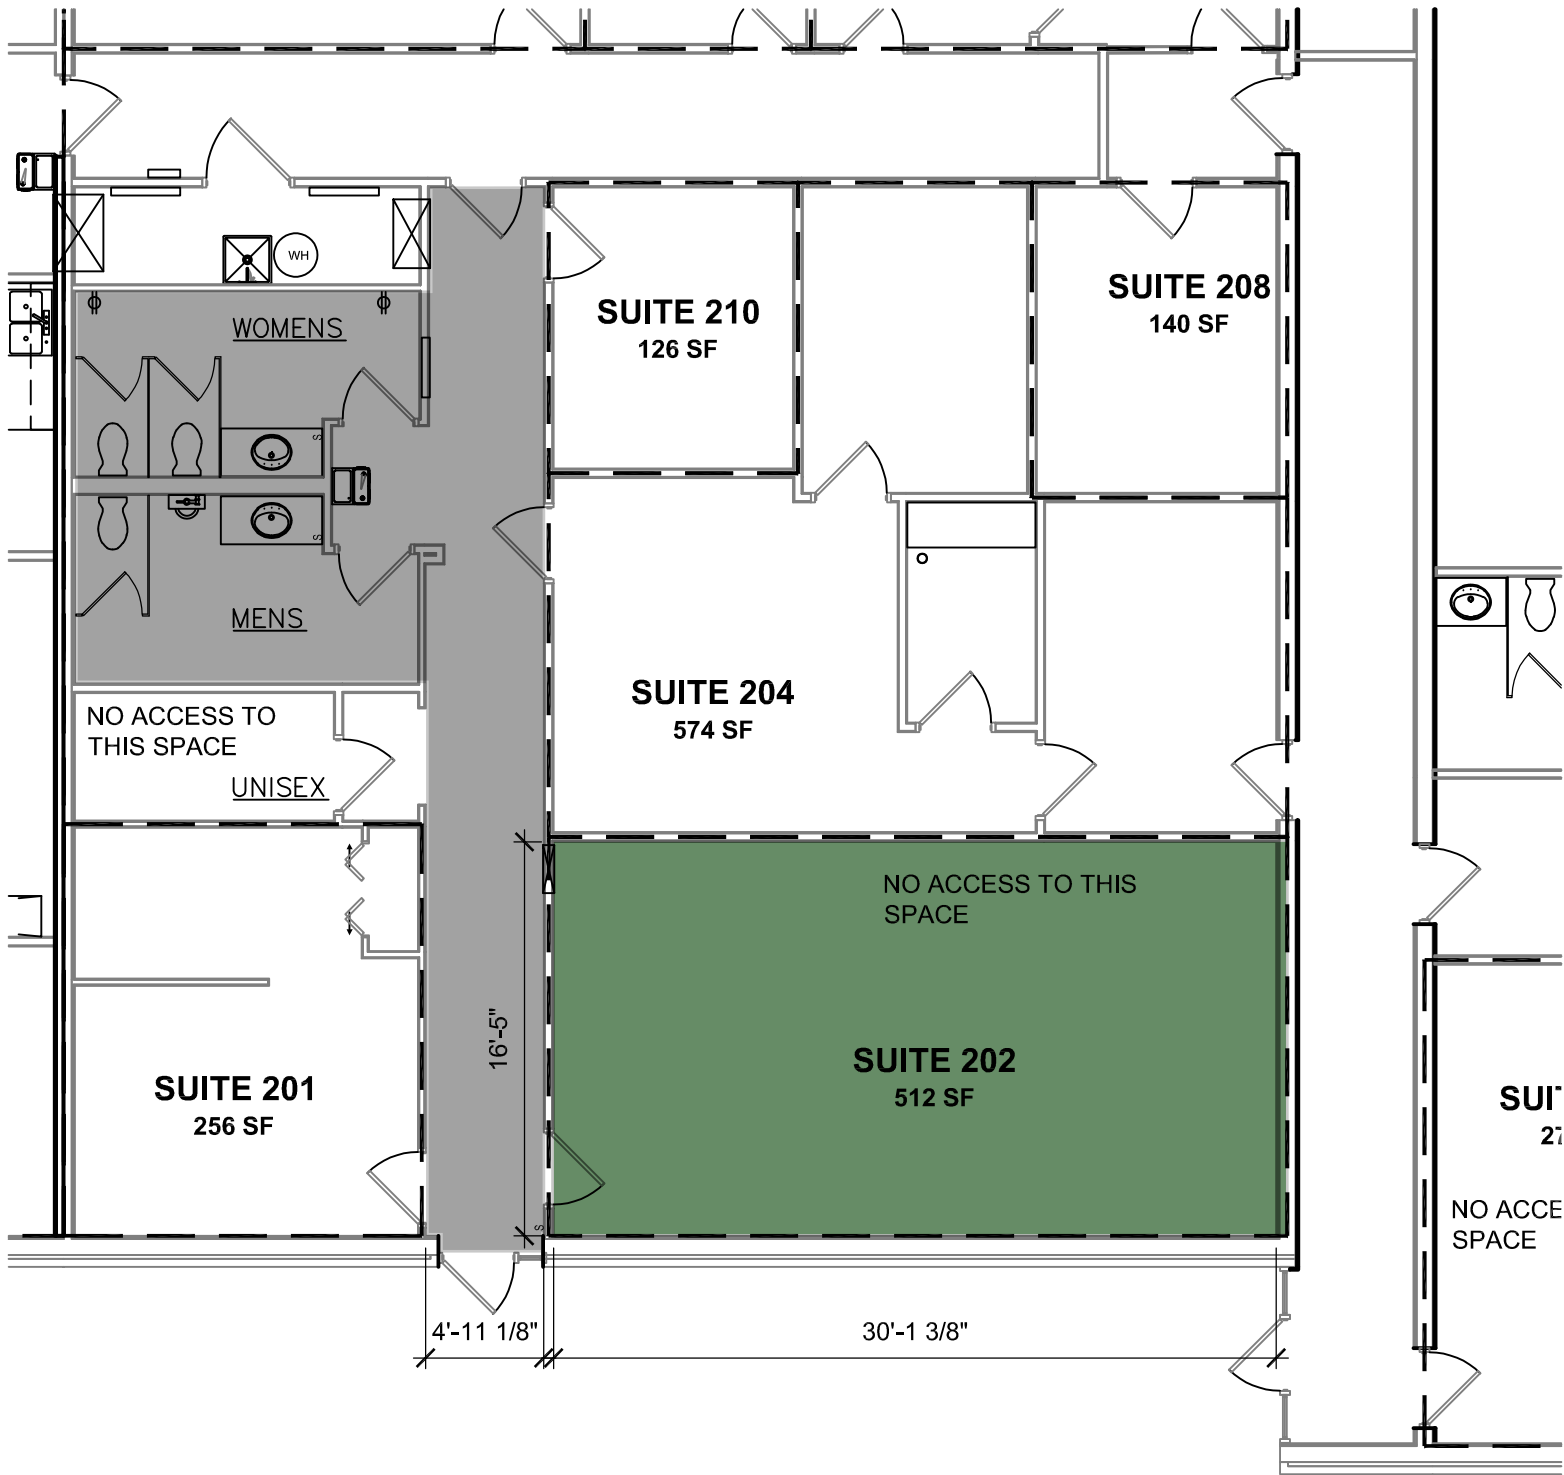

FLOOR PLAN

SCALE: 1/8"=1'-0"

REVISION


AALFS
DEVELOPMENT SERVICES
106 ZACKRY TRACE, FLINTSTONE, GA 30725
PH: (423) 463-8593
EMAIL: BAALFS@OUTLOOK.COM



MIDTOWN - 5700 BLDG
AS-BUILT DRAWINGS
951 EASTGATE LOOP
CHATTANOOGA, TN 37411

SUITE 202
AS-BUILT

4-28-25
2505

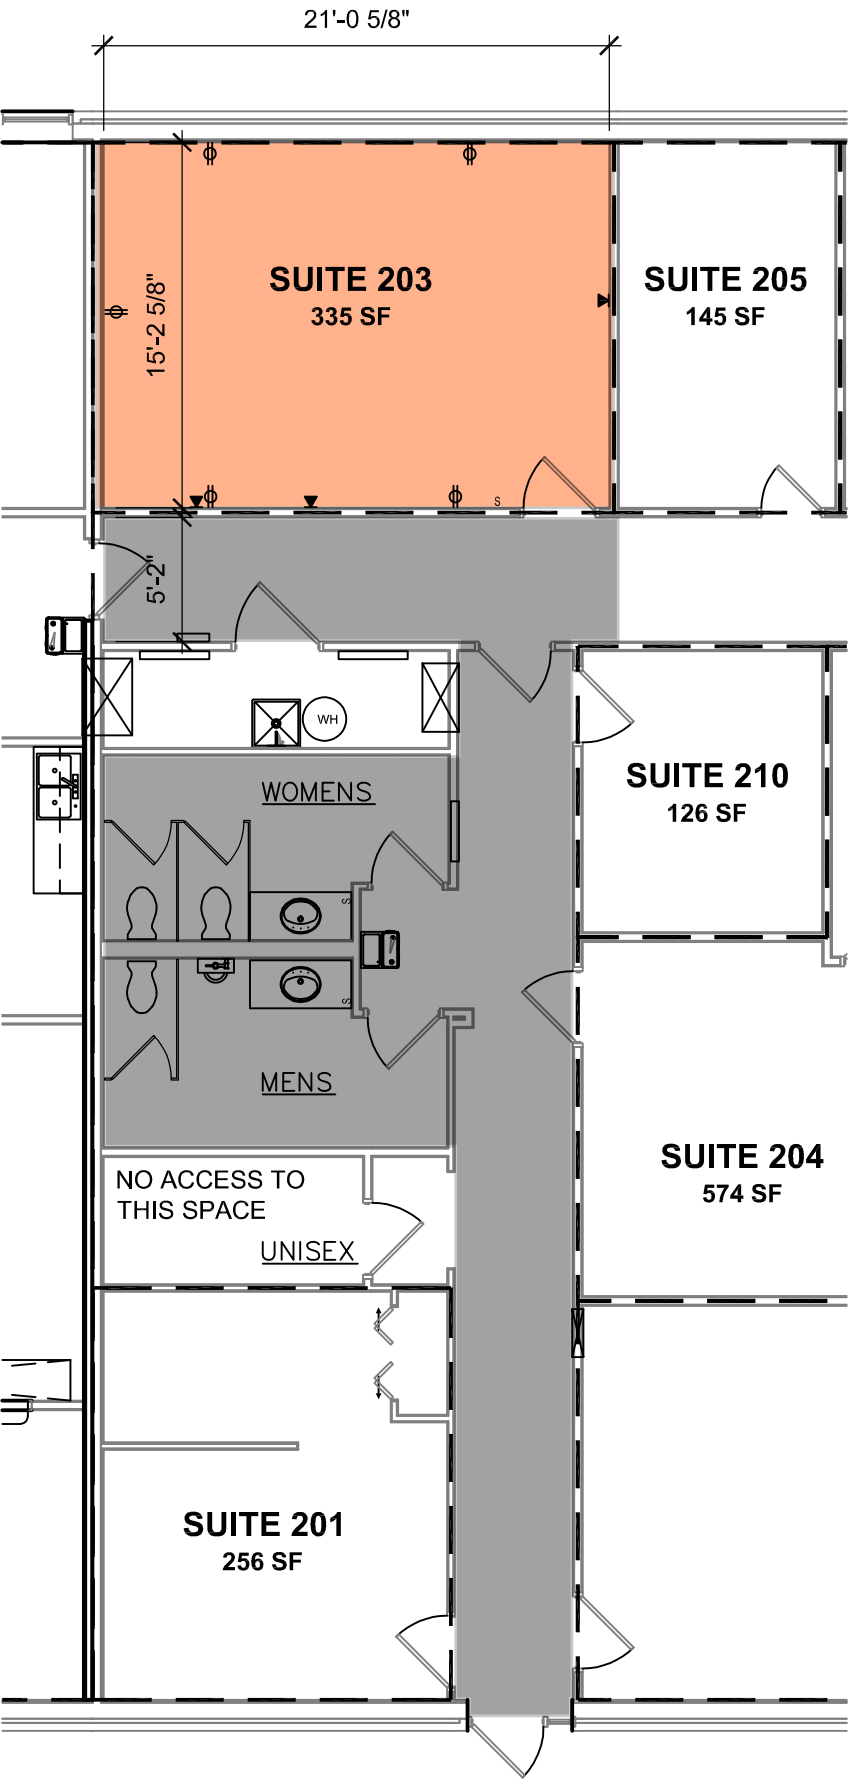

FLOOR PLAN

SCALE: 1/8"=1'-0"

REVISION

AALFS
DEVELOPMENT SERVICES
106 ZACKRY TRACE, FLINTSTONE, GA 30725
PH: (423) 463-8593
EMAIL: BAALFS@OUTLOOK.COM




MIDTOWN - 5700 BLDG
AS-BUILT DRAWINGS

951 EASTGATE LOOP
CHATTANOOGA, TN 37411

SUITE 203
AS-BUILT

4-28-25
2505

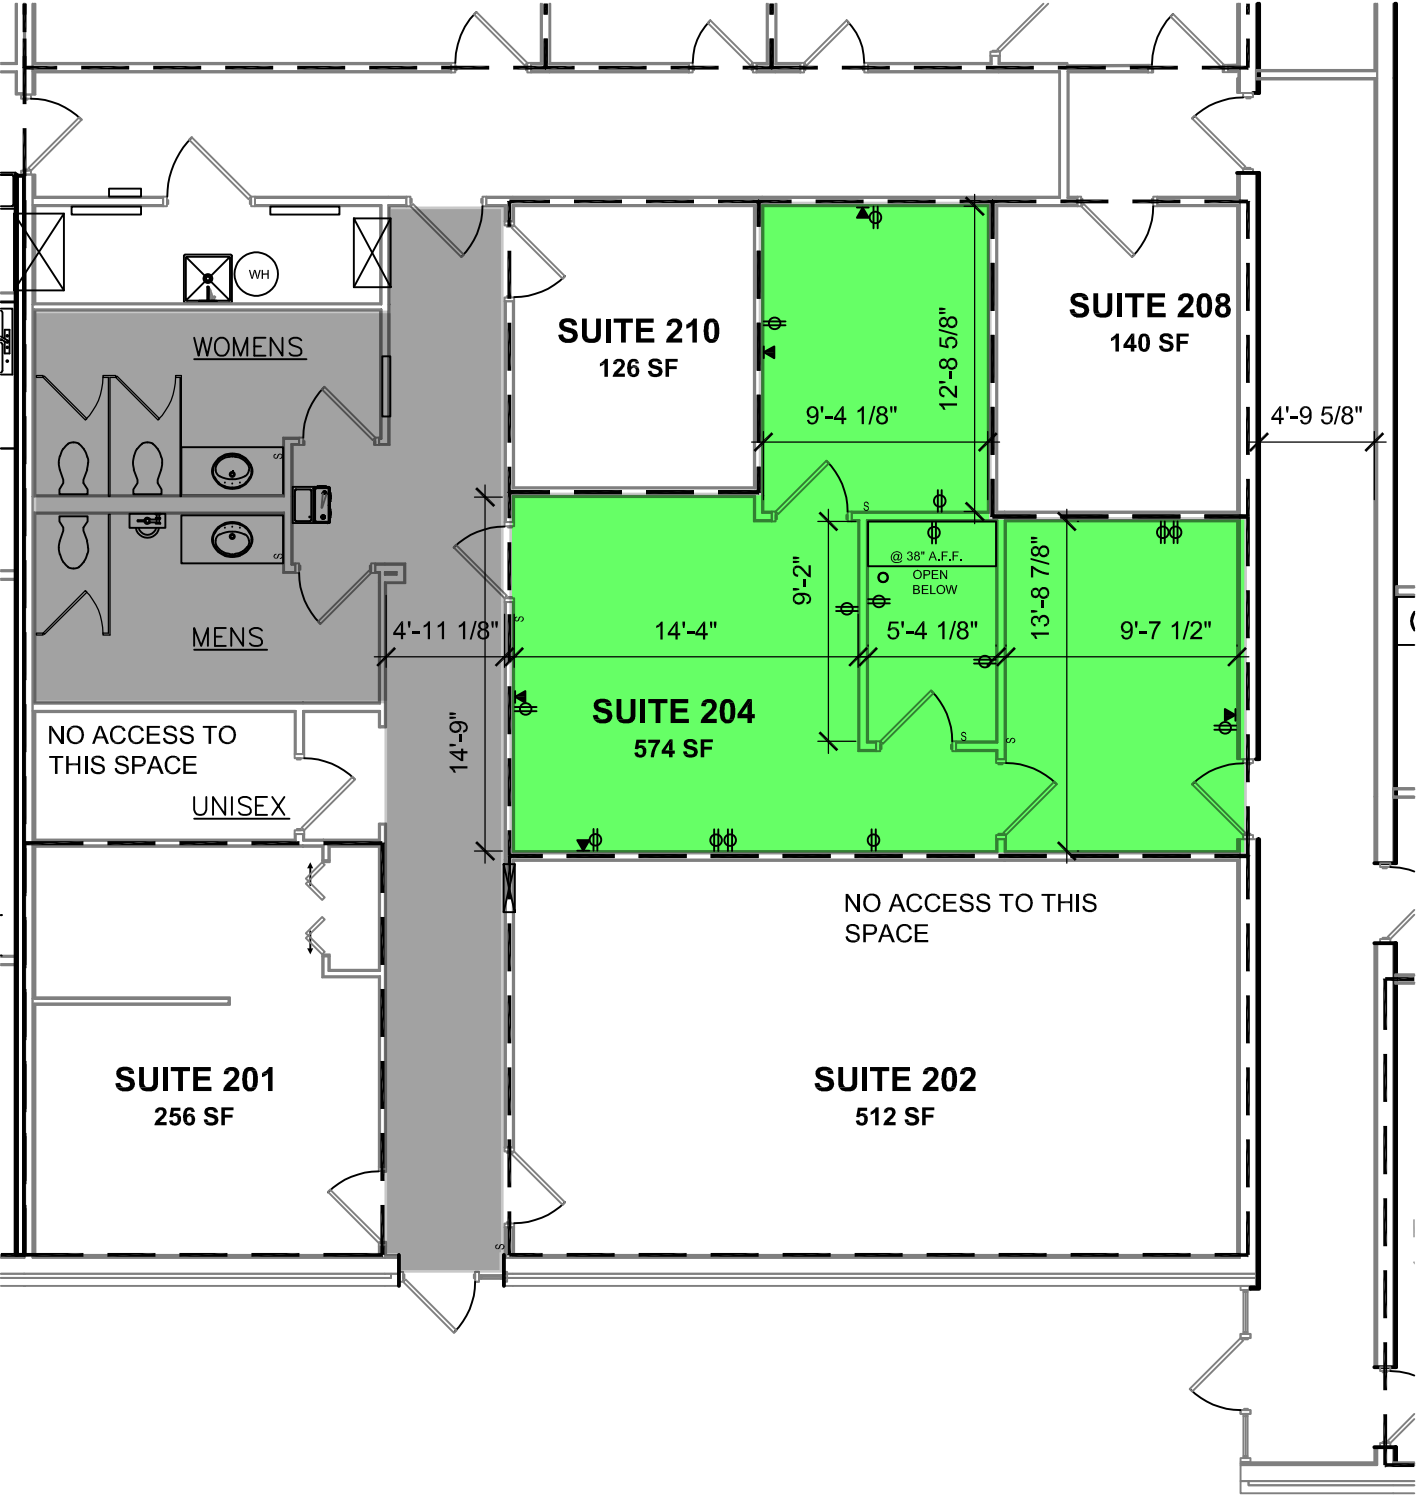

FLOOR PLAN

SCALE: 1/8"=1'-0"

REVISION

AALFS
DEVELOPMENT SERVICES
106 ZACKRY TRACE, FLINTSTONE, GA 30725
PH: (423) 463-8593
EMAIL: BAALFS@OUTLOOK.COM




MIDTOWN - 5700 BLDG
AS-BUILT DRAWINGS

951 EASTGATE LOOP
CHATTANOOGA, TN 37411

SUITE 204
AS-BUILT

4-28-25
2505

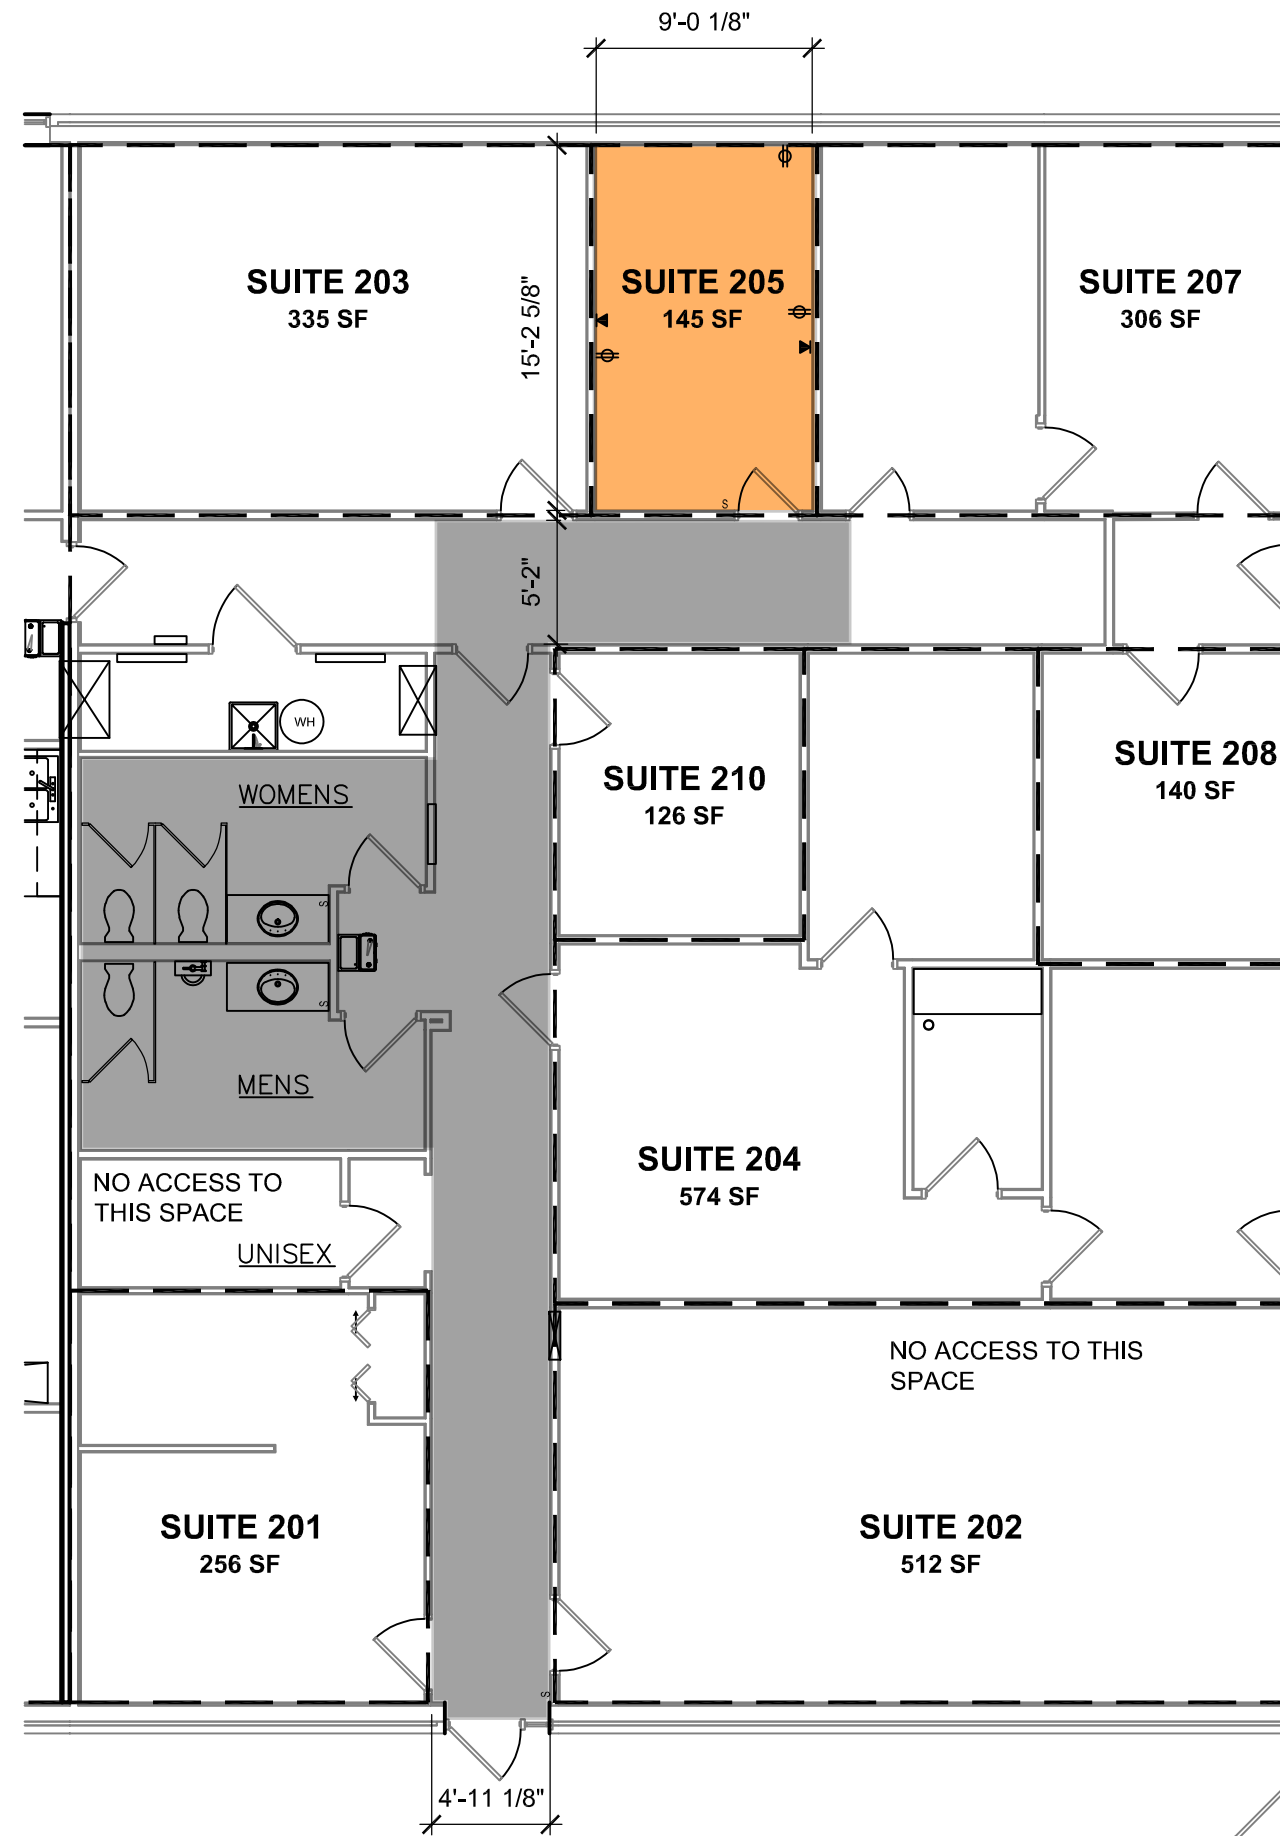

FLOOR PLAN

SCALE: 1/8"=1'-0"

REVISION

AALFS
DEVELOPMENT SERVICES
106 ZACKRY TRACE, FLINTSTONE, GA 30725
PH: (423) 463-8593
EMAIL: BAALFS@OUTLOOK.COM




MIDTOWN - 5700 BLDG
AS-BUILT DRAWINGS

951 EASTGATE LOOP
CHATTANOOGA, TN 37411

SUITE 205
AS-BUILT

4-28-25
2505

205

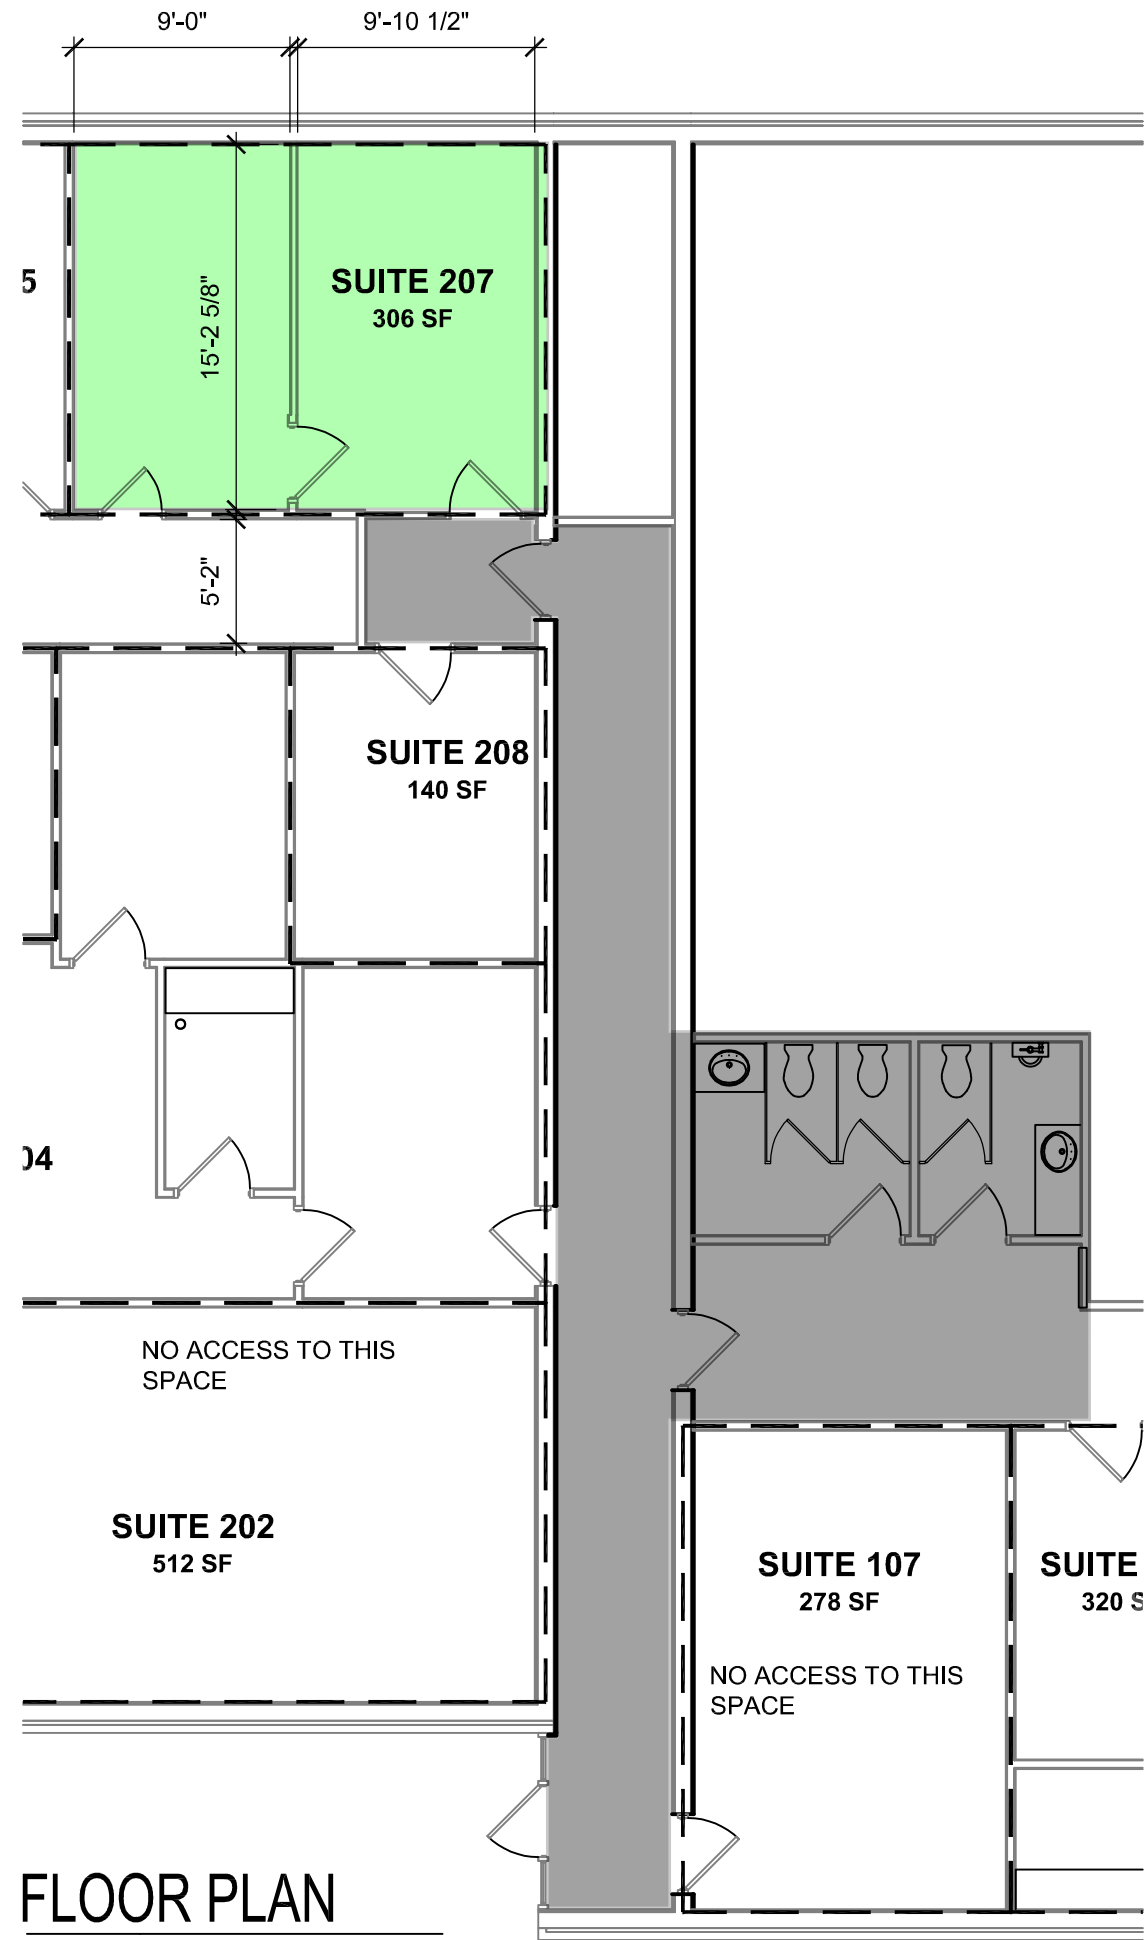

FLOOR PLAN

SCALE: 1/8"=1'-0"

REVISION

AALFS
DEVELOPMENT SERVICES
106 ZACKRY TRACE, FLINTSTONE, GA 30725
PH: (423) 463-8593
EMAIL: BAALFS@OUTLOOK.COM



MIDTOWN - 5700 BLDG
AS-BUILT DRAWINGS

951 EASTGATE LOOP
CHATTANOOGA, TN 37411

SUITE 207
AS-BUILT

4-28-25

2505

207



FLOOR PLAN

SCALE: 1/8"=1'-0"

REVISION

AALFS
DEVELOPMENT SERVICES
106 ZACKRY TRACE, FLINTSTONE, GA 30725
PH: (423) 463-8593
EMAIL: BAALFS@OUTLOOK.COM




MIDTOWN - 5700 BLDG
AS-BUILT DRAWINGS

951 EASTGATE LOOP
CHATTANOOGA, TN 37411

SUITE 208
AS-BUILT

4-28-25
2505

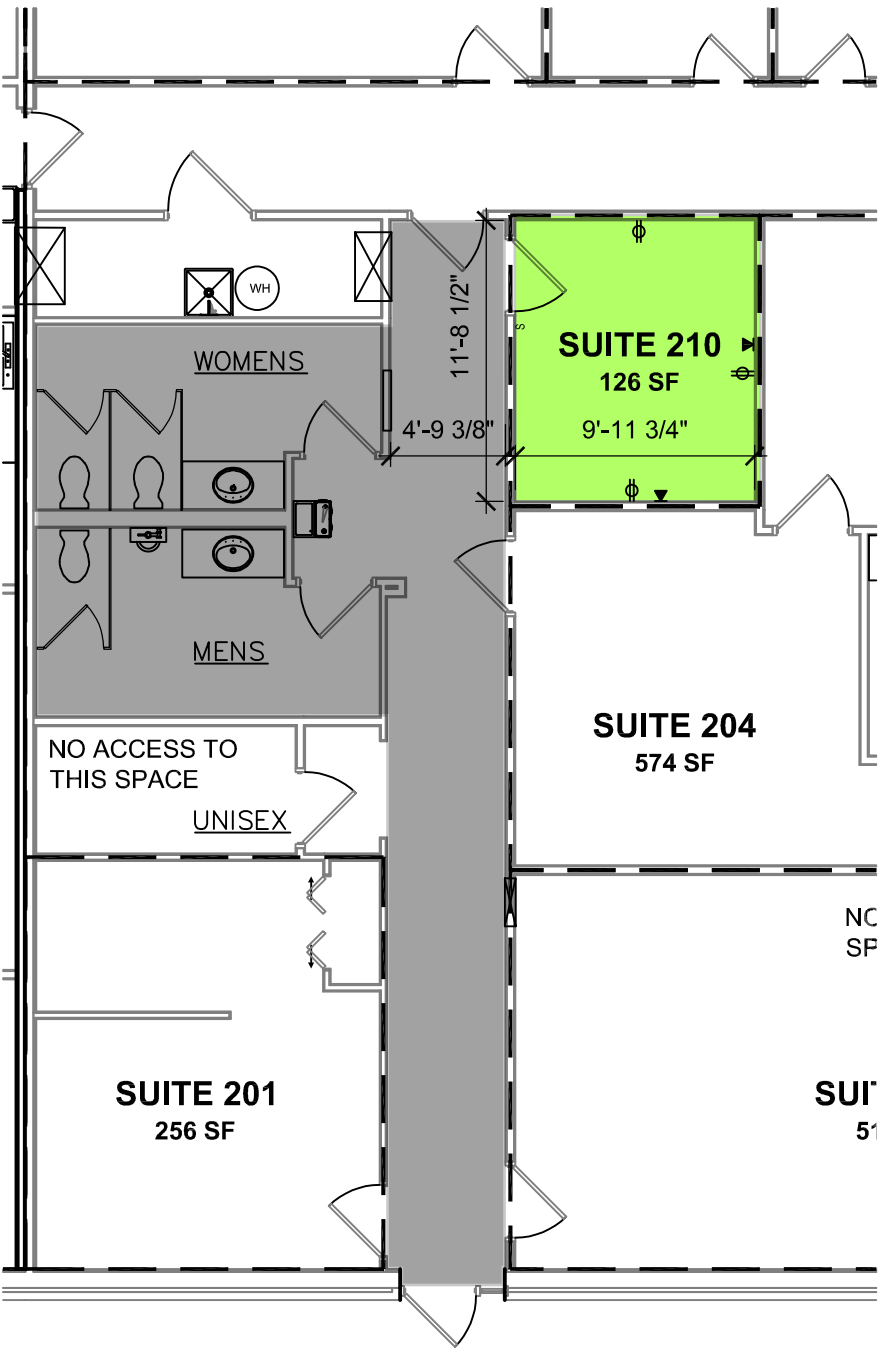

FLOOR PLAN

SCALE: 1/8"=1'-0"

REVISION

AALFS
DEVELOPMENT SERVICES
106 ZACKRY TRACE, FLINTSTONE, GA 30725
PH: (423) 463-8593
EMAIL: BAALFS@OUTLOOK.COM




MIDTOWN - 5700 BLDG
AS-BUILT DRAWINGS

951 EASTGATE LOOP
CHATTANOOGA, TN 37411

SUITE 210
AS-BUILT

4-28-25
2505

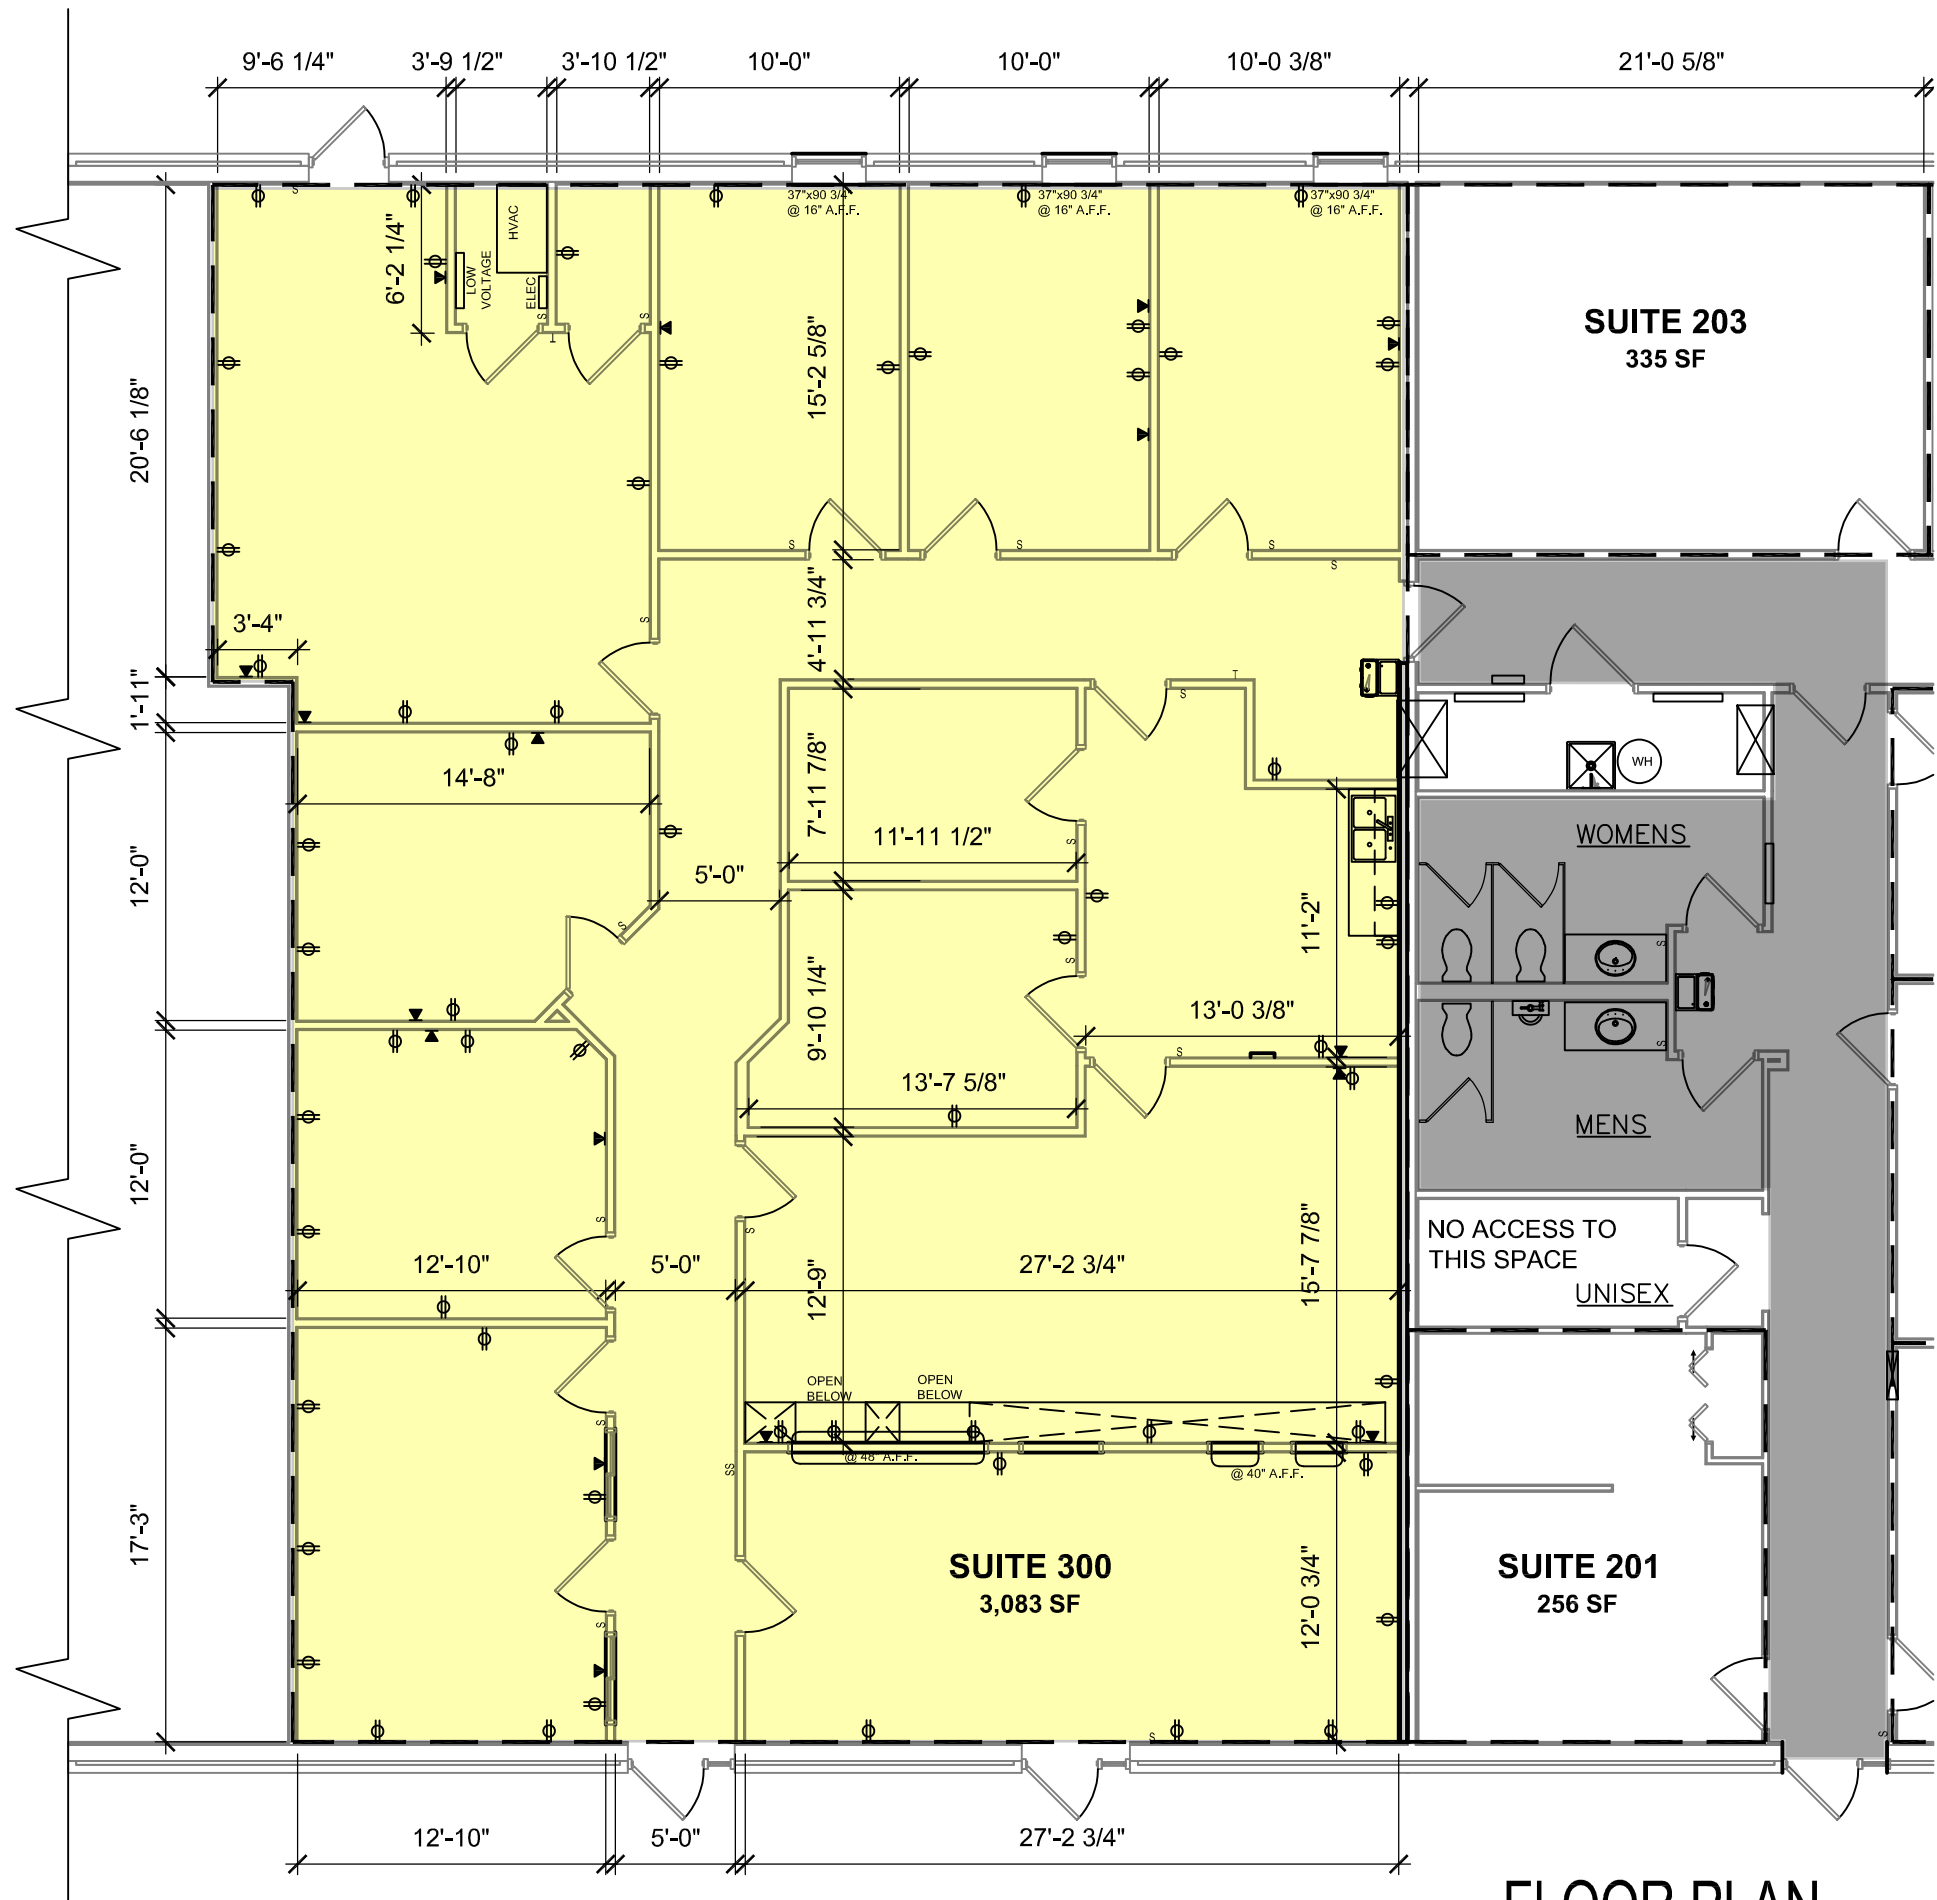

FLOOR PLAN

SCALE: 1/8"=1'-0"

REVISION

AALFS
DEVELOPMENT SERVICES
106 ZACKRY TRACE, FLINTSTONE, GA 30725
PH: (423) 463-8593
EMAIL: BAALFS@OUTLOOK.COM



MIDTOWN - 5700 BLDG
AS-BUILT DRAWINGS

951 EASTGATE LOOP
CHATTANOOGA, TN 37411

SUITE 300
AS-BUILT

4-28-25
2505

300