


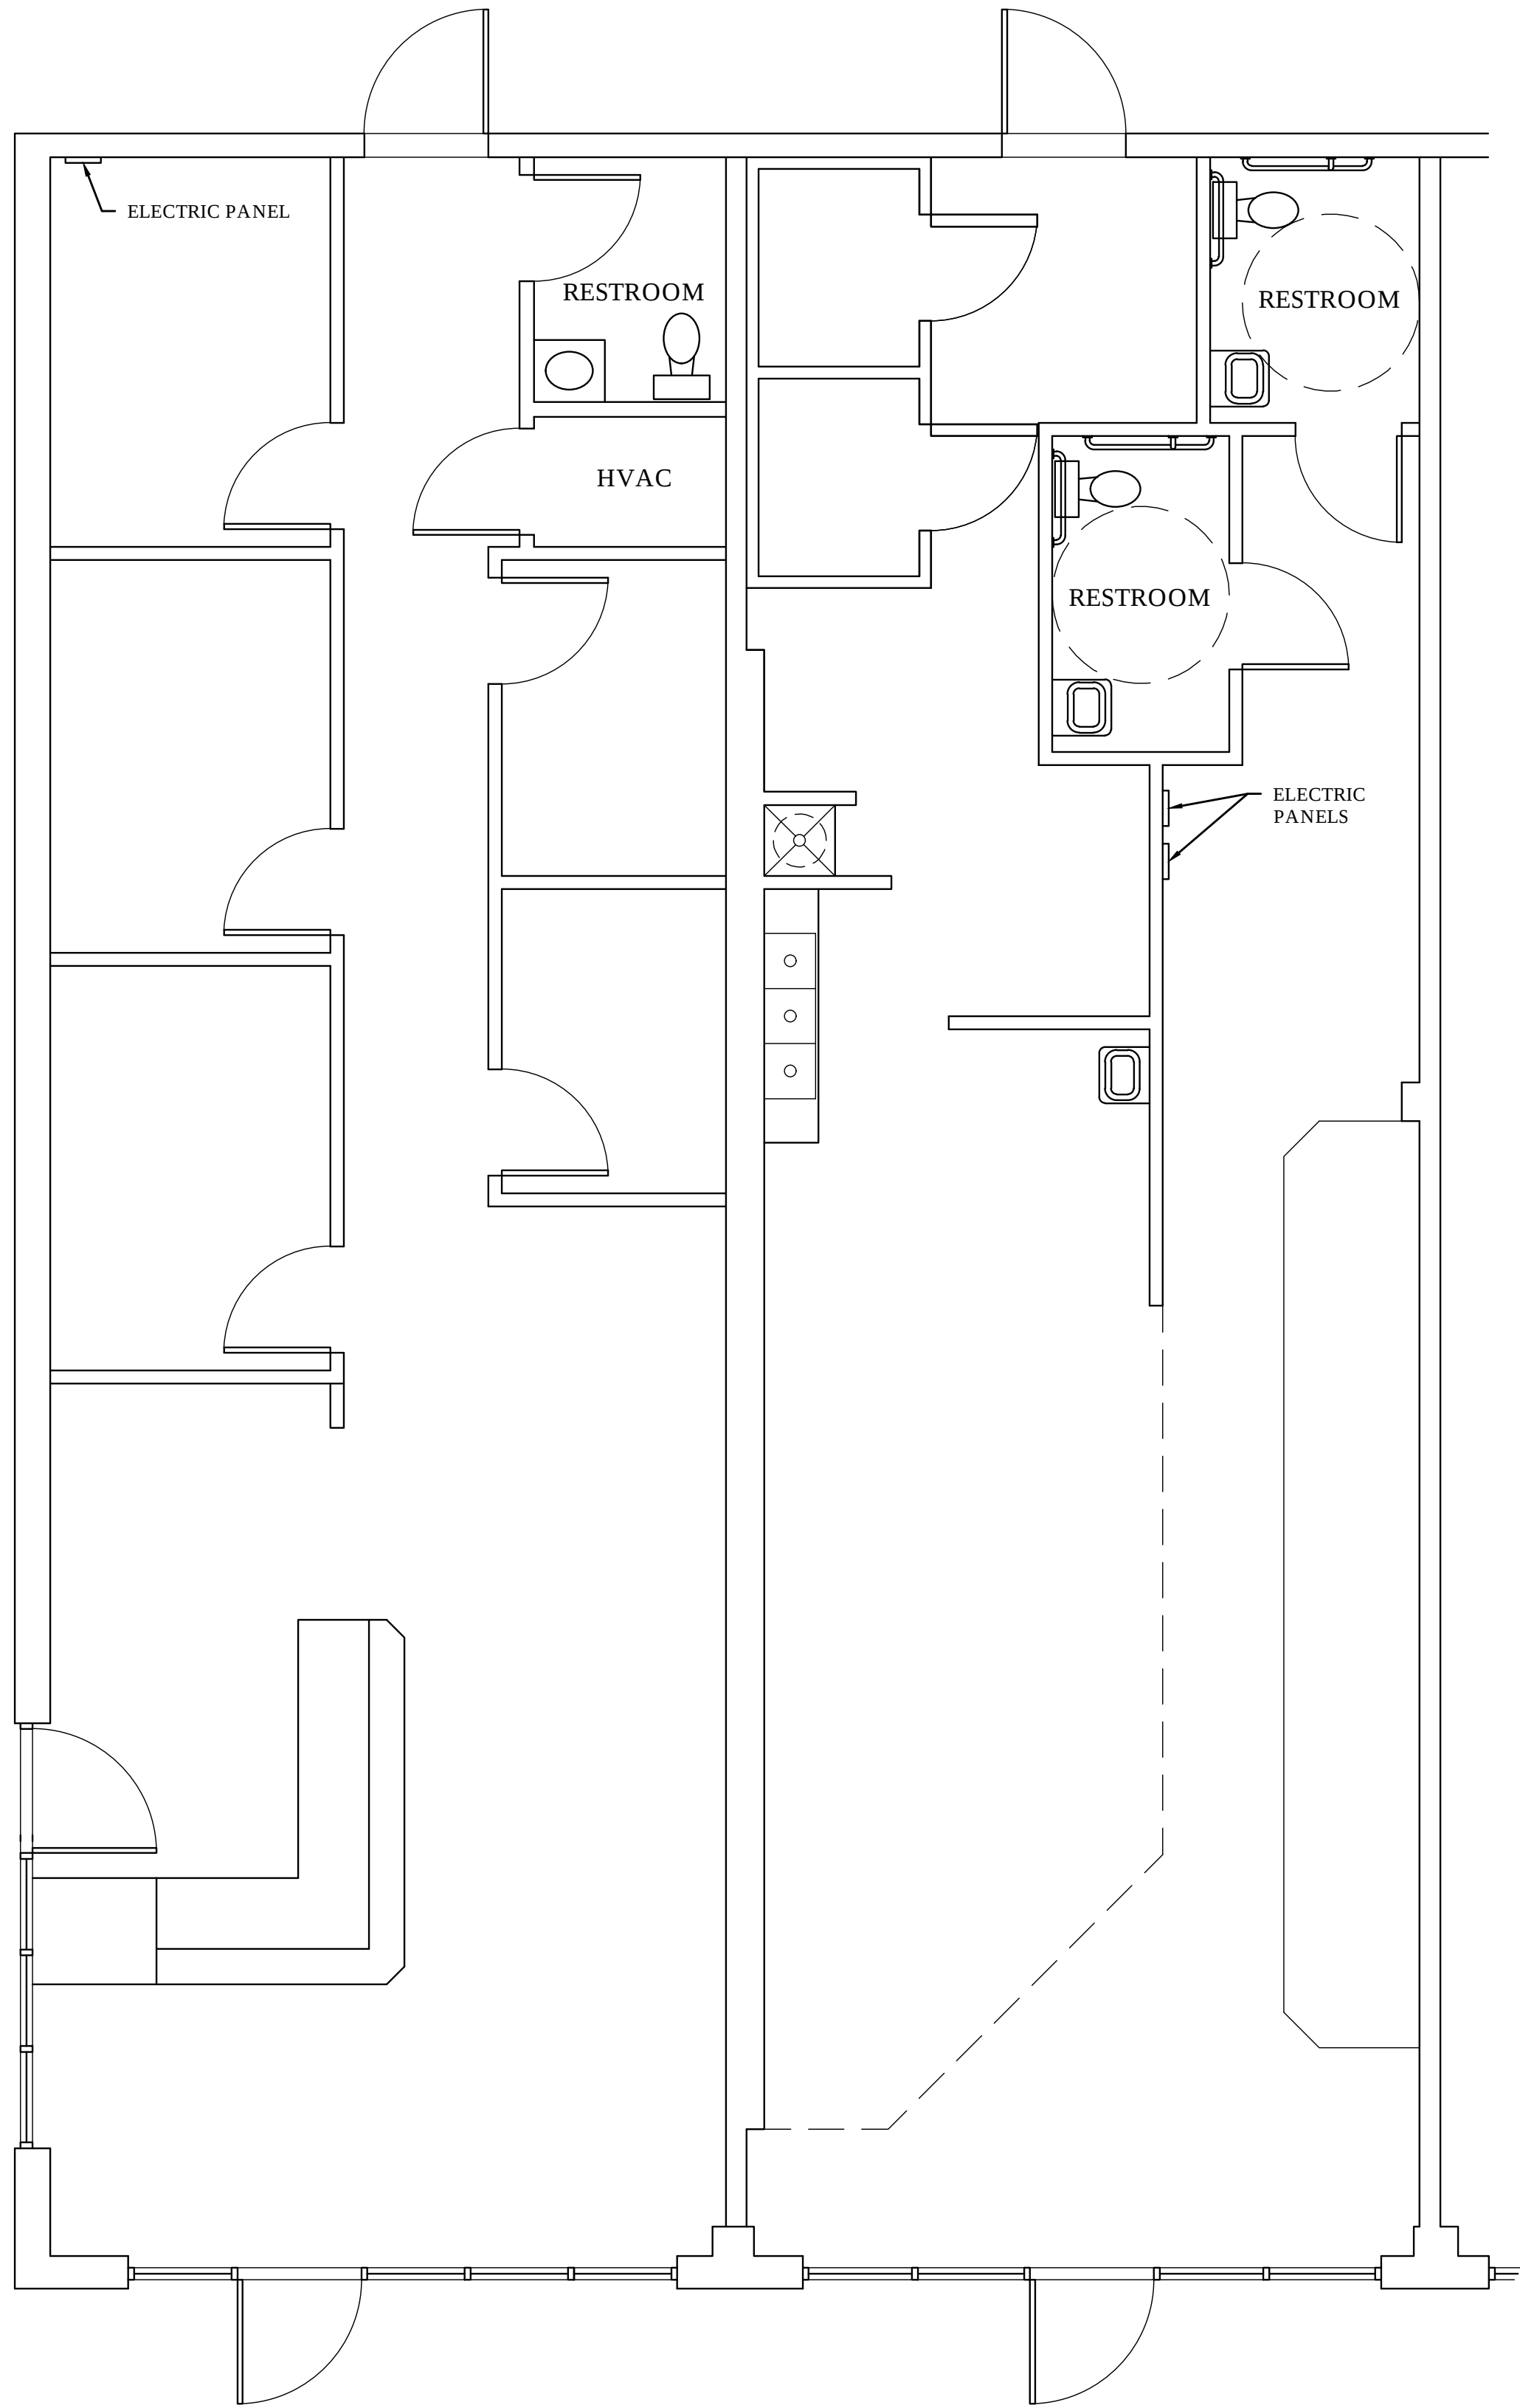

1 FLOOR PLAN
SCALE: 1/4"=1'-0" 

SUSAN STOUT ARCHITECT, LLC
6655 AUTUMN OAKS DR.
OLIVE BRANCH, MS 38654
901.598.2321
sstoutarch@yahoo.com
SUSAN STOUT, AIA

AS-BUILT FLOOR PLAN FOR:
316-320 GOODMAN ROAD EAST
SOUTHAVEN, MISSISSIPPI

FLOOR PLANS

Client:
Joe Poppenheimer Management

Project Number: 25003

Date: January 26, 2025

Revisions		

A1.1