


361 Brannan Street , San Francisco, CA

1. FIRST FLOOR PLAN 
 3/16" = 1'-0"


PLEASE BE ADVISED THAT THE AS-BUILT PLANS PROVIDED HEREIN ARE APPROXIMATE AND FOR REFERENCE ONLY. A PROFESSIONAL SURVEYOR SHOULD BE HIRED TO CONDUCT A SURVEY OF EXISTING CONDITIONS, WHERE ABSOLUTE ACCURACY IS REQUIRED.

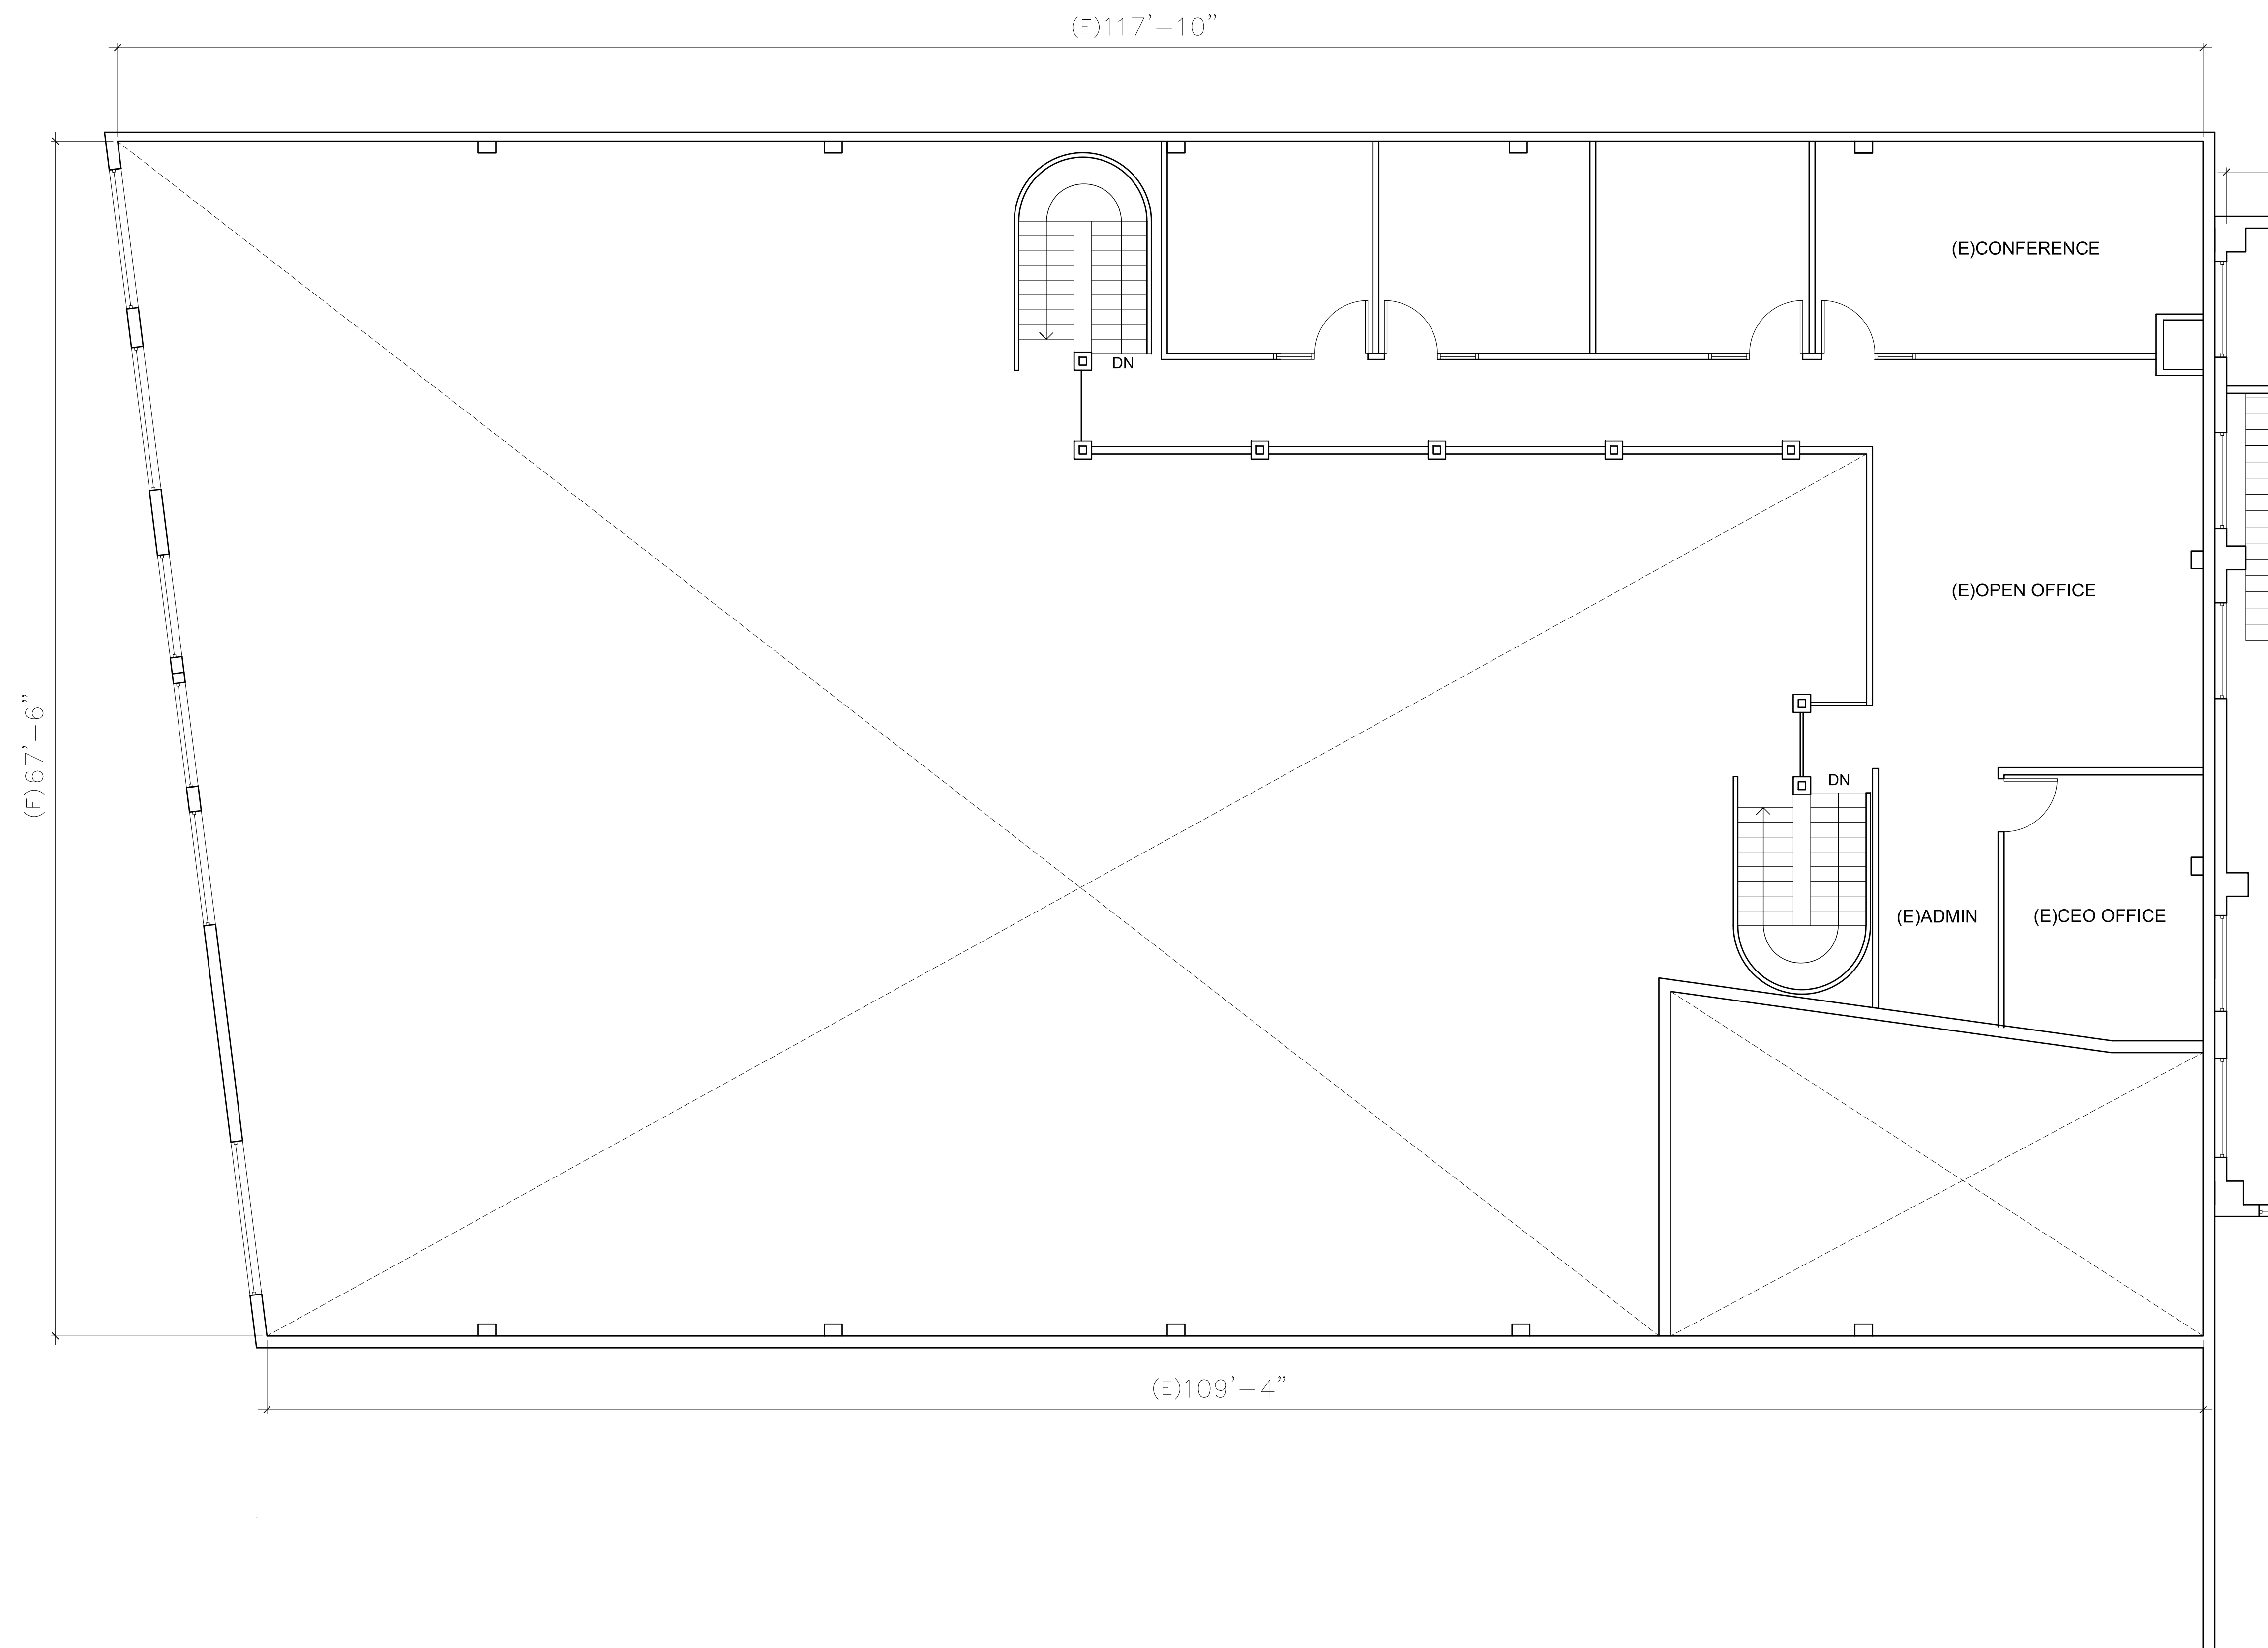

361 Brannan Street , San Francisco, CA

1. SECOND FLOOR PLAN 
 3/16" = 1'-0"


PLEASE BE ADVISED THAT THE AS-BUILT PLANS PROVIDED HEREIN ARE APPROXIMATE AND FOR REFERENCE ONLY. A PROFESSIONAL SURVEYOR SHOULD BE HIRED TO CONDUCT A SURVEY OF EXISTING CONDITIONS, WHERE ABSOLUTE ACCURACY IS REQUIRED.

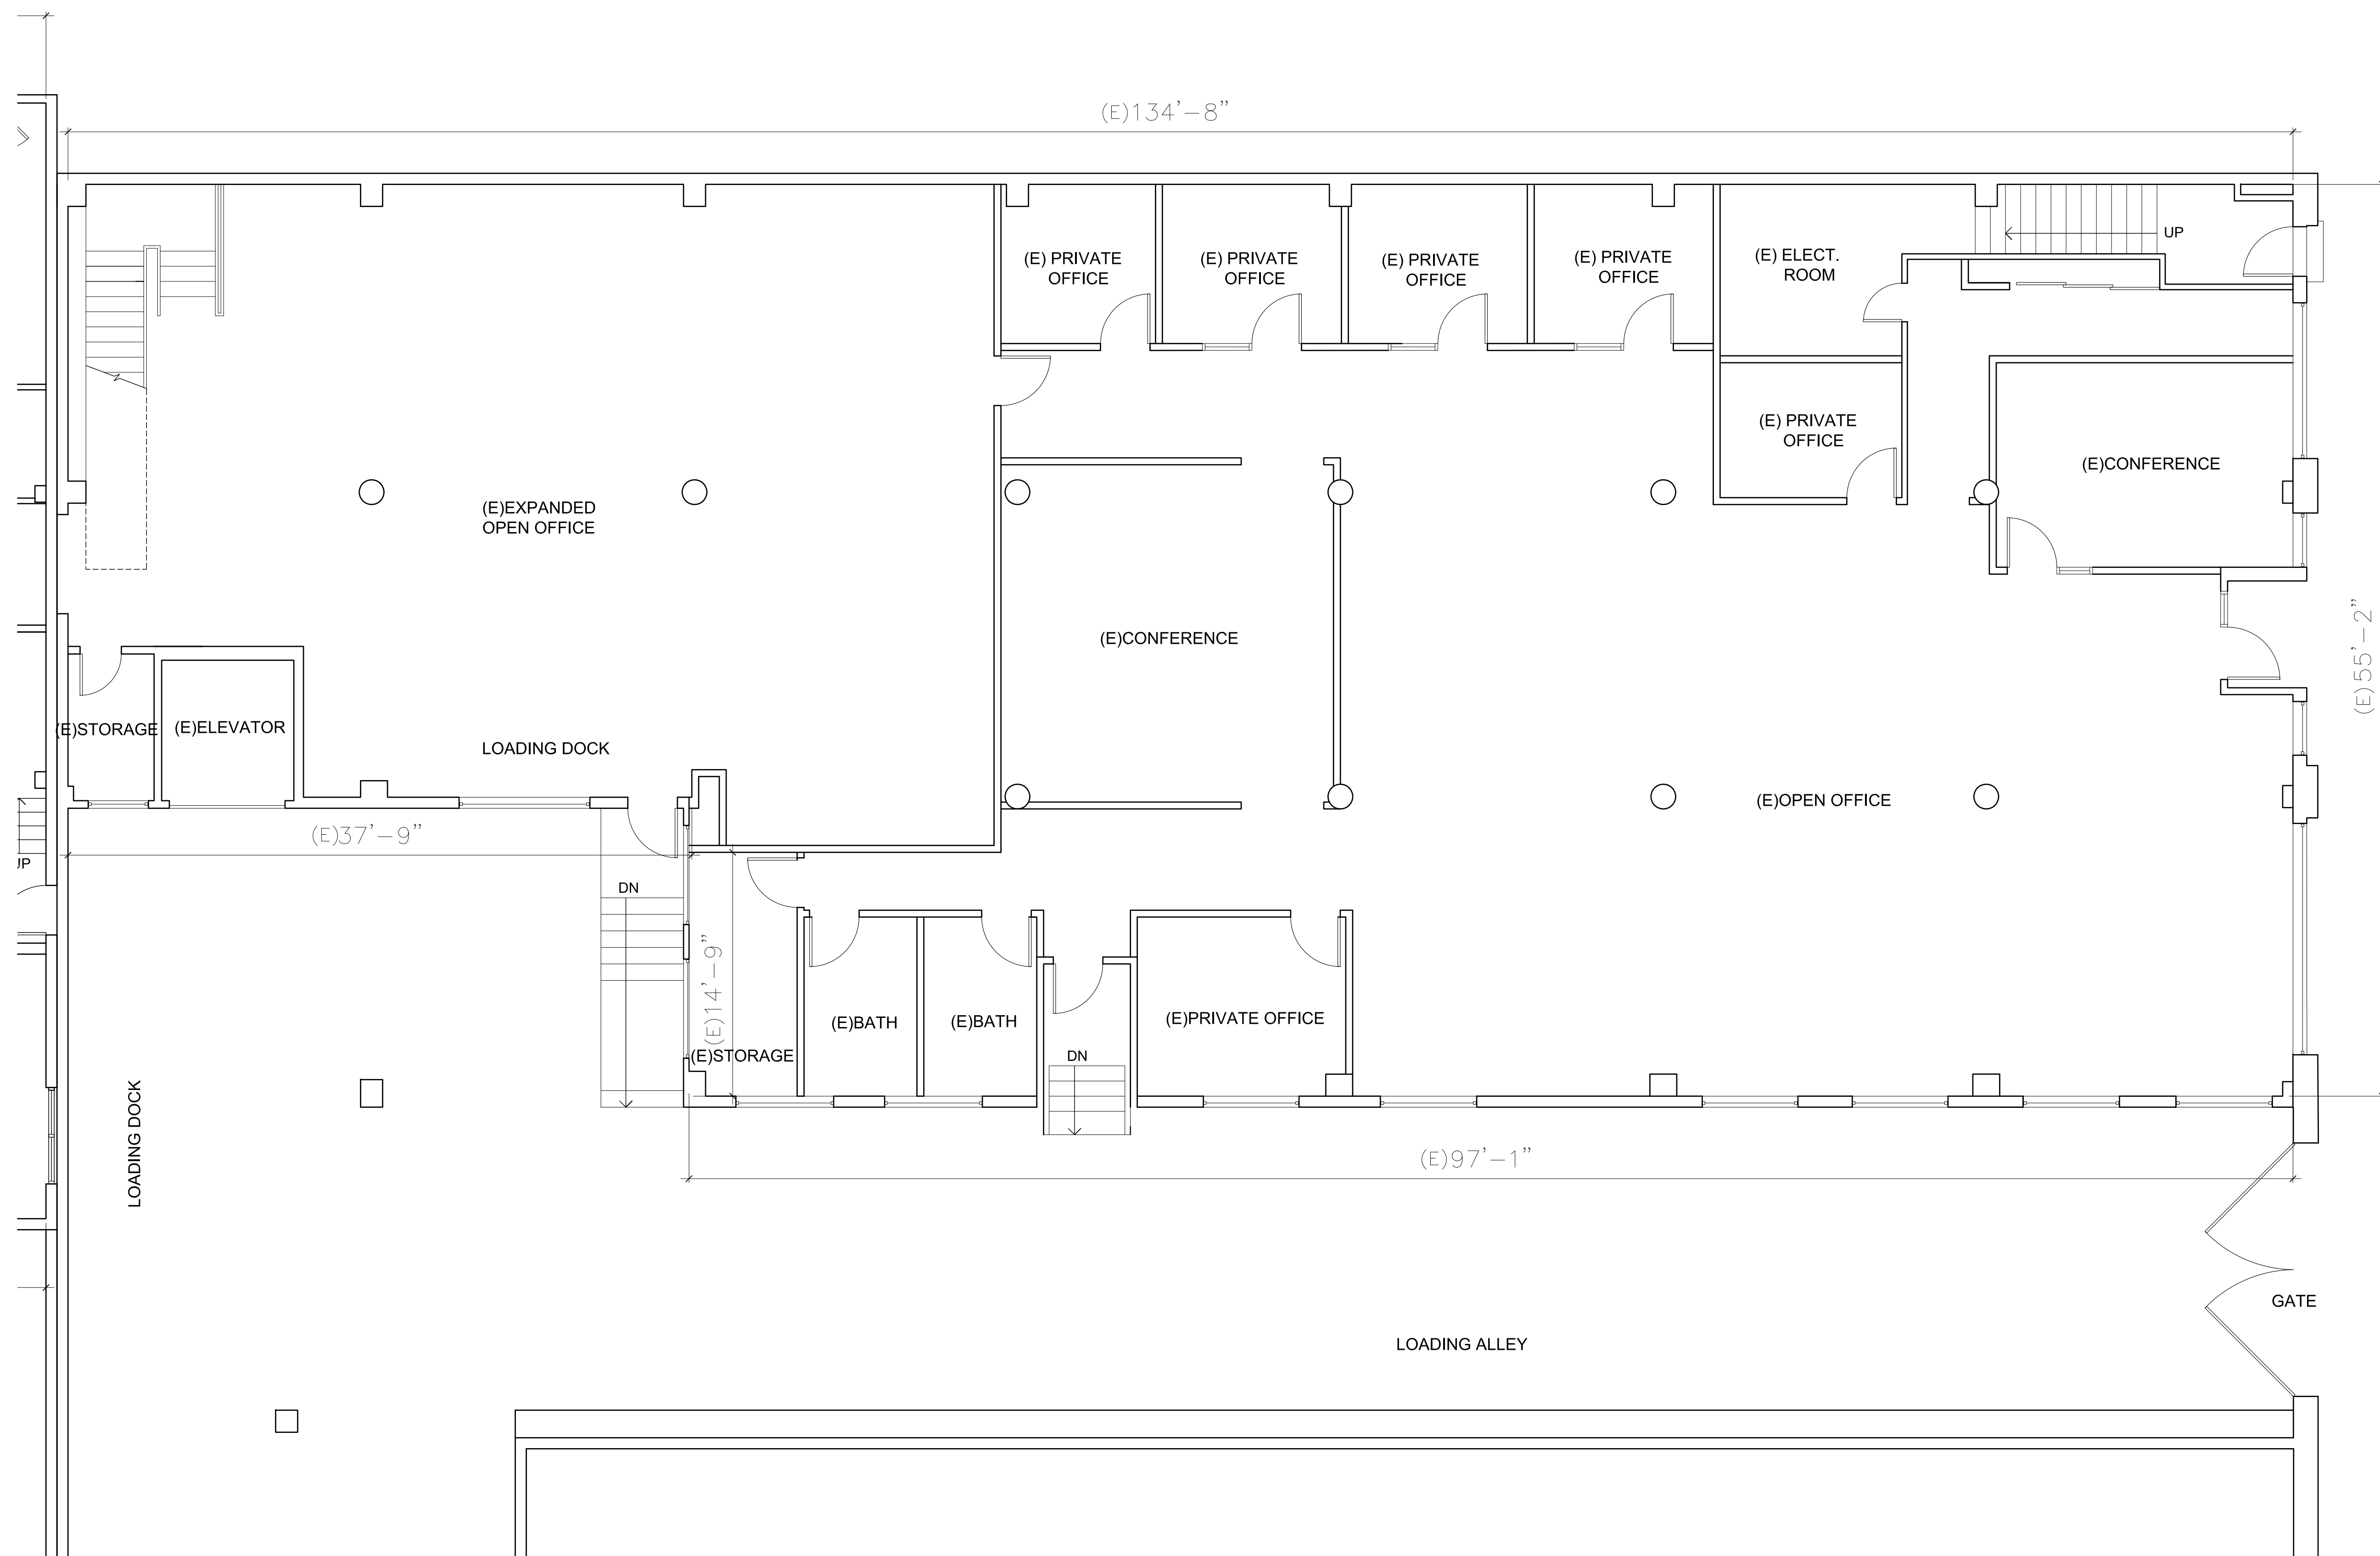

365 Brannan Street , San Francisco, CA

1. FIRST FLOOR PLAN 
 3/16" = 1'-0"

PLEASE BE ADVISED THAT THE AS-BUILT PLANS PROVIDED HEREIN ARE APPROXIMATE AND FOR REFERENCE ONLY. A PROFESSIONAL SURVEYOR SHOULD BE HIRED TO CONDUCT A SURVEY OF EXISTING CONDITIONS, WHERE ABSOLUTE ACCURACY IS REQUIRED.

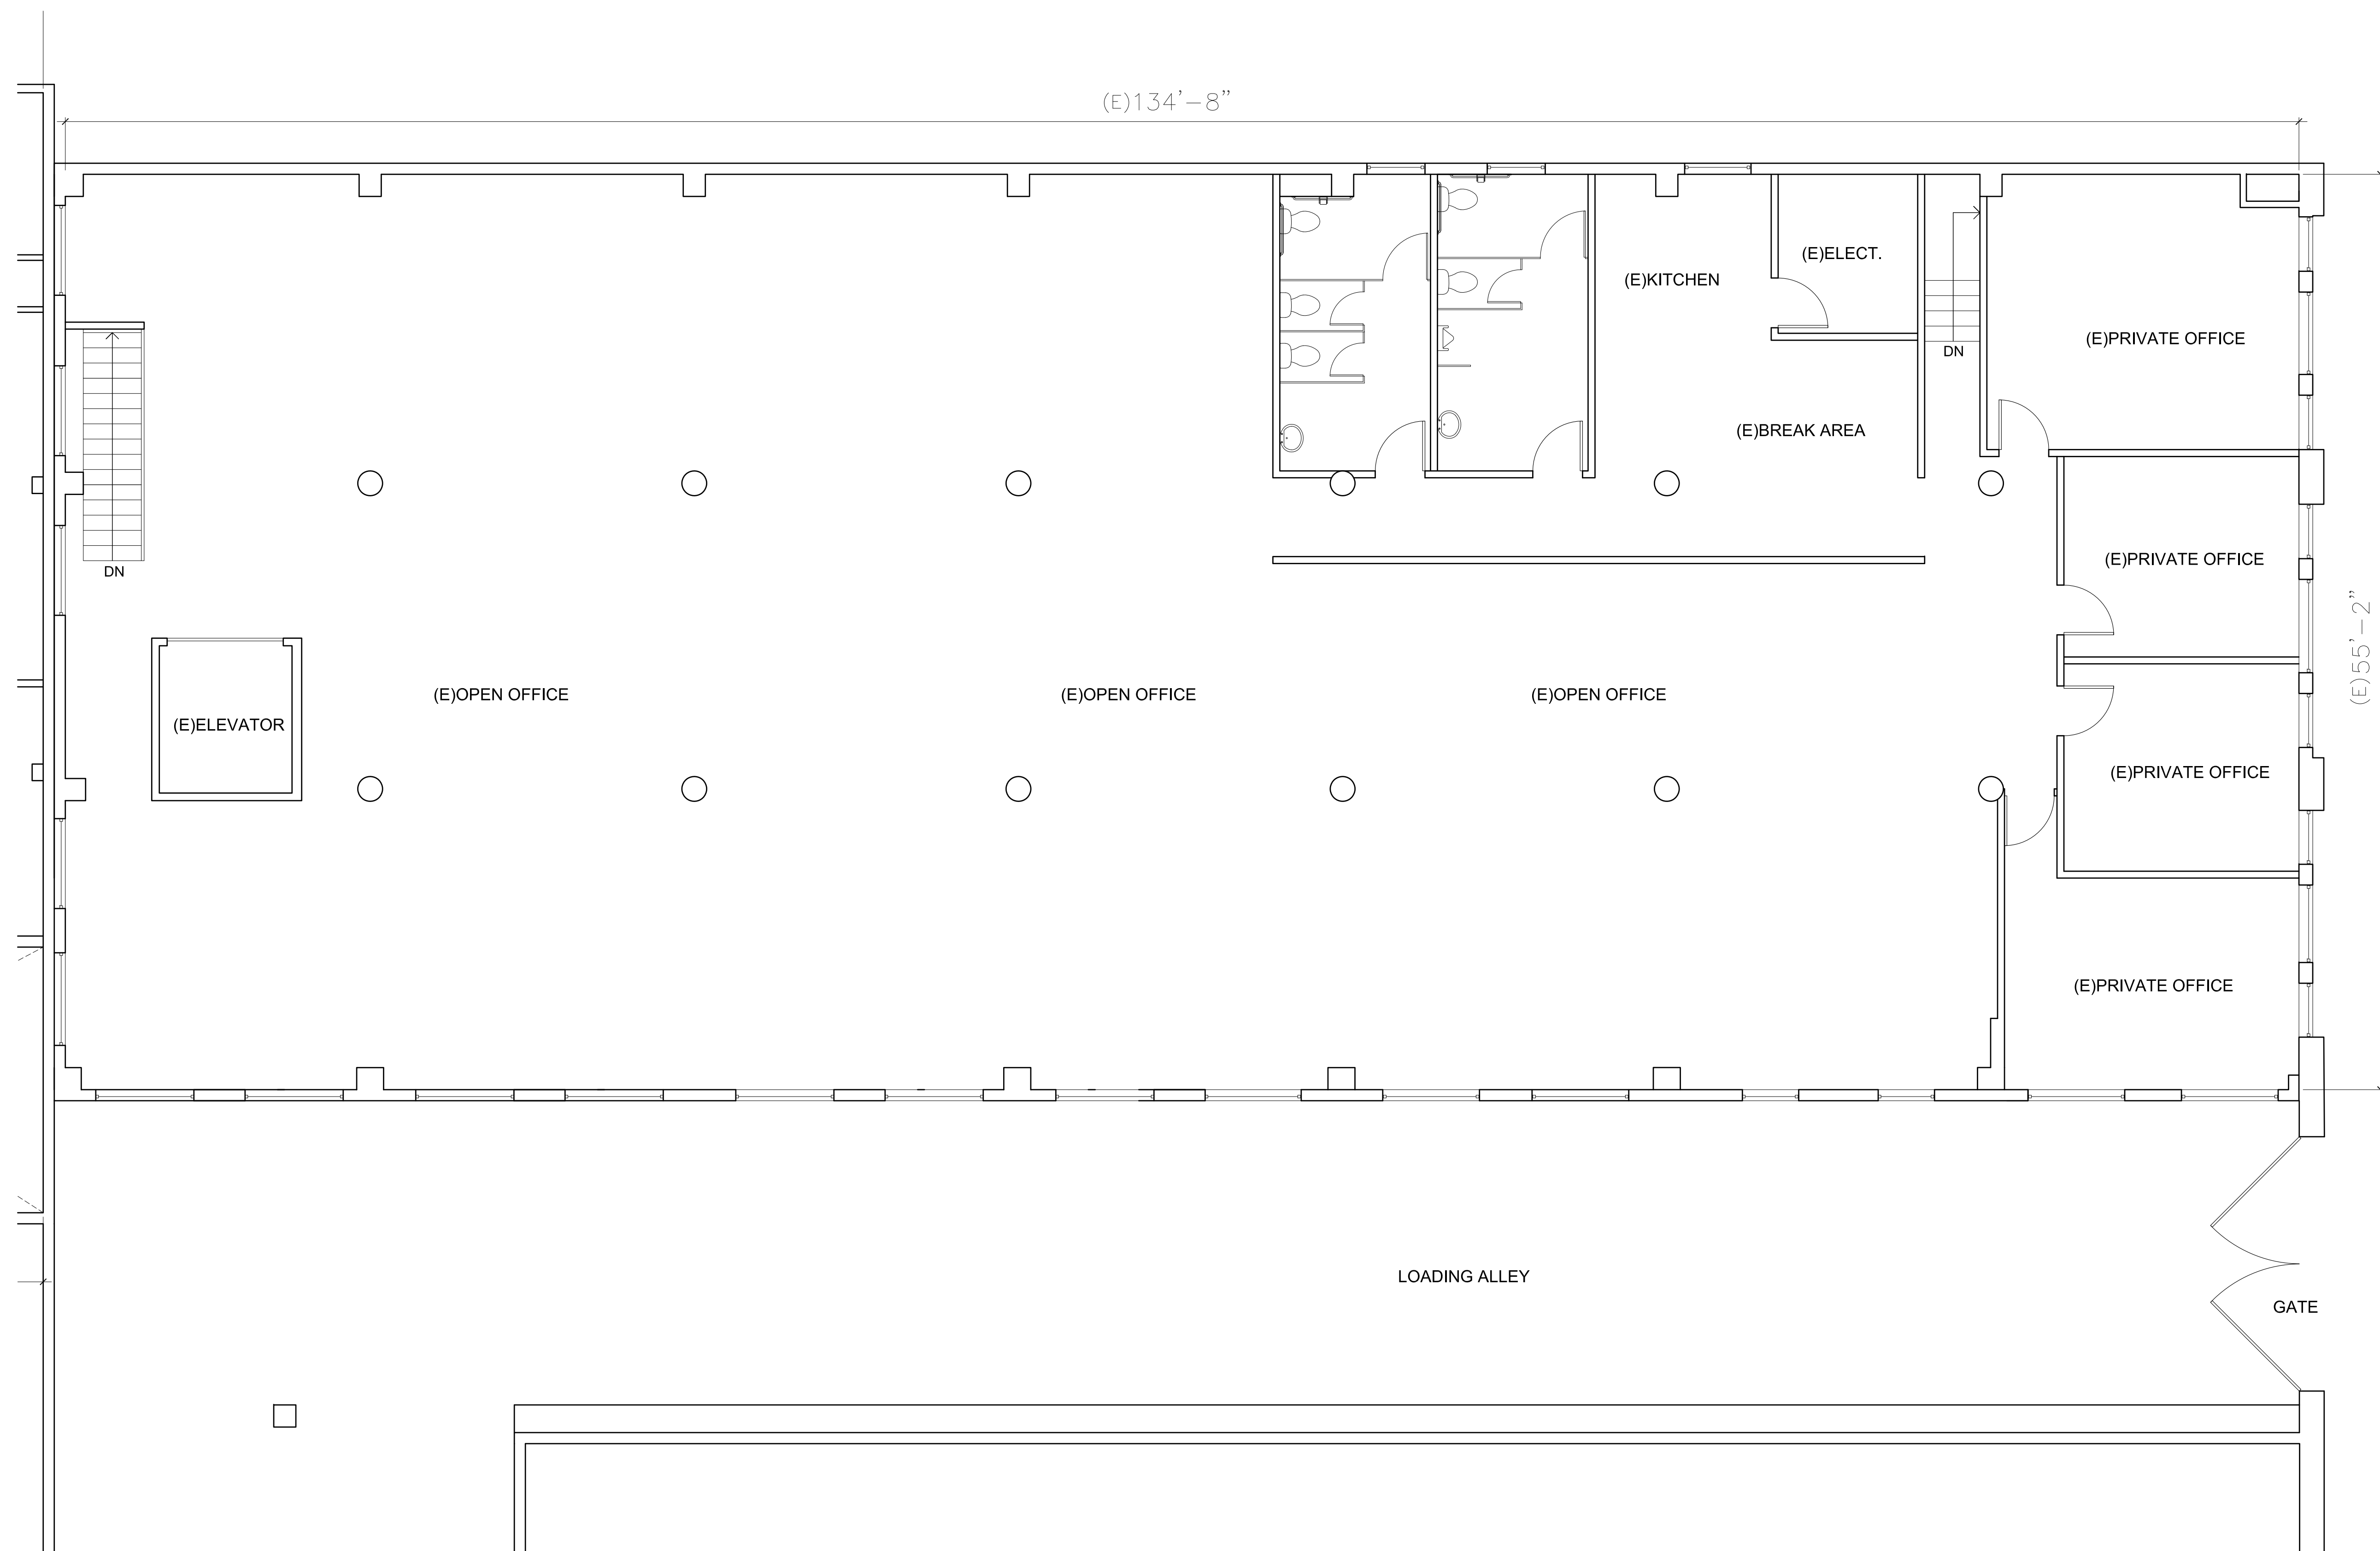

365 Brannan Street , San Francisco, CA

1. SECOND FLOOR PLAN 
 3/16" = 1'-0"

PLEASE BE ADVISED THAT THE AS-BUILT PLANS PROVIDED HEREIN ARE APPROXIMATE AND FOR REFERENCE ONLY. A PROFESSIONAL SURVEYOR SHOULD BE HIRED TO CONDUCT A SURVEY OF EXISTING CONDITIONS, WHERE ABSOLUTE ACCURACY IS REQUIRED.