


# 280 MERRIMACK STREET 5TH FLOOR, SUITE 540

AS BUILT PLAN

## 3,281 SF

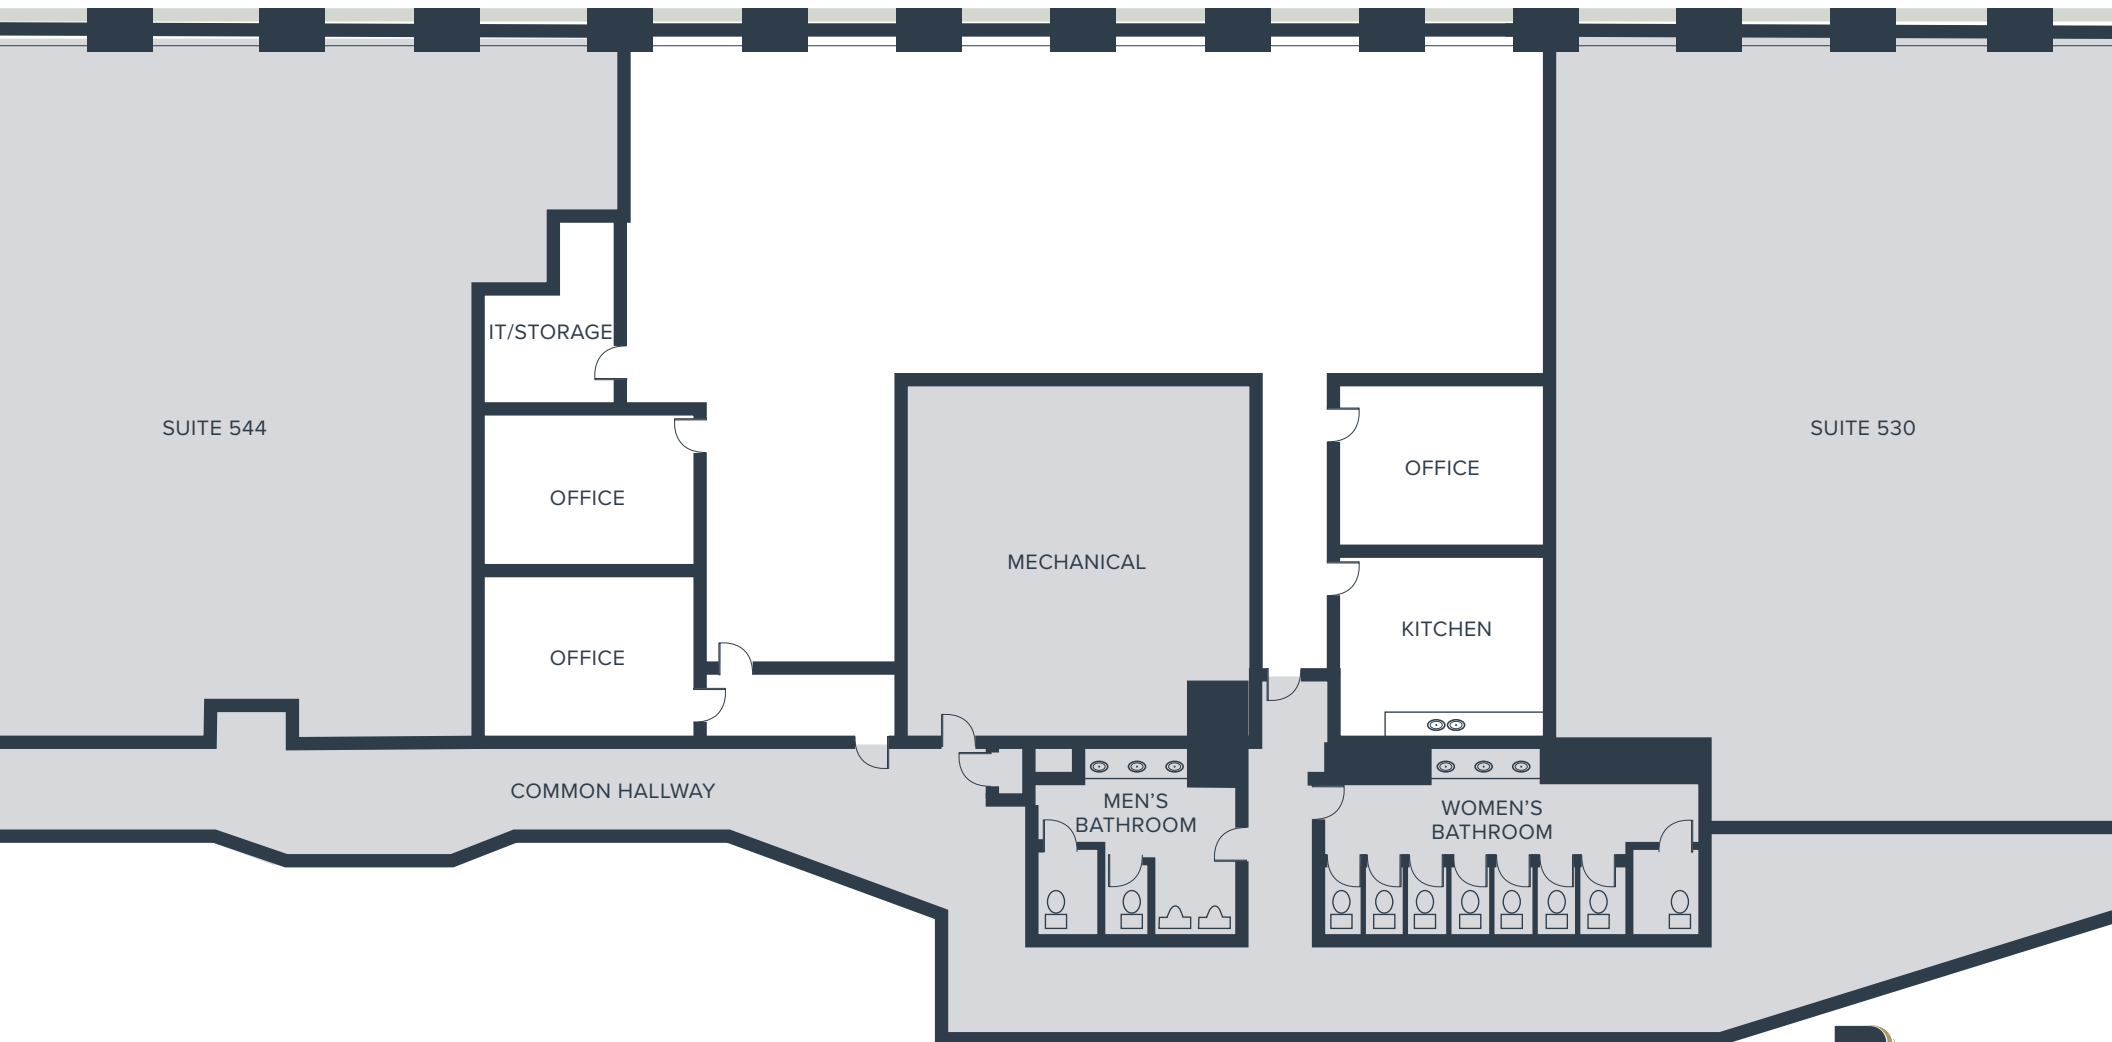

RIVERWALKINNOVATION.COM

978.681.7777

Not to scale. For marketing purposes only.



RIVERWALK  
INNOVATION DISTRICT