


2215 SOLONA ST.
HALTOM CITY, TX

HIGHLIGHTS

- MU-2 Zoning/Heavy Industrial
- Fenced Concrete Yard
- 14' Clear & 16' At Pitch
- 5 Grade Level Doors

AS-BUILT

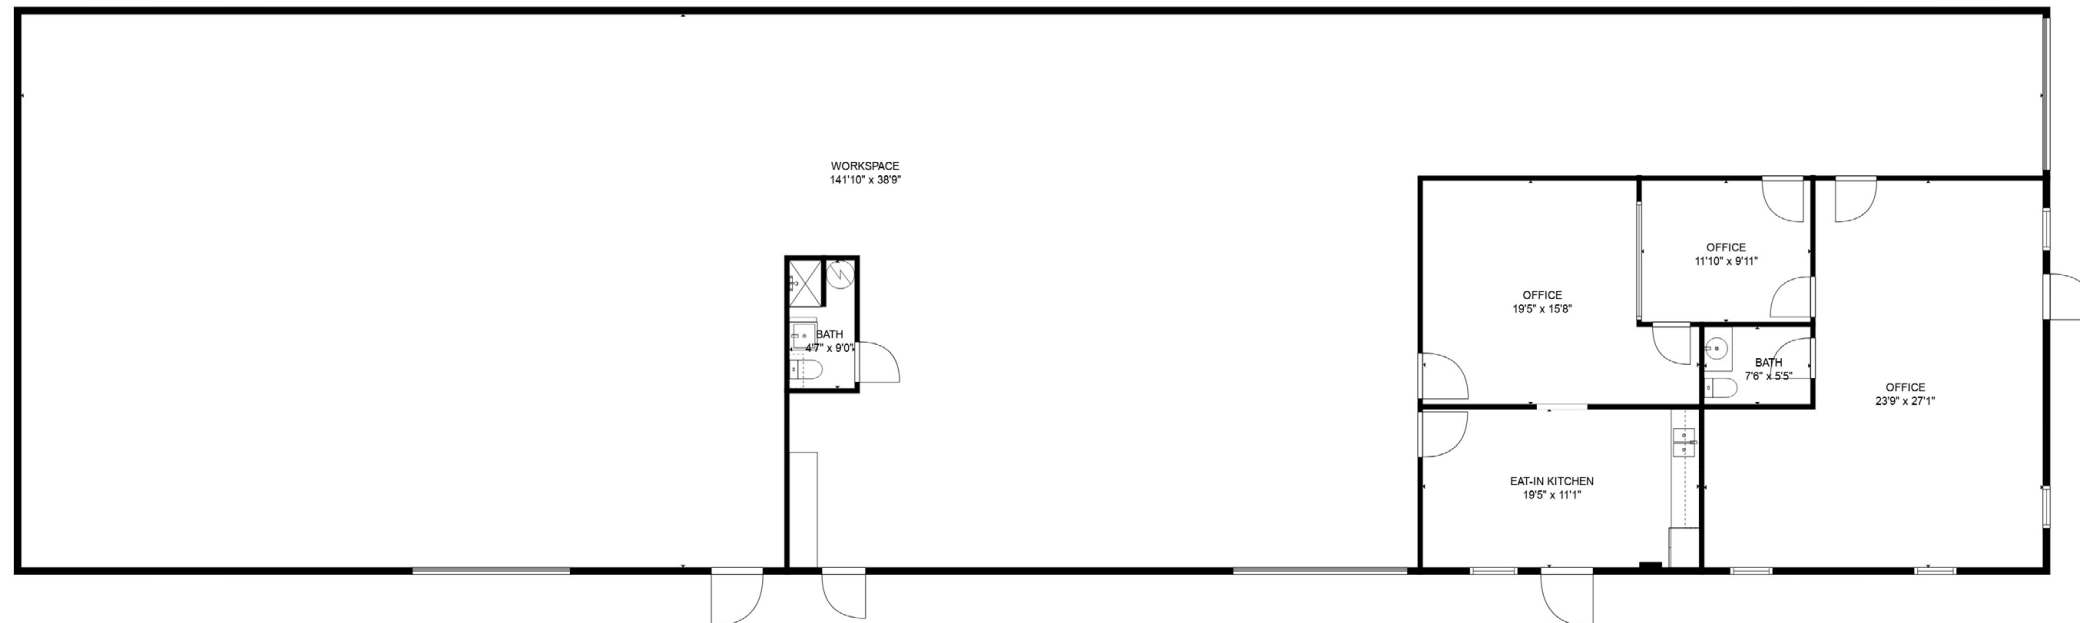

2215 Solona St,
Haltom City, TX 76117

SQUARE FOOTAGE:
6,750 SF

LAND:
15,040 SF

THEO THOMPSON - 817.966.0506 | THOMPSONTGT@GMAIL.COM