

Commercial Office Space for Lease

ELLIOTT COURT

2107 ELLIOTT AVE, SEATTLE

SUITE #310 AVAILABLE

- 1,651 sf
- \$35/sf fully serviced, net of electric (tenant pays electric)
- Unobstructed views of Puget Sound
- Suite contains bathroom, shower, and kitchenette
- Air conditioned
- Secure underground parking available
- Beautiful courtyard entry
- 1 block to Pike Place Market and Seattle waterfront
- Option to combine with adjacent Suite 309 (1,178 sf)





Allegra Properties
DEVELOPMENT • MANAGEMENT • INVESTMENT

Allegra Properties
88 Lenora St
Seattle, WA 98121
www.allegraproperties.com

Contact:
Boris Castellanos
206.812.7812
boris@allegraproperties.com

ELLIOTT COURT



2107 ELLIOTT AVE, SEATTLE

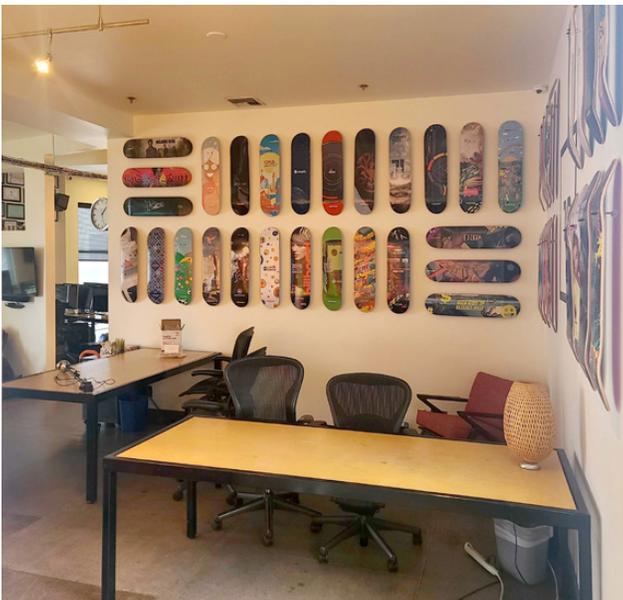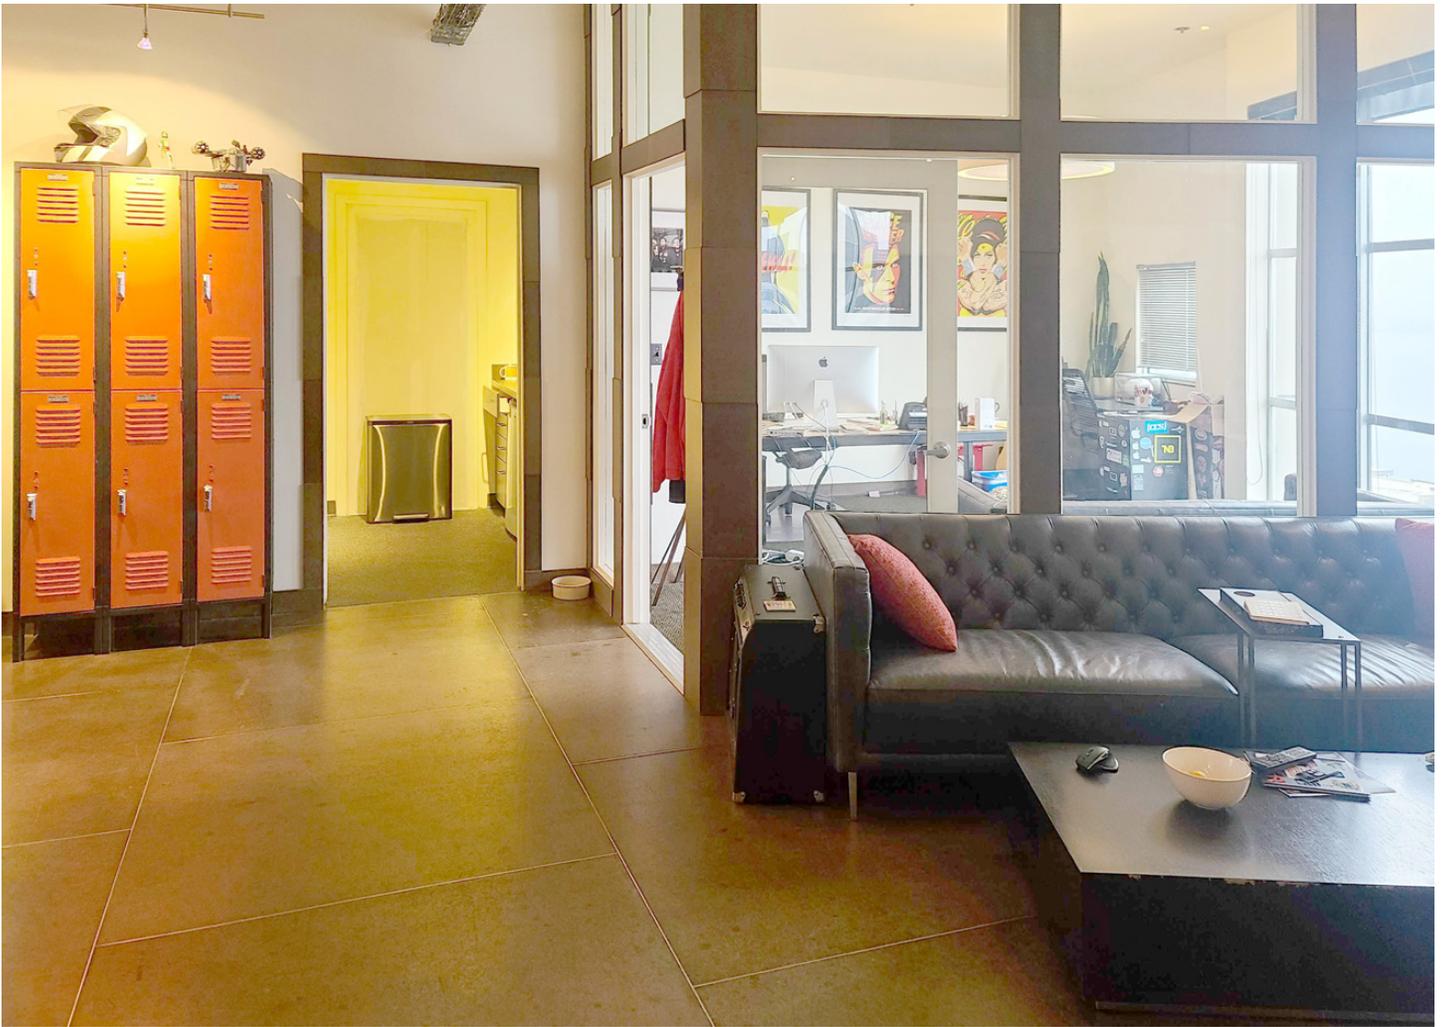


ELLIOTT COURT

2107 ELLIOTT AVE, SEATTLE



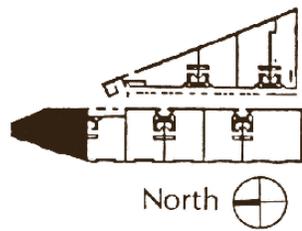
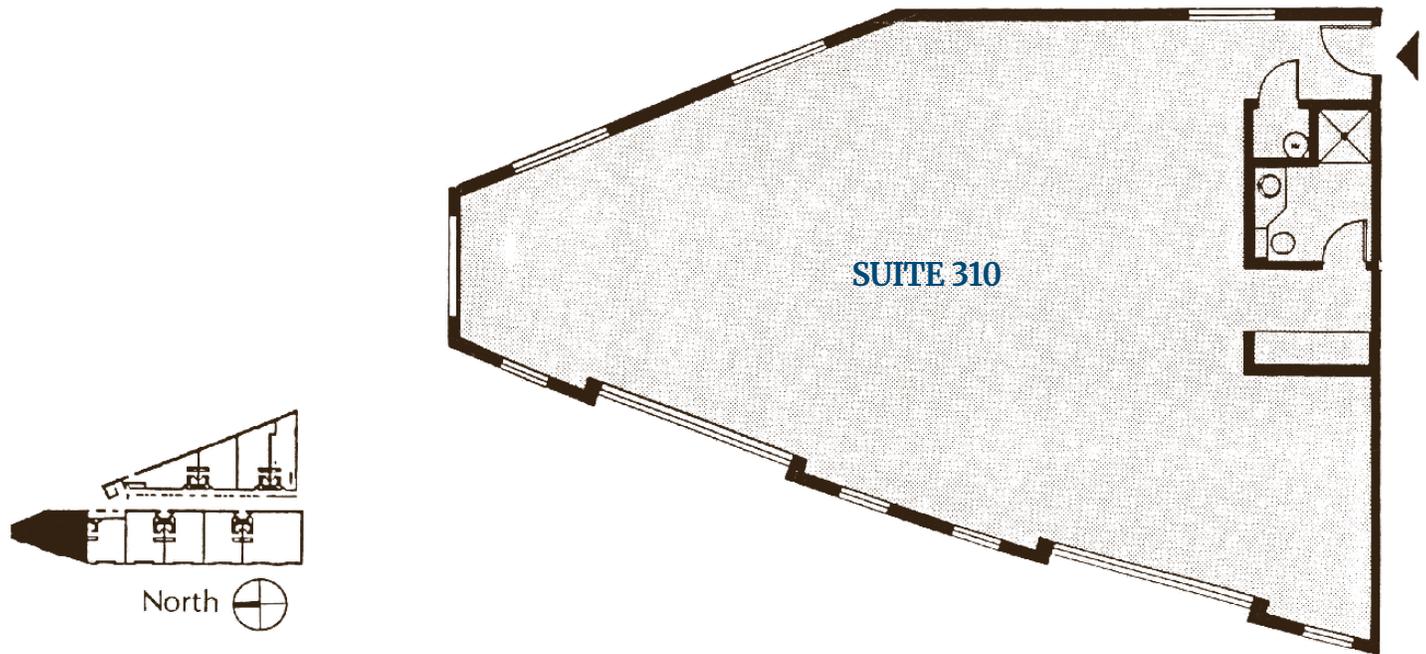


Floor Plan

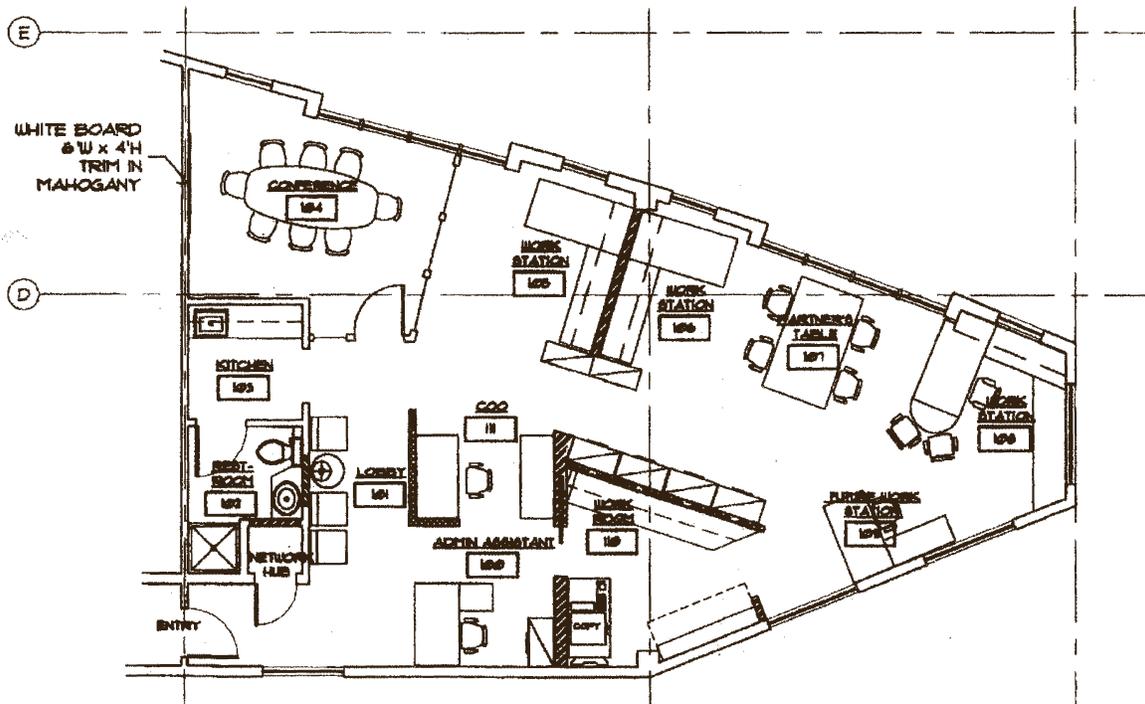

As Built

Option available to combine with adjacent Suite 309

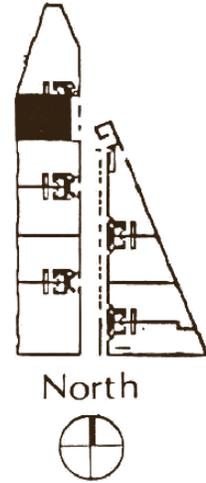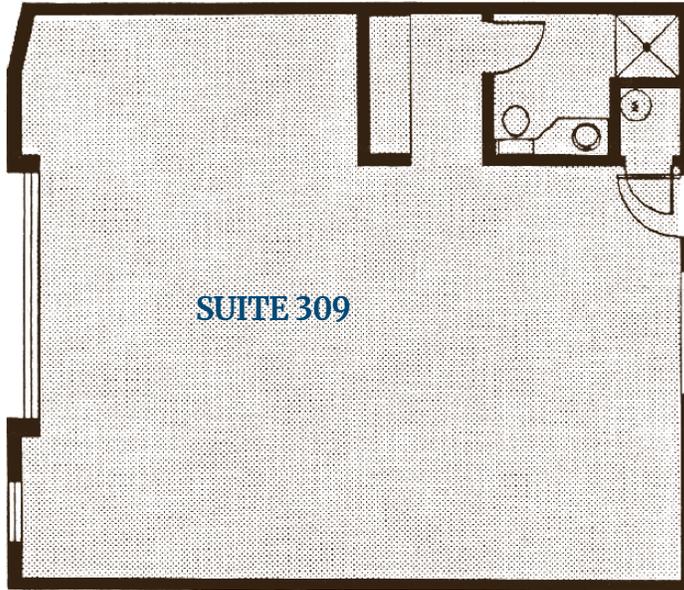

Floor Plan

As Built

