
 


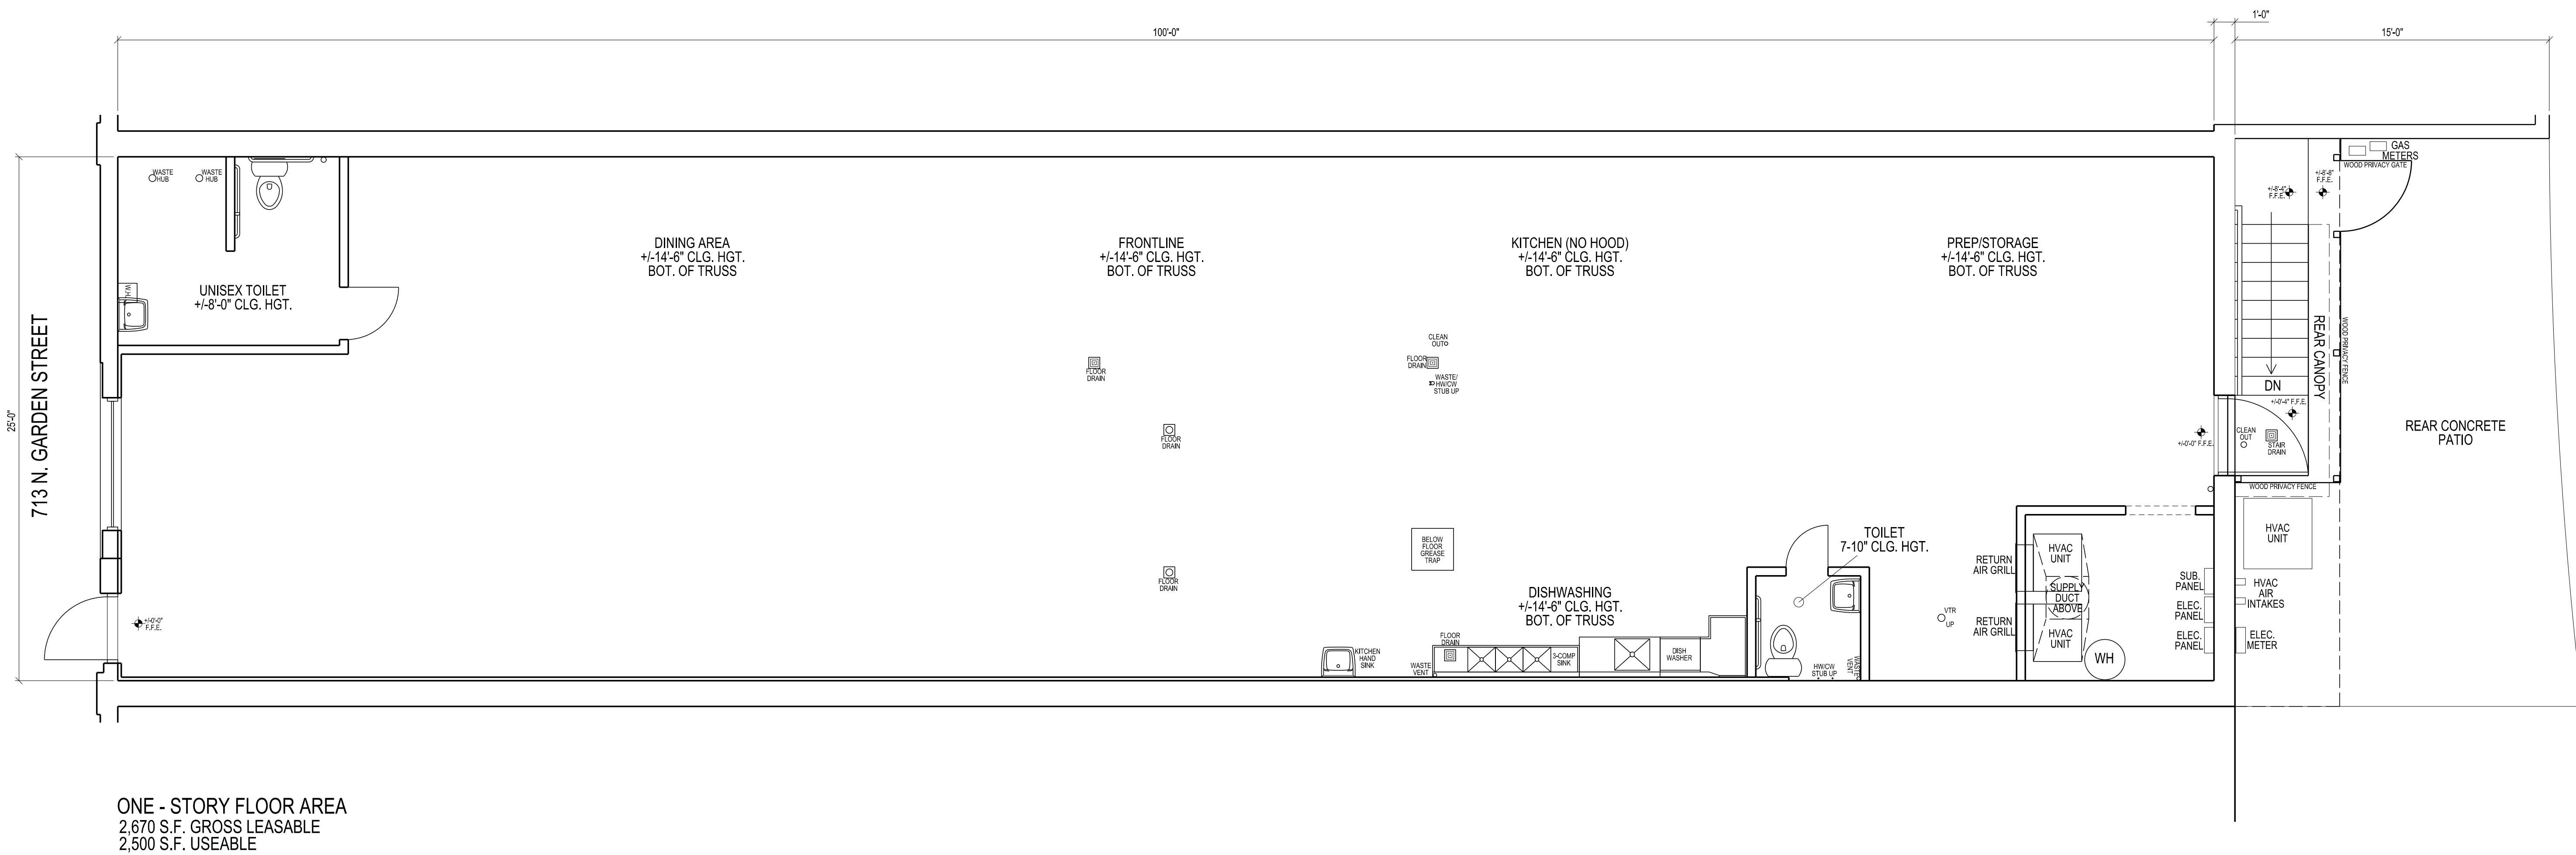

ONE - STORY FLOOR AREA
2,670 S.F. GROSS LEASABLE
2,500 S.F. USEABLE


1 12-29-2025 FLOOR PLAN
SCALE: 1/4"=1'-0"



Adkisson & Associates, Architects, Inc.

1133 HARDING PIKE., SUITE B10-396 NASHVILLE, TENNESSEE 37205-2891 (615) 351-4427

Existing Downtown Building
713 North Garden Street
Columbia, TN 38401

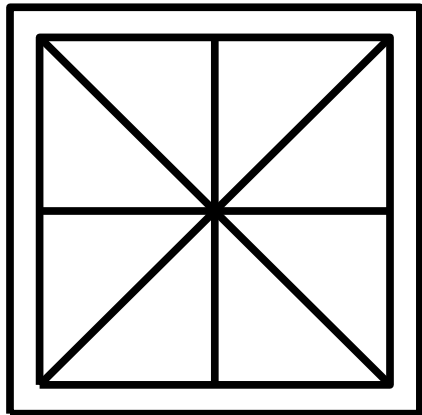

AS-BUILT DOCS
01-05-2026

DATE: 01-05-2026
JOB NO. 2514

SHEET
A-0.1