
## As Built – North Stonington



## As Built – North Stonington

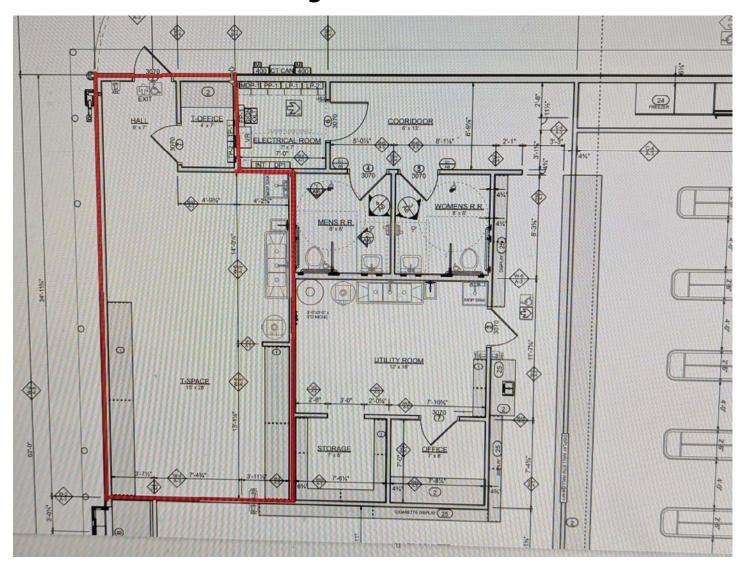