
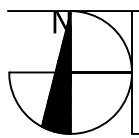


# 3921 East Baseline Road

Gilbert . Arizona

## Suite 111 - 2,527 RSF

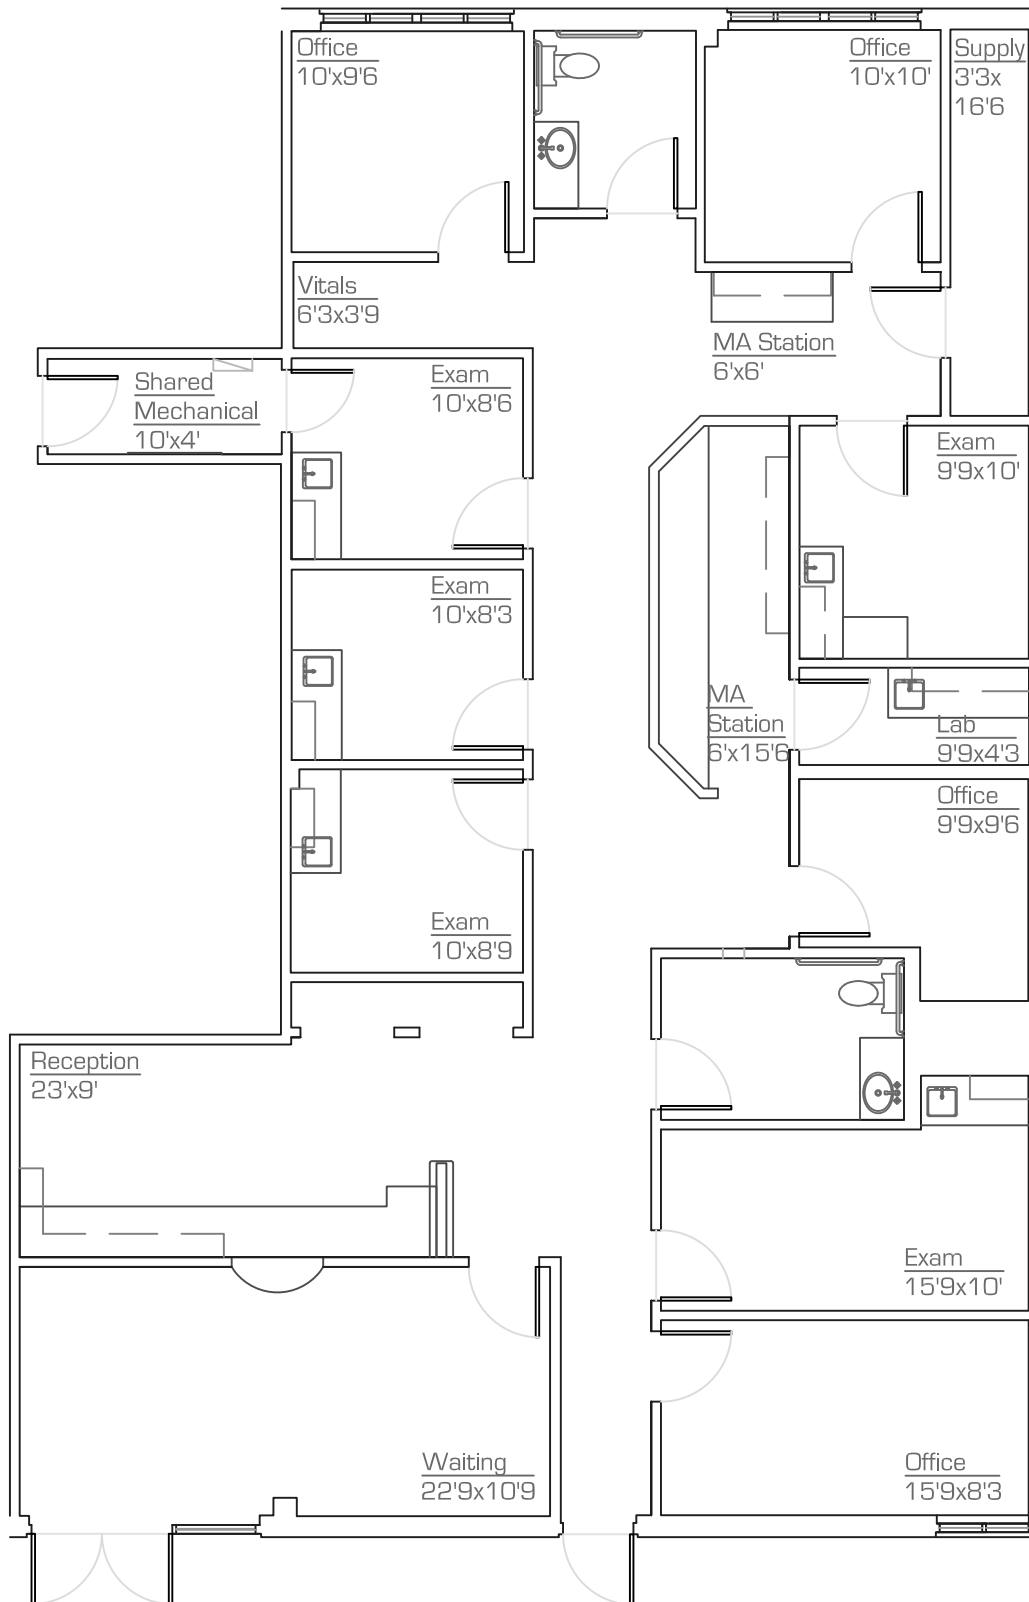

### As-Built

scale: nts

January.2020

\*All dimensions are approximate at ± 3"

\*All information is of general nature

### precisionDIMENSIONS

as-built & design  
602. 790. 6412

