


2250 W. Campbell Park Drive

Chicago, Illinois 60612

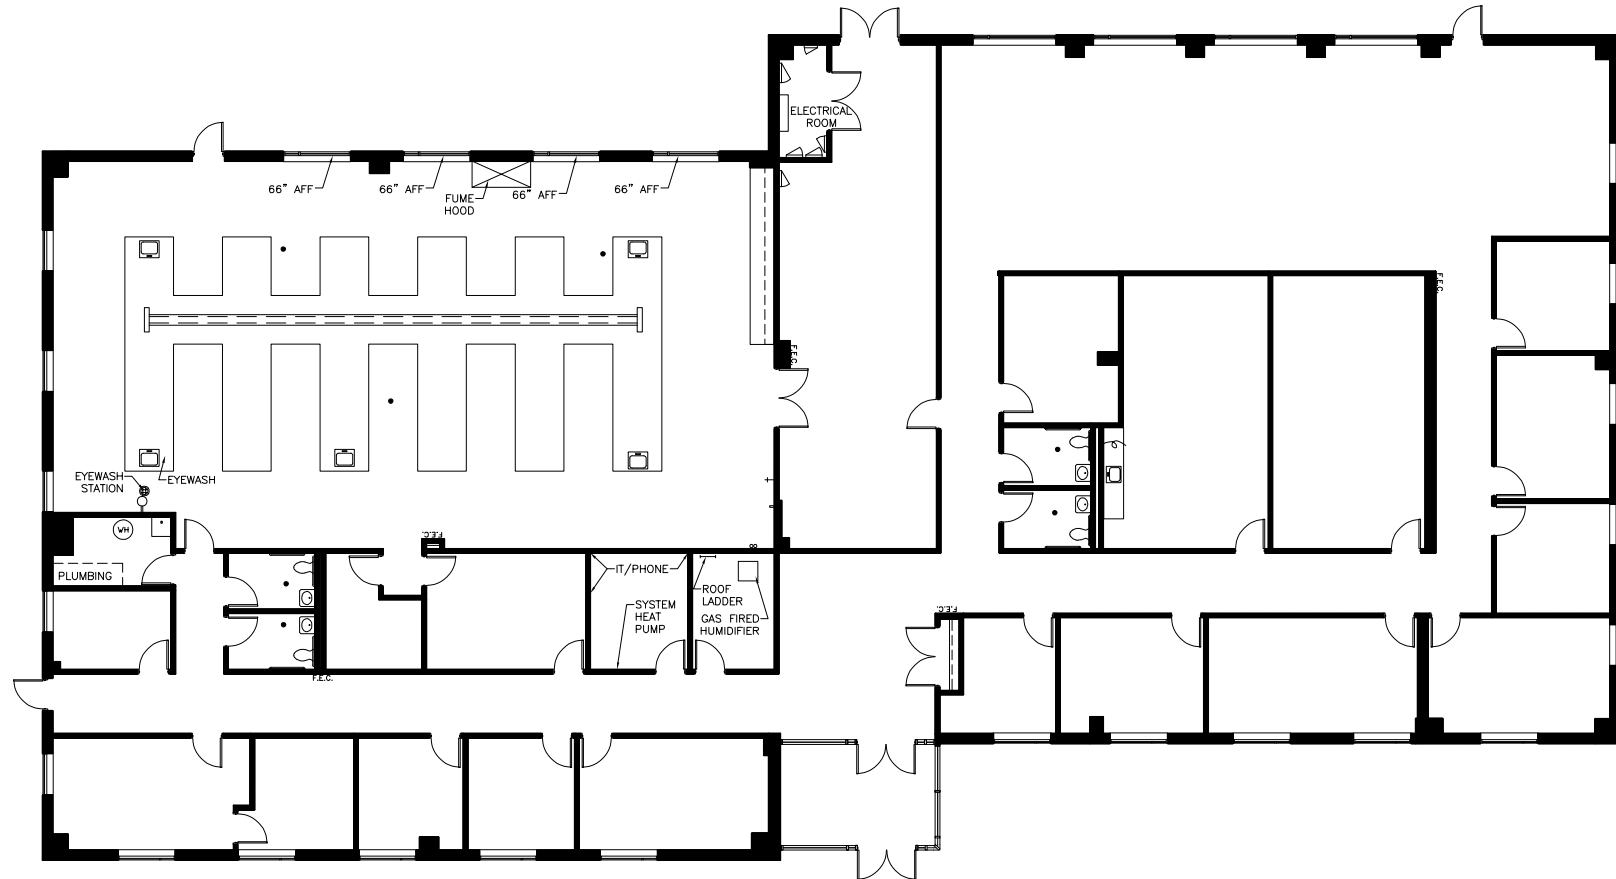

As-Built Conditions

11,900 Rentable Square Feet

Scale:

N.T.S.

