


AREA TABULATION

UNIT 145 LEASABLE SPACE =

3256 S.F.

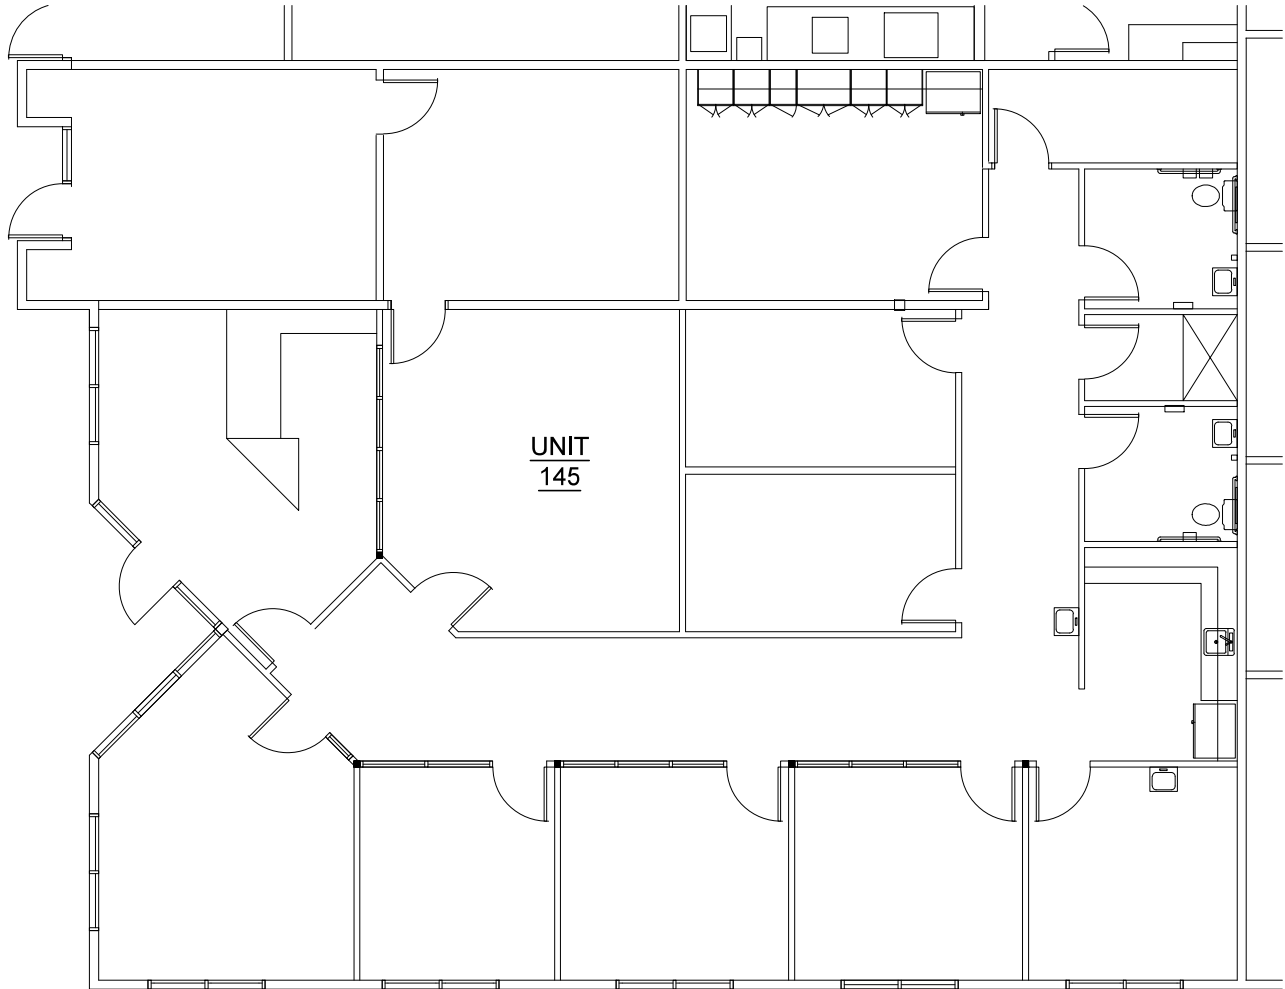

1 UNIT 145 AS-BUILT PLAN
A1.00 SCALE: 3/32" = 1'-0"

#	DATE	DESCRIPTION	PROPERTY OWNER:	PROJECT NAME:	PLOT DATE:
			RENO JONES, LLC	RENO JONES OFFICE SUITES	09-17-2024
			COMPANY ADDRESS: 5052 SOUTH JONES BOULEVARD LAS VEGAS, NEVADA 89118	PROJECT ADDRESS: 5052 SOUTH JONES BOULEVARD LAS VEGAS, NEVADA 89118	PHASE AS-BUILT SUBMITTAL
			COMPANY CONTACT: LOUIS CARNESALE 702-466-0444	PROJECT NUMBER: 002-01-24-002	SHEET NAME AS-BUILT FLOOR PLAN
					SHEET NO. A1.00