

**ITASCA
EXISTING SECOND FLOOR PLAN**

SCALE: N.T.S.





TOTAL SF	5966
COMMON AREA SF	552
LOSS FACTOR	9.30%

Itasca As-Built Floor Plans
 1145 N Arlington Heights Rd - Itasca, IL 60143
 August 18th, 2021 | project 2021-118



charles vincent george
 ARCHITECTS

1245 E. Diehl Rd. Suite 101 • Naperville, IL 60563
 P: 630.357.2023 • F: 630.357.2662

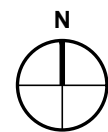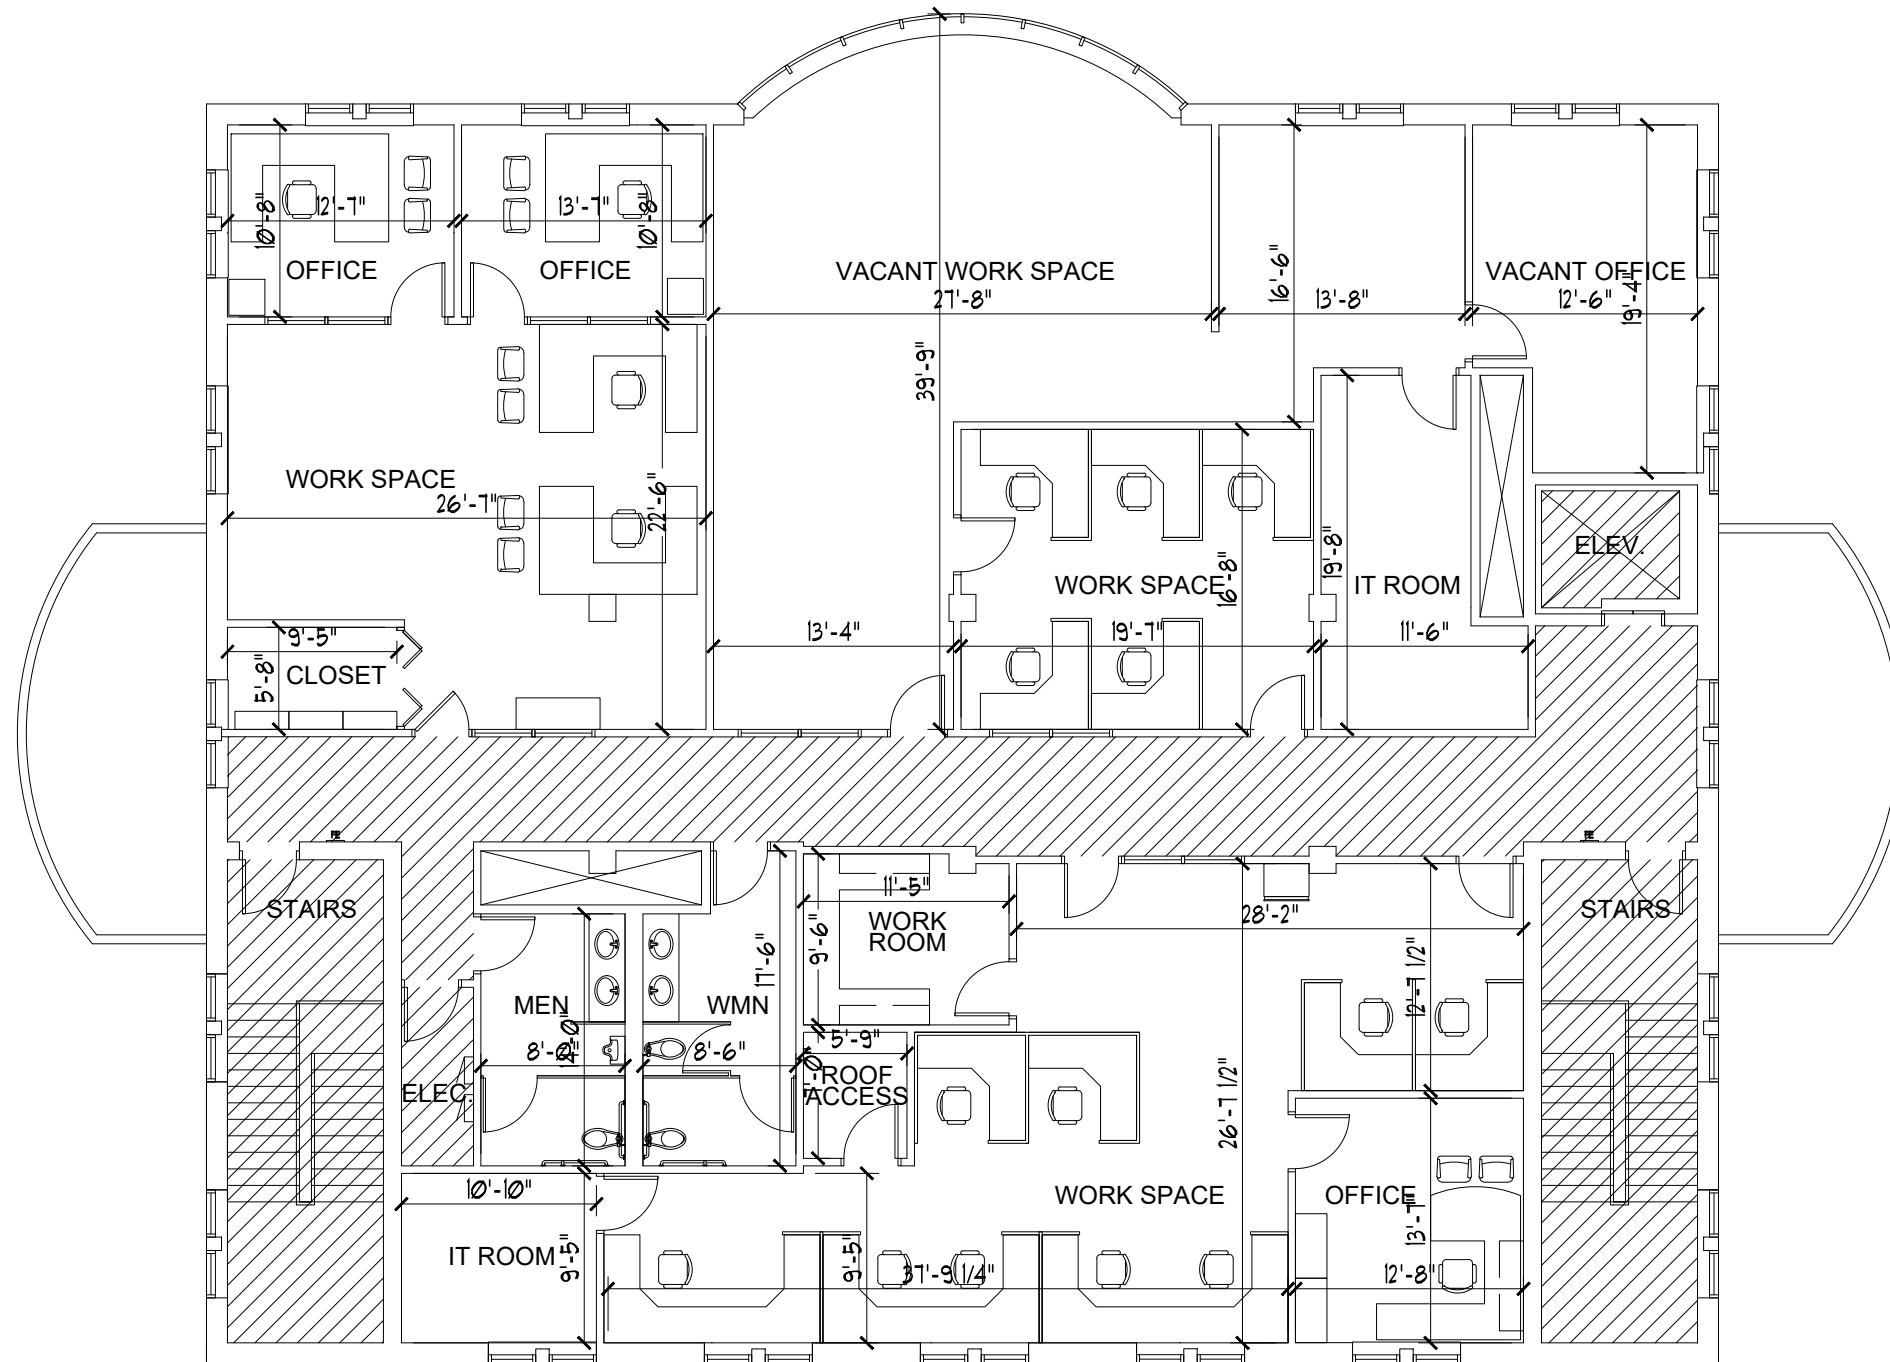

**ITASCA
EXISTING THIRD FLOOR PLAN**

SCALE: N.T.S.



TOTAL SF	5966
COMMON AREA SF	1140
LOSS FACTOR	19.10%

Itasca As-Built Floor Plans
 1145 N Arlington Heights Rd - Itasca, IL 60143
 August 18th, 2021 | project 2021-118



**charles vincent george
ARCHITECTS**

1245 E. Diehl Rd. Suite 101 • Naperville, IL 60563
 P: 630.357.2023 • F: 630.357.2662