 


**1416
EAST 11th
STREET**

SUITE
1


TULSA,
OKLAHOMA

041326



AS-BUILT
PLAN

AS-1

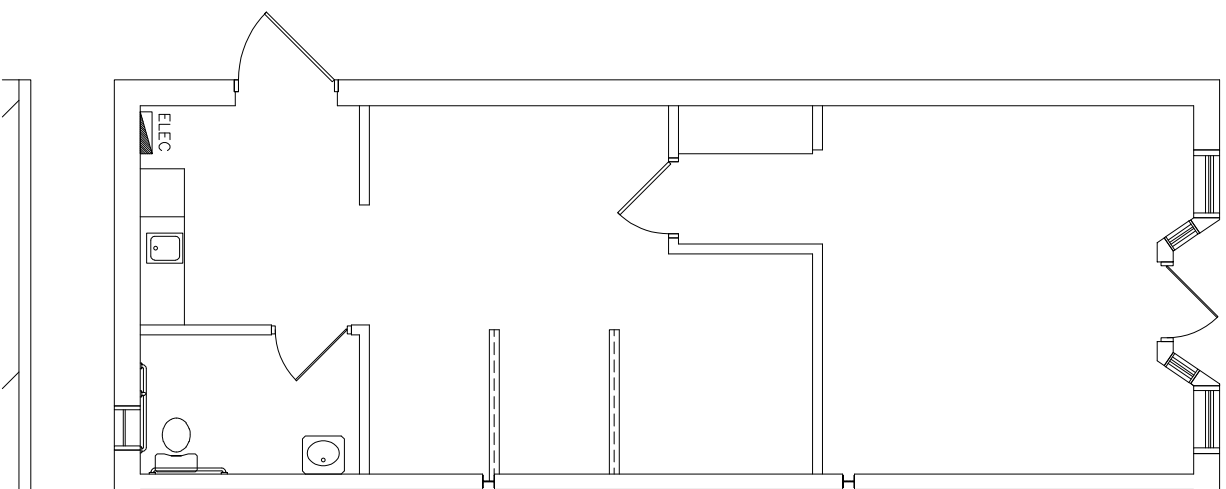

SUITE 1
760.16 U.S.F



A FLOOR PLAN

SCALE: 1/8" = 1'-0"