





 **AS-BUILT FLOOR PLAN**
SCALE: 1" = 20'-0"

☒ PRELIMINARY	01/08/2025
☐ CLIENT APPROVAL	
☐ BIDDING	
☐ PERMIT	
☐ CONSTRUCTION	
☒ REVISIONS	03/18/2025

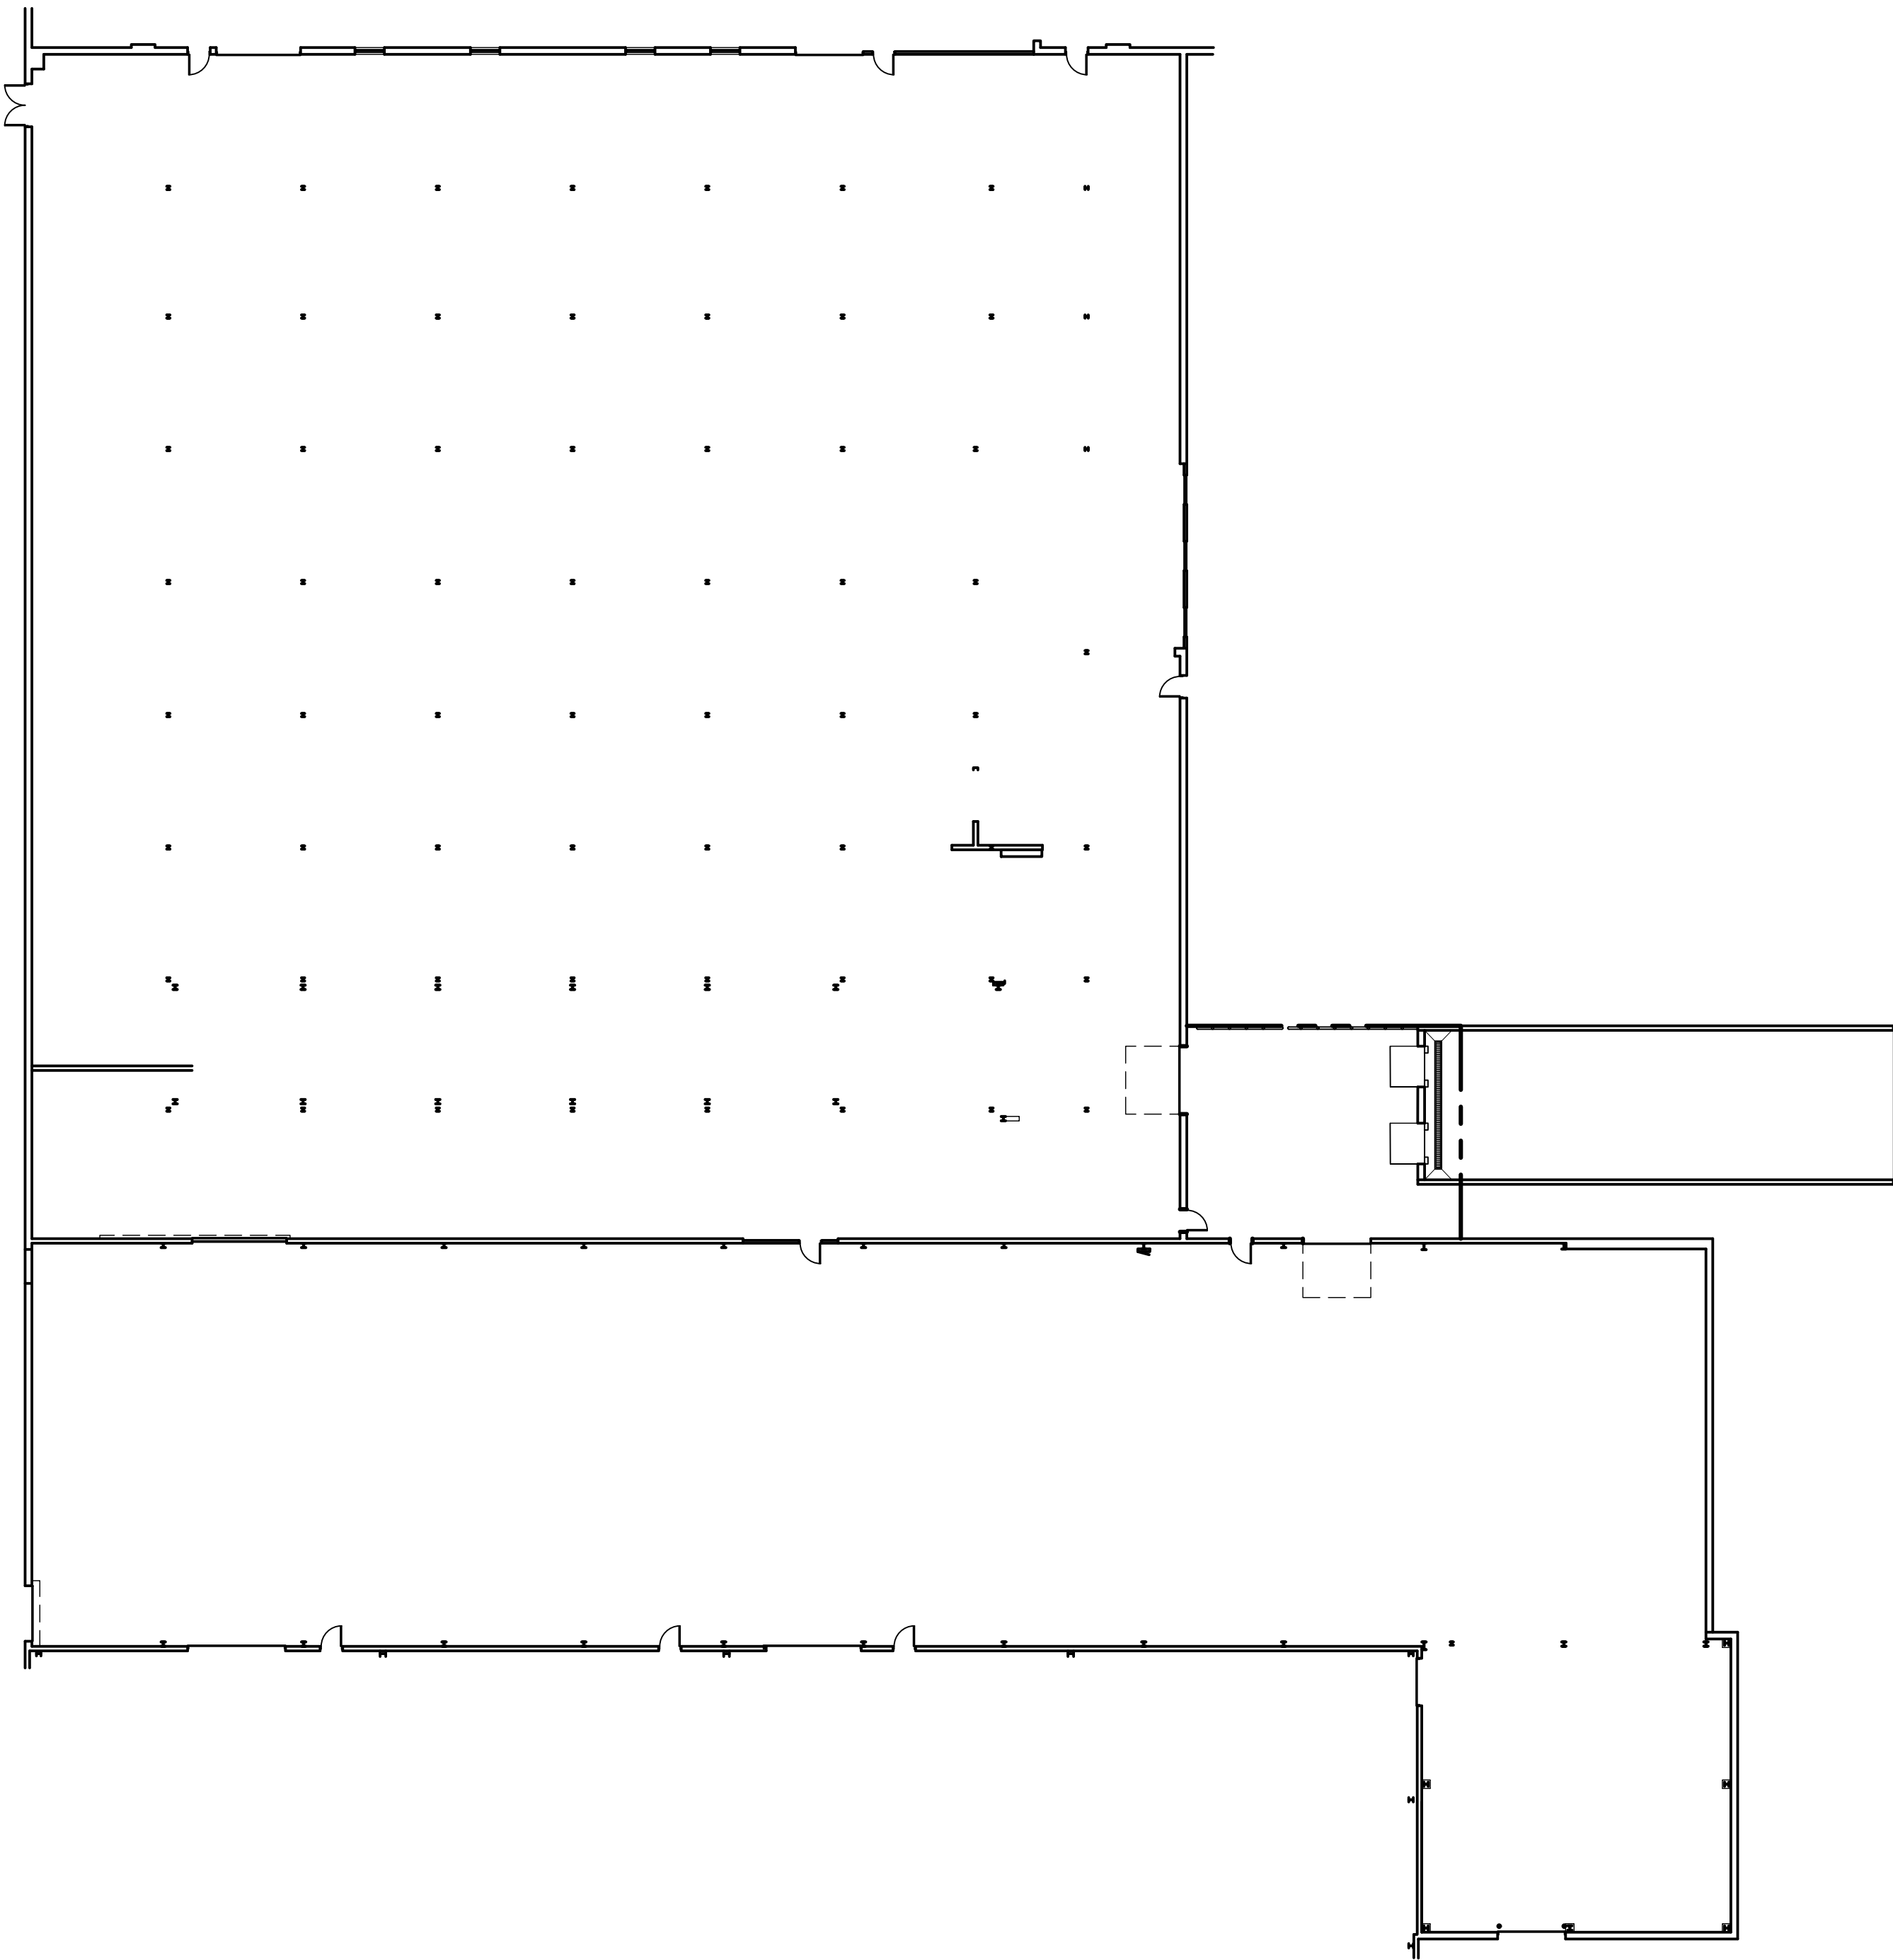

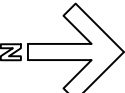

DESIGN • CONSTRUCTION • MANAGEMENT
23617 JOHN R ROAD
HAZEL PARK, MICHIGAN 48030
(2 4 8) 5 4 7 - 1 5 0 0

PROJECT-LOCATION
CONNER ST. BLDG.

2123 CONNER ST,
PORT HURON, MI 48060

DRAWING TITLE:
AS-BUILT FLOOR PLAN

G.L.A. = 44,044 SQ. FT.

DRAWN
CHECKED
APPROVED

RZ
SCD/JWM
SCD/JWM

DO NOT SCALE THIS PRINT
USE FIGURED DIMENSIONS ONLY

PROJECT NUMBER
SHEET NUMBER

D12180125
AB-10

COPYRIGHT © 2025 DESIGNSTRUCT INC.