


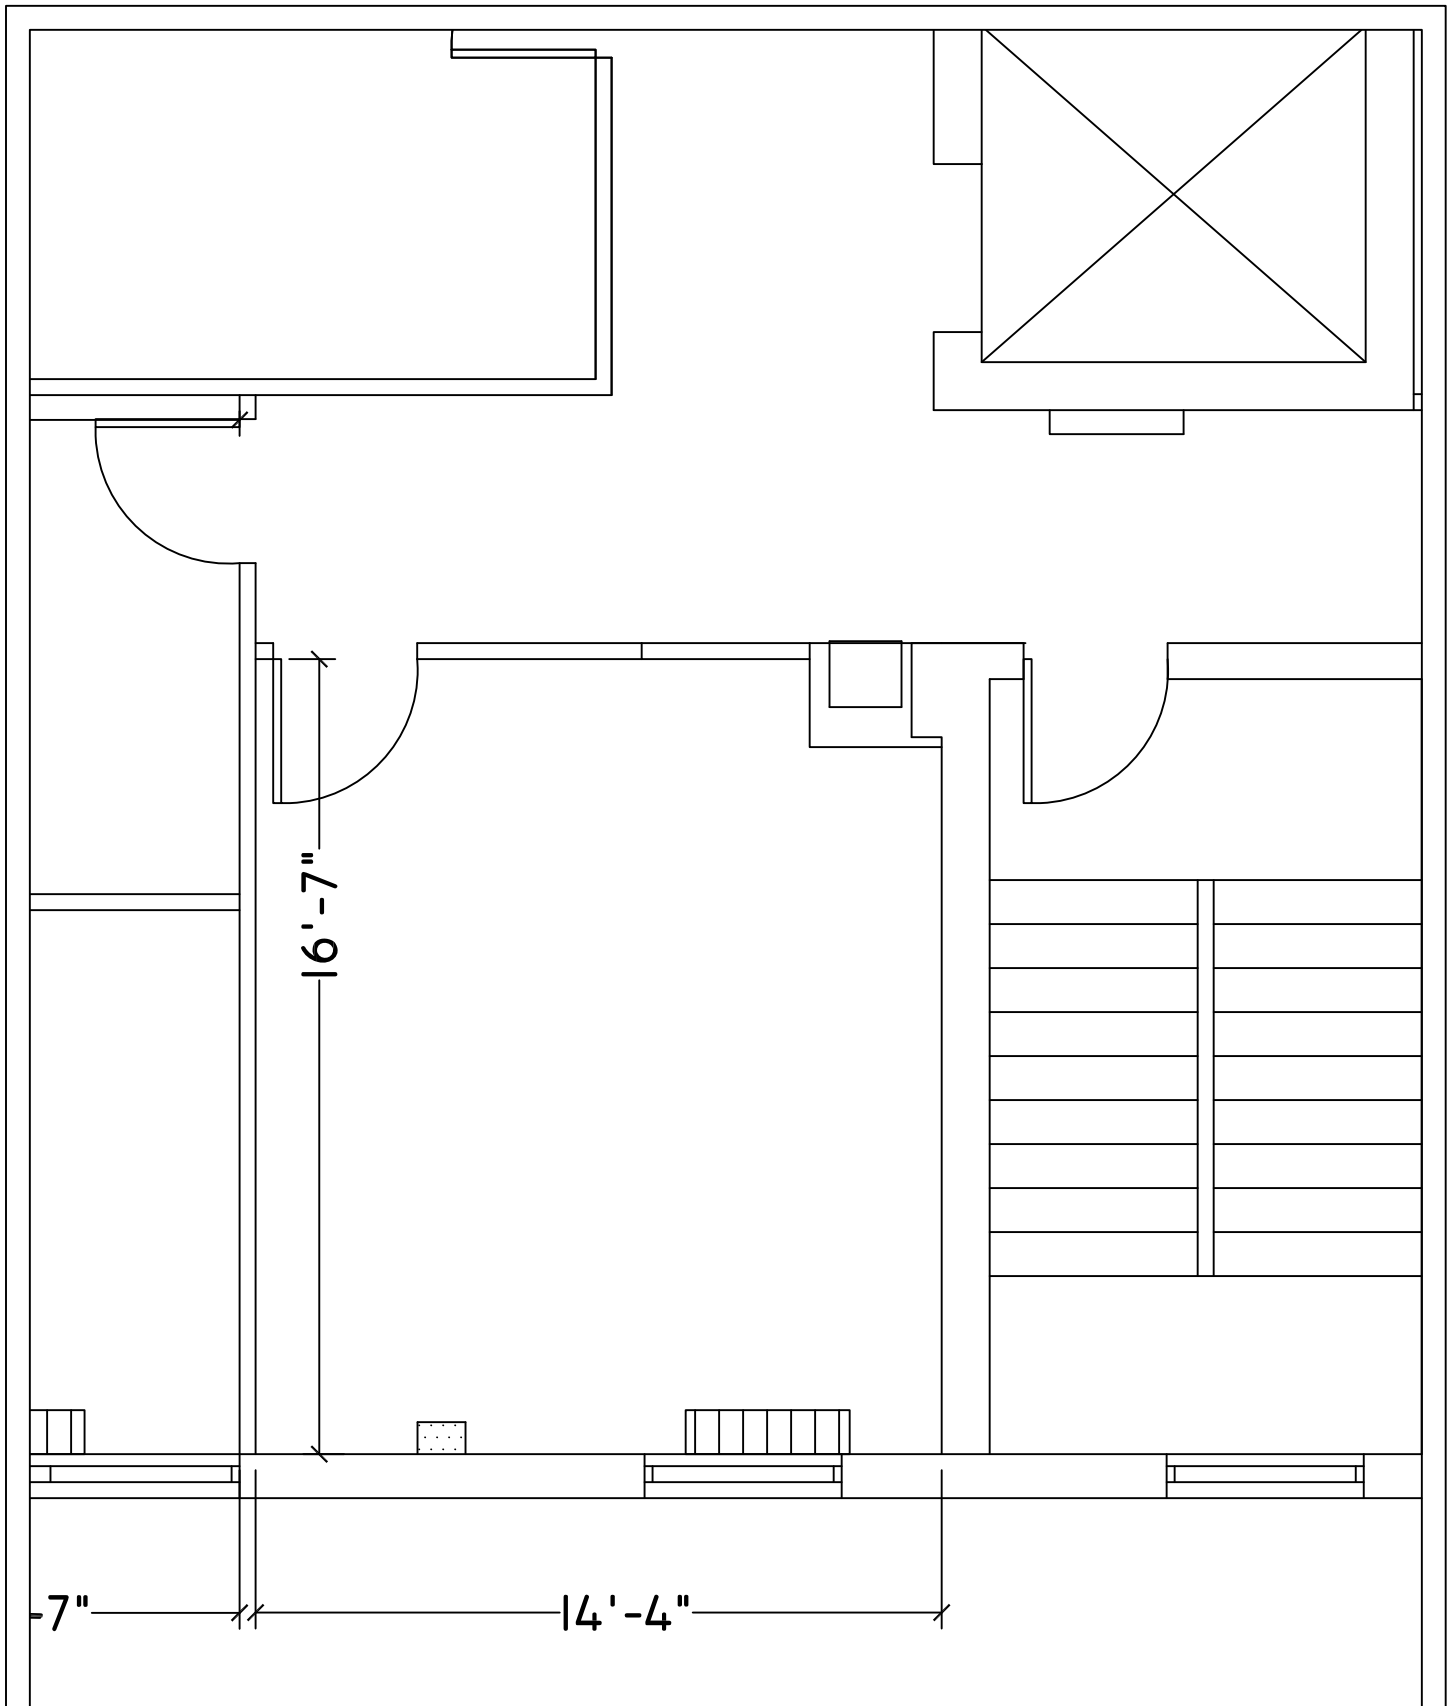

AS-BUILT

SHELL BUILDING
200 E. JOPPA ROAD
SUITE 402B
TOWSON, MD
267 RENTABLE SQ.FT.

SCALE: 1/4" = 1'-0"
DATE: 11/2/09
REVISED:



Hill Management Services, Inc.
9640 Deereco Road
Timonium, Maryland 21093
(410) 666-1000
www.hillmgt.com