


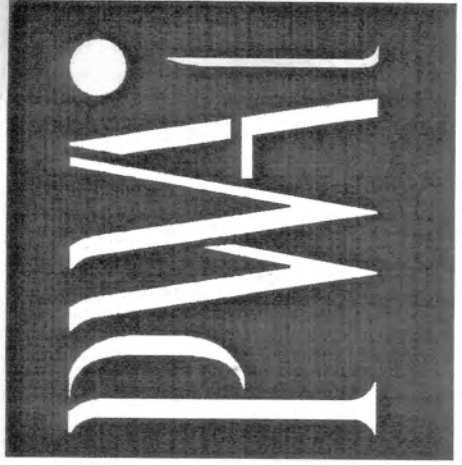

PWAi Architecture, Inc.

9940 Monroe Road
Suite 100
Matthews, NC 28105

T: 704.814.4888
F: 704.814.4889
paul@pwaiaarchitecture.com

Seal



Construction
Documents

MECKLENBURG
FLEET
SERVICES

ADDRESS
HERE

FLOOR
PLAN

Progress Date:

Issue Date: 06 July 2006

Revisions:

- | | | |
|---|-------------------|----------------------------|
| 1 | 25 July 2006 | REVIEW COMMENTS |
| 2 | 05 September 2006 | REVIEW COMMENTS |
| 3 | 08 November 2006 | Revision to Approved Plans |

Project Number: 0615
Cad File Number: 0615-A1.0-FP

FLOOR PLAN A

SCALE: 1/8" = 1'-0"



REFERENCE
NORTH

A1.0

REMOVE CONCRETE SIDEWALK

EXISTING RECESSED
LOADING DOCK

24'-0"
19'-0"
DESIGNATED
PARKING AREA

Concrete Wheel Stop
Typical At All Parking Spaces

GRAVELLED PARKING AREA

EXISTING GRAVEL NEW CONCRETE

REVISION NOTES:
1 ALL WALLS ARE EXISTING.
NO NEW WALLS ARE PROVIDED.
EXISTING TOILET, COUNTER,
EXTERIOR DOORS AND EXIT DOORS.
2 FOAM SPRAY INSULATION IS
EXISTING CONDITION. NO NEW
INSULATION IS PROVIDED IN
THIS PROJECT.

REVISION 2 NOTES:

- EXISTING SPRAY INSULATION SHALL BE REMOVED FOR ALL
STRUCTURAL FRAME, BEAM, AND GRTS.
- ALL EXISTING METAL WALL AND ROOF PANELS WITH SPRAY
APPLIED INSULATION SHALL BE REMOVED. INSTALL NEW WALL
AND ROOF PANELS.
- INSTALL NEW METAL BUILDING PANELS AS REQUIRED BY
PANEL AND METAL BUILDING WRITTEN INSTRUCTIONS. THIS
SHALL INCLUDE TYPE AND SIZE OF SCREW. PENETRATION
SHALL BE PROVIDED WITH FACTORY FURNISHED
WASHER AND SEALANT TO MAKE ALL SCREW ATTACHMENTS
WATER TIGHT.
- PROVIDE NEW VINYL FACED BATT INSULATION @ WALLS AND
ROOF. WALL INSULATION SHALL BE R-15. ROOF INSULATION
SHALL BE R-15

NOTE: THIS PROJECT IS NOT A
CHANGE OF USE. RATED WALL IS NOT
REQUIRED BY THE CODE. SEE
JOINTMAN LEONARD ON 7/12/2006.

STORAGE
AREA
101

EXISTING WOMEN'S
TOILET
103
EXISTING UTILITY SINK

AUTO REPAIR
AREA
102

EXISTING MEN'S
TOILET
104

EXISTING METAL BUILDING SIDING

PARTS
STORAGE
105

EXISTING STAIR TO EQUIP. MEZZANINE
EXISTING AREA ABOVE OFFICE IS
NOT HUSBAL SPACE IS
USED AS FOR OFFICE
MECHANICAL SYSTEM.

OFFICE HEAD HT @
8'-0" ABOVE FFE

EXISTING AREA ABOVE OFFICE
IS NOT HUSBAL SPACE

EXISTING TOILET ROOM
NO WORK IN THIS AREA

EXISTING COUNTER
36" HEIGHT

EXISTING WINDOW: SILL @ 36" HT.
HEAD HT. @ 7'-4"

EXISTING WALL
MOUNTED SIGN

CUSTOMER
AREA
110

ACCESSIBLE WAY FOR EXIT

EXISTING 14'X14"
SECTIONAL O.H.
DOOR

8" WIDE ACCESSIBLE
EXIT WAY

19'-0"
8'-0"
9'-0"
VAN ACCESSIBLE
SPACE

17

16

15

14

13

NEW CONCRETE SLAB-ON-GRADE

NEW CONCRETE
SLAB-ON-GRADE

5" THICK CONC.
SLAB ON GRADE

EDGE OF CONCRETE

CONTROL JOINT

CONTROL JOINT

