


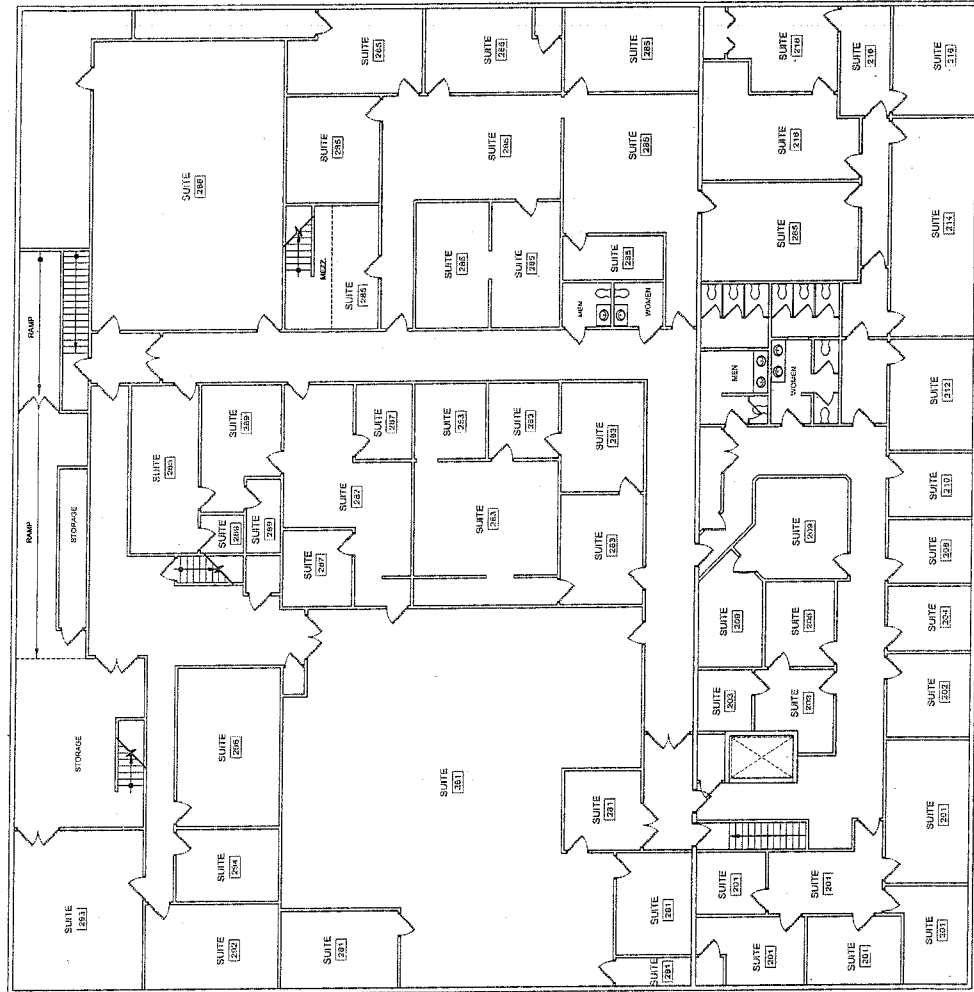

"AS BUILT" SECOND FLOOR PLAN
SCALE - 1/8" = 1'-0"