


RETAIL

4121-4129 LONG BEACH BOULEVARD
LONG BEACH, CA 90807


AS-BUILT DOCUMENTATION

PROJECT LINKS


CLICK HERE TO VIEW YOUR PLANS USING
PPM'S WEB VIEWER POWERED BY

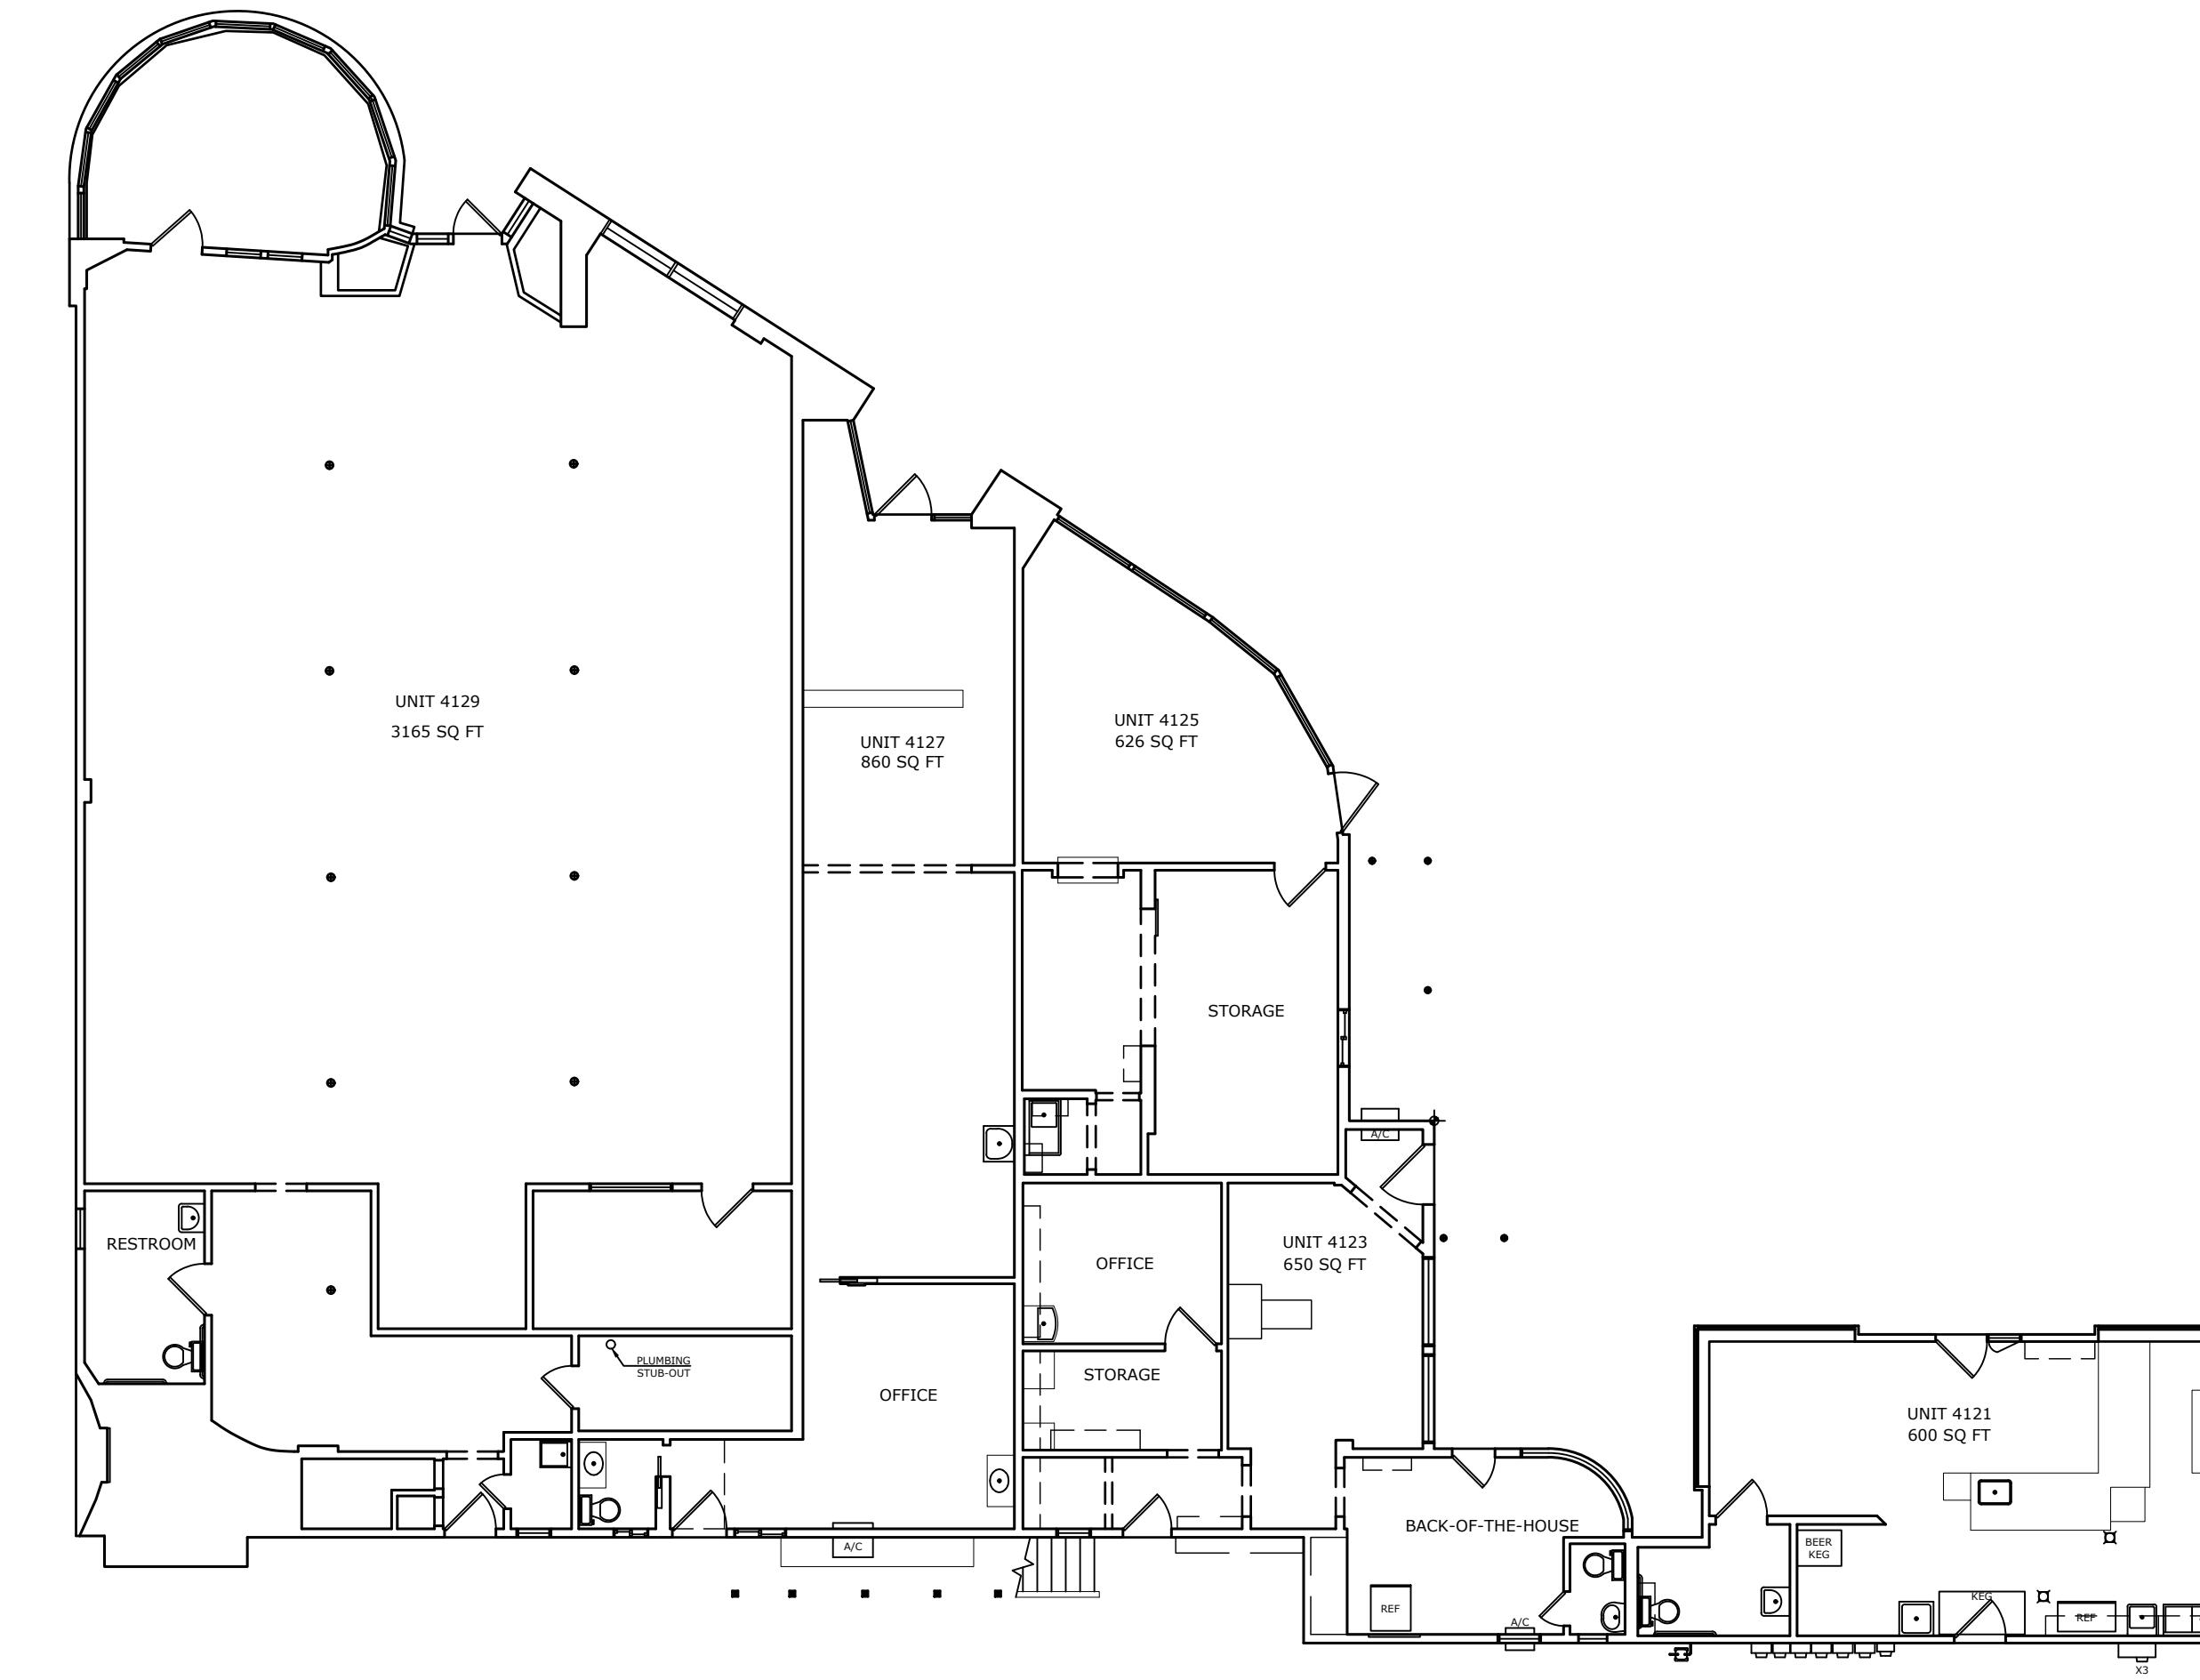

VICINITY MAP

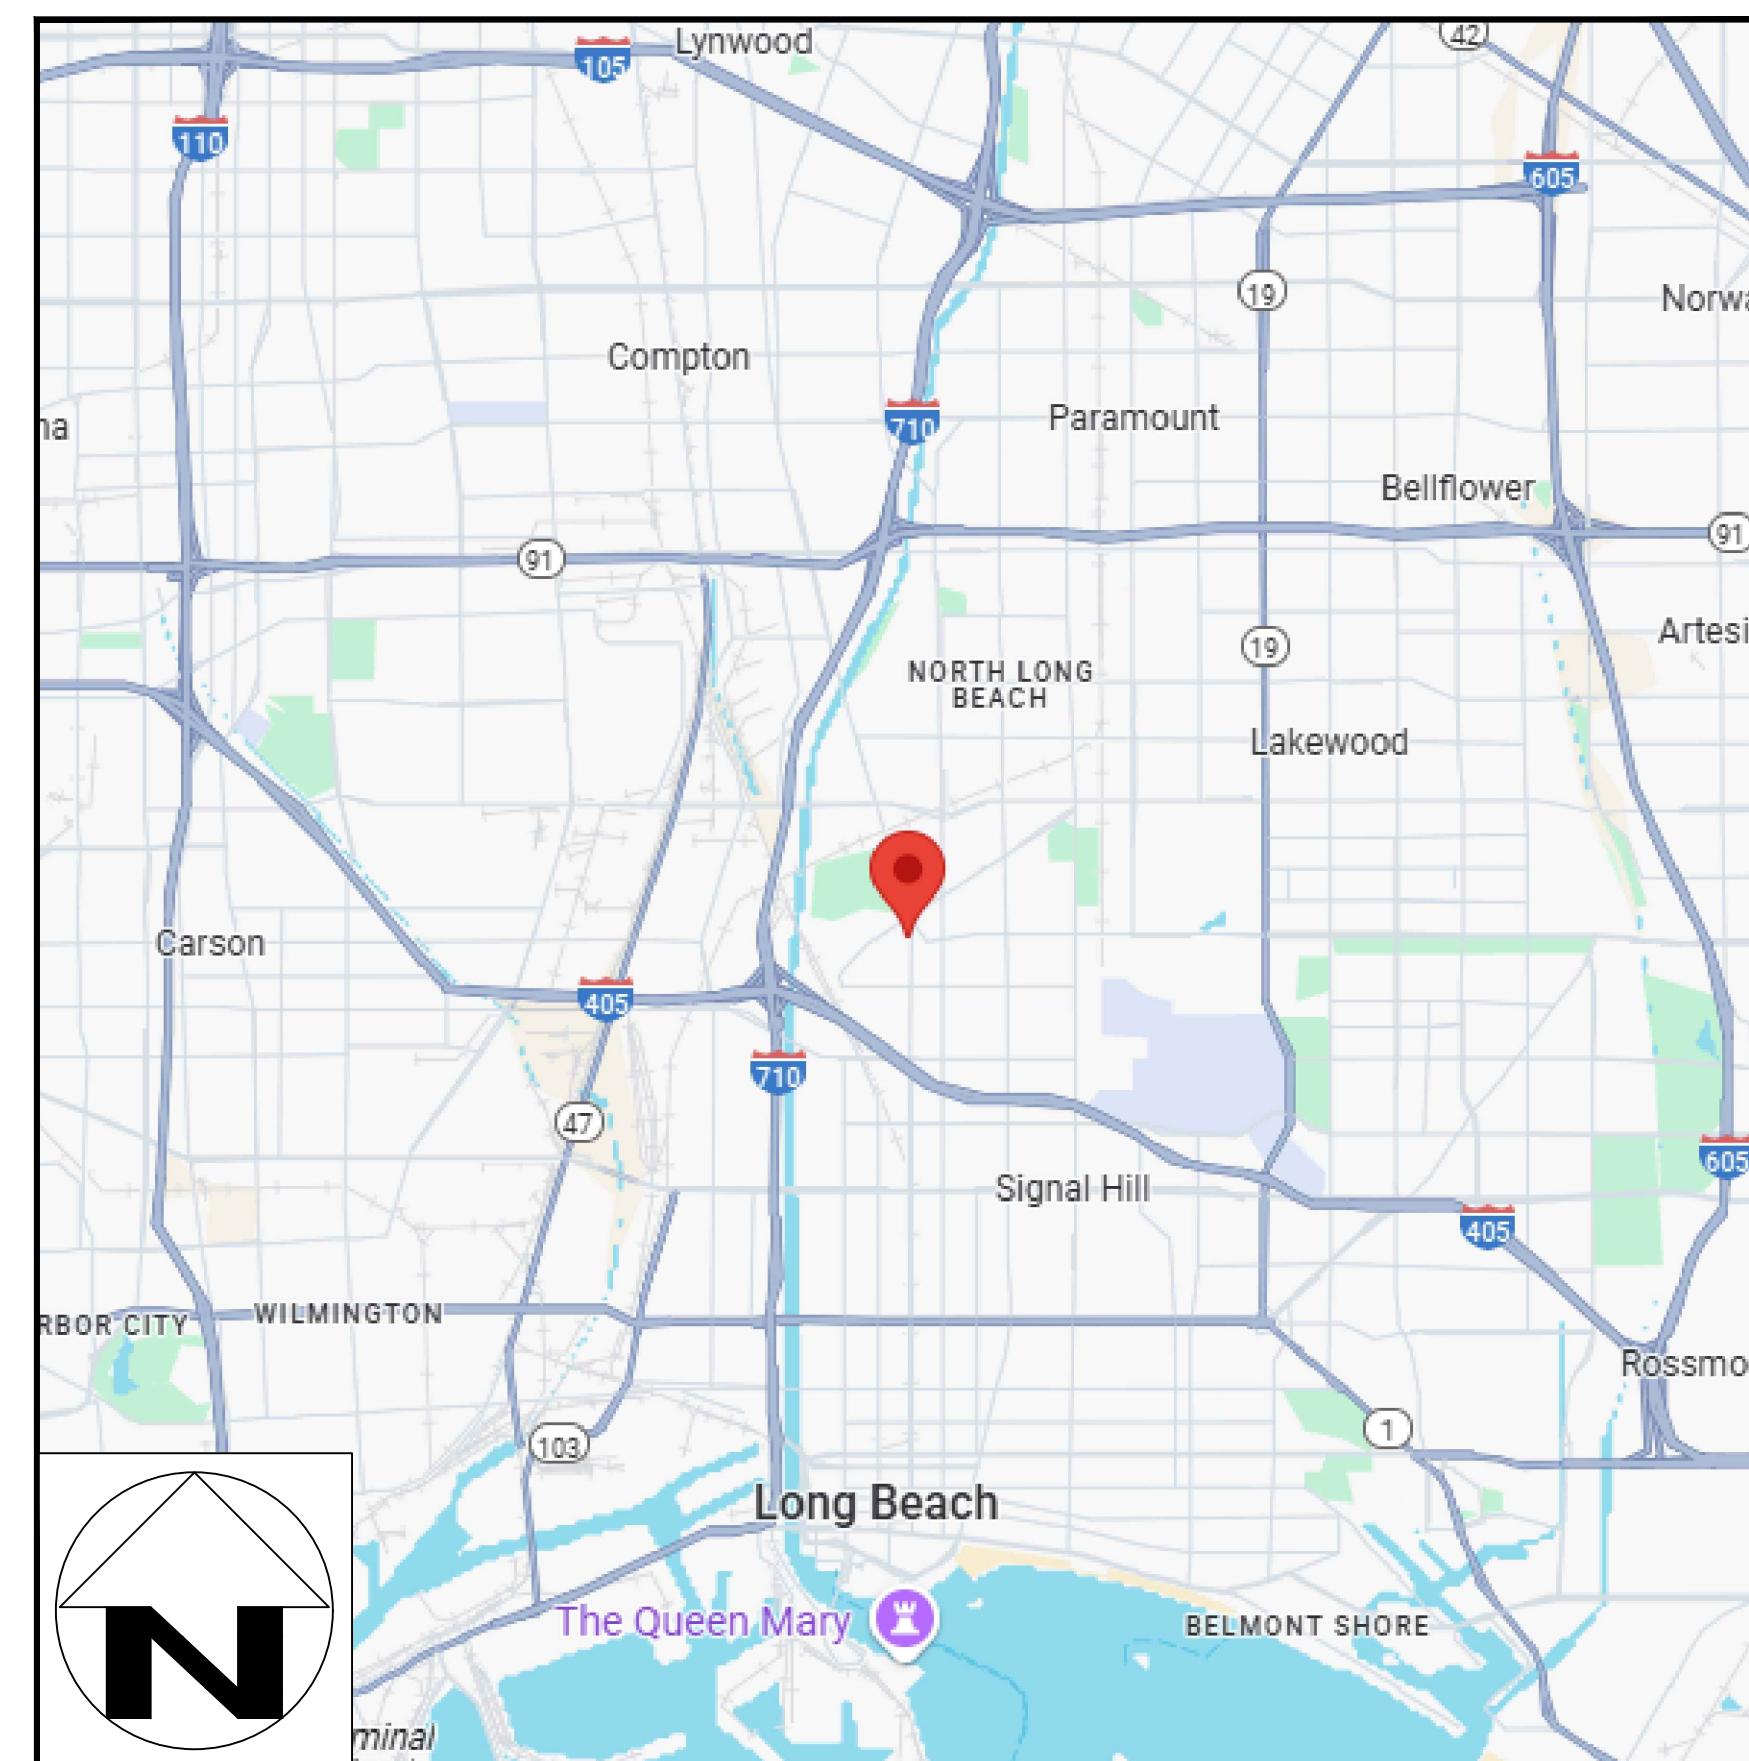

AERIAL VIEW

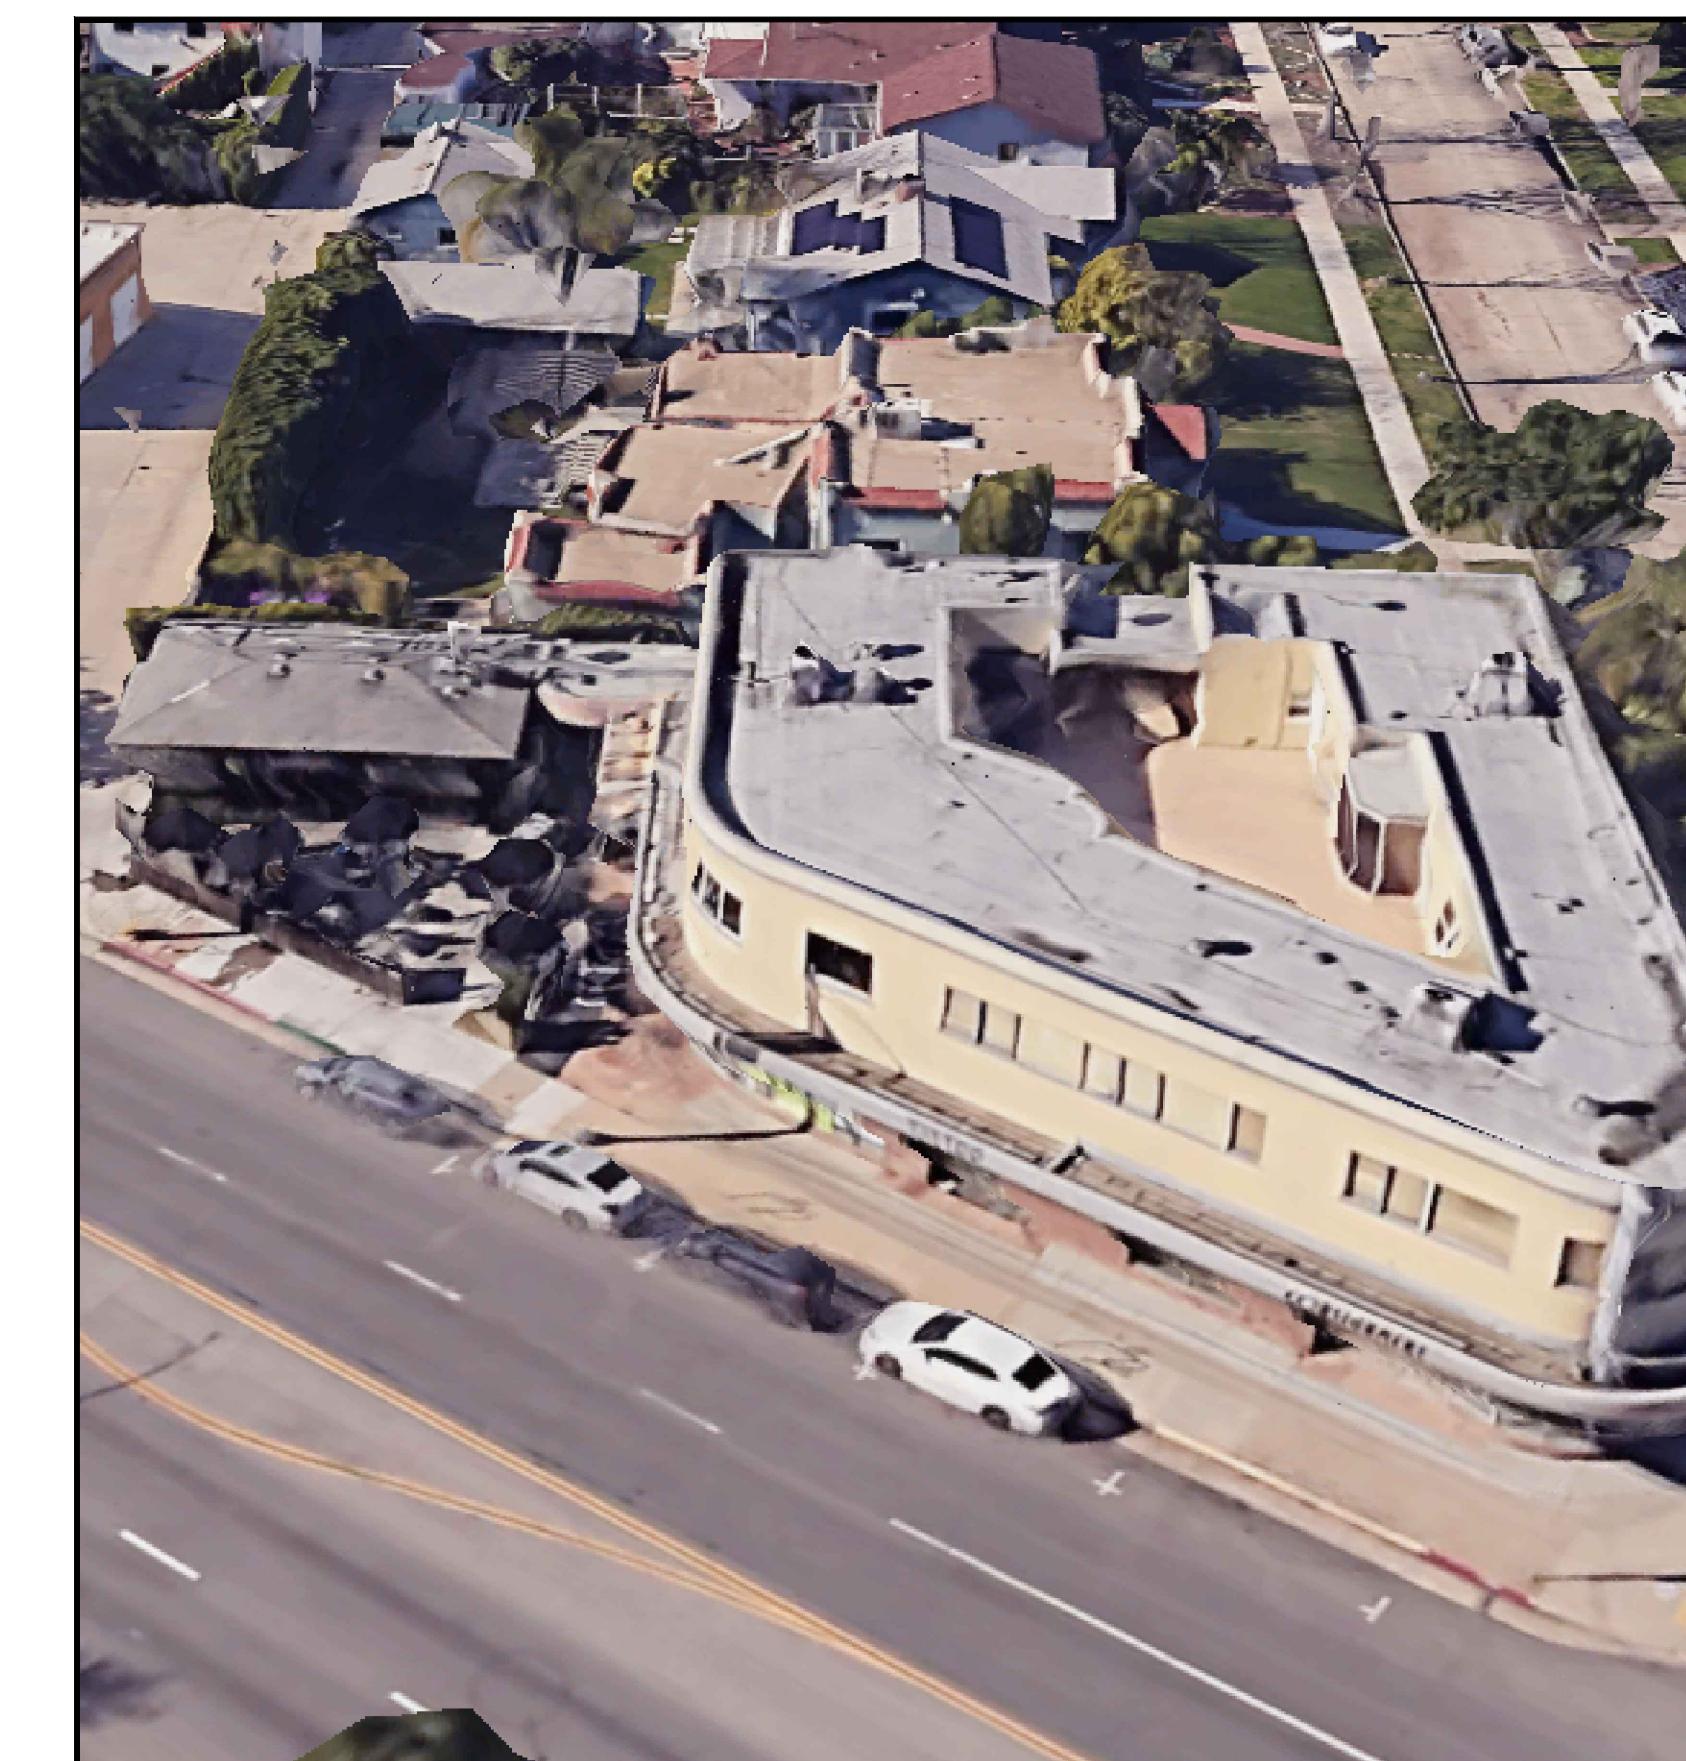

PPM PROJECT CONTACTS

LOS ANGELES REGIONAL OFFICE
CAMERON SLATTERBECK
REGIONAL DIRECTOR
CAMERON@PPMCO.NET
(562) 621-9100 EXT. 201

LINDSEY GREENE
PROJECT MANAGER
LGREENE@PPMCO.NET
(510) 479-7109 EXT. 222

CORPORATE OFFICE
OFFICE@PPMCO.NET
(855) 272-8458 EXT. 100
[HTTPS://PPMCO.NET/CONTACT/](https://PPMCO.NET/CONTACT/)

SHEET INDEX

Sheet	Sheet Title
1	COVER PAGE
2	FLOOR PLAN

