


509-23



OFFICIAL RECORD OFFICIAL RECORD  
OFFICIAL RECORD OFFICIAL RECORD  
BOOK 459 PAGE 23


RECORDED  
APR 20 12 57 PM '89

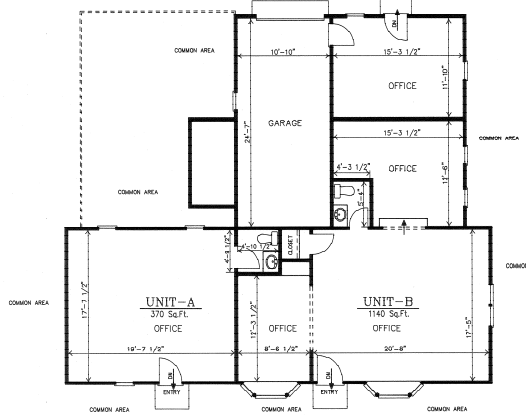

UNIT A & UNIT B - FIRST FLOOR PLAN

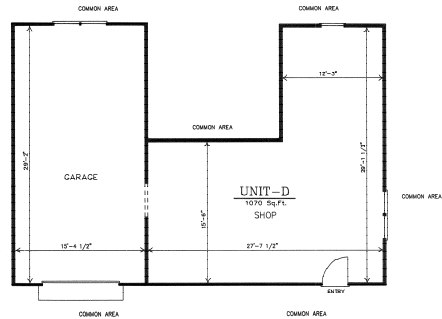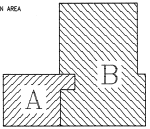

UNIT D - FIRST FLOOR PLAN

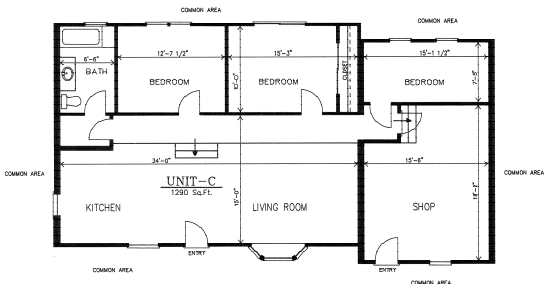

UNIT C - FIRST FLOOR PLAN

SCALE: 3/16"=1'-0"

I HEARBY CERTIFY THAT THIS PLAN WAS MADE IN ACCORDANCE WITH REGISTRY OF DEEDS REGULATIONS EFFECTIVE JANUARY 1-1976.


5 JAN 1989 DATE

REGISTERED PROFESSIONAL ENGINEER

I HEARBY CERTIFY THAT THIS PLAN FULLY AND ACCURATELY DEPICTS THE LAYOUT, LOCATION, UNIT NUMBER AND DIMENSIONS OF THE UNITS AS BUILT.

5 JAN 1989 DATE

REGISTERED PROFESSIONAL ENGINEER

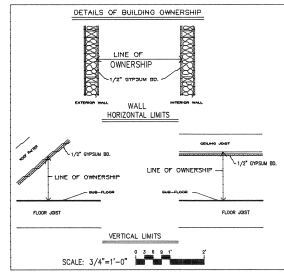

FOR REGISTRY USE:

VILLAGE EAST  
CONDOMINIUMS

413 ROUTE 6A, EAST SANDWICH, MA 02 537

SHEET NO.

1 OF 1