


LOT 11 - BRIGHTON HILL BUSINESS PARK  
STRAUSE, N.Y.  
COTTRELL LAND SURVEYORS, P.C.  
MANHATTAN, N.Y.  
OCT. 11, 1990  
SCALE: 1"=40'

THE FOLLOWING ITEMS, IF MARKED, APPLY:  
 ABSTRACT OF TITLE NOT FURNISHED  
 ABSTRACT OF TITLE CURRENT ONLY AS OF  
 CERTIFICATION VOID -

UNAUTHORIZED ALTERATION OR ADDITION  
TO THIS SURVEY MAP IS A VIOLATION OF  
SECTION 7209 (2), OF THE NEW YORK STATE  
EDUCATION LAW

A RESURVEY/UPDATE BY OTHERS VOIDS  
THIS CERTIFICATION; SUCCESSOR SUR-  
VEYOR BECOMES SOLELY RESPONSIBLE  
FOR THE PERPETUATION OF ALL ERRORS/  
OMISSIONS BY USING THIS SURVEY MAP.

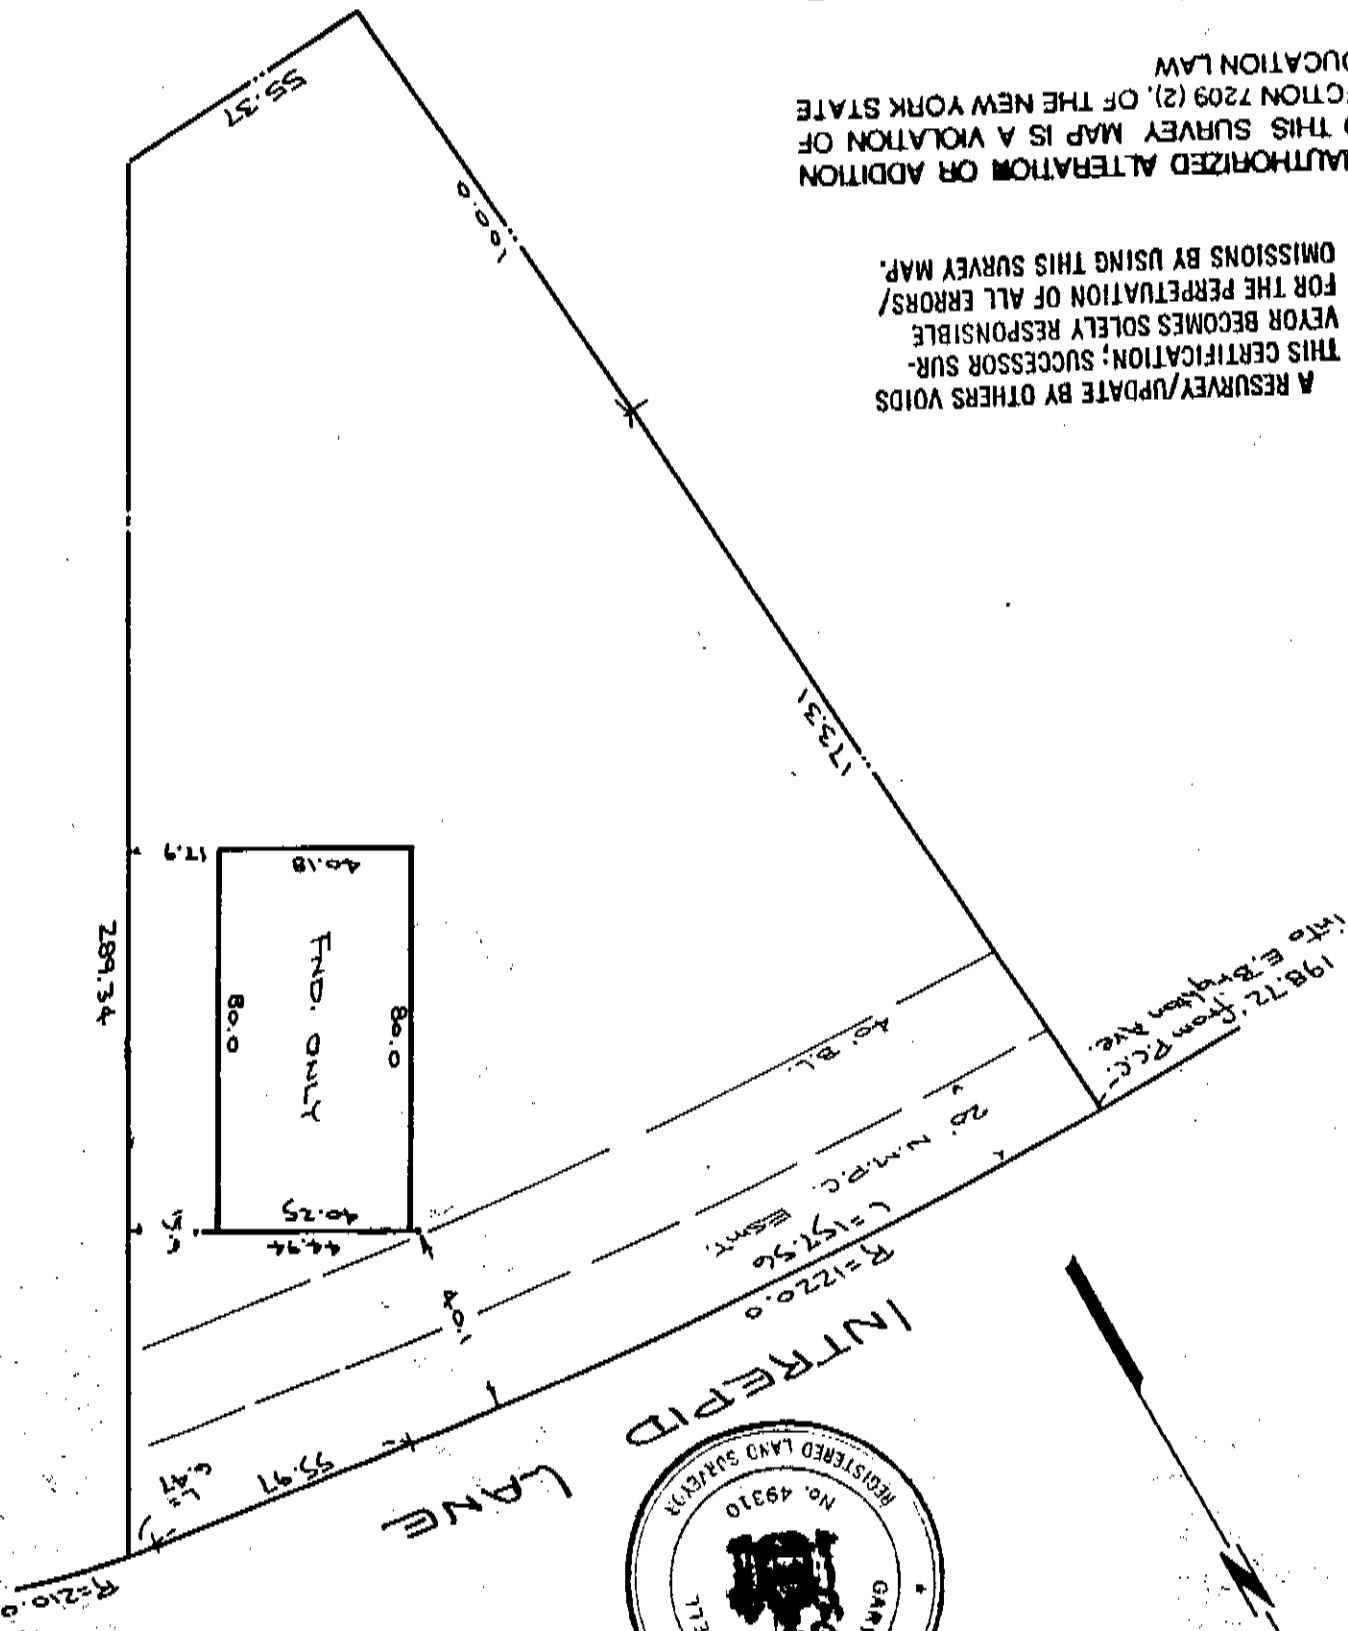

INTREPID  
OCT. 11, 1990  
COTTRELL



THE UNDERSIGNED CERTIFIES THAT THIS  
MAP WAS MADE FROM AN ACTUAL  
SURVEY DATED HERE BELOW, VOID  
WITHOUT RED INK SIGNATURE OR  
EMBOSSED SEAL OF SIGNER

FOR PURCHASE & MORTGAGE PURPOSES ONLY  
CIRCA THE LATEST CERTIFICATION DATE

To: Key Bank of Central New York  
Its Successors + Assigns  
Morris Abstract + Title Corporation