
YELLOW = 14,67 RED = 6,565 sf RLUE = 9,900 SF 14,671 sf

ENTIRE BUILDING = 22,520

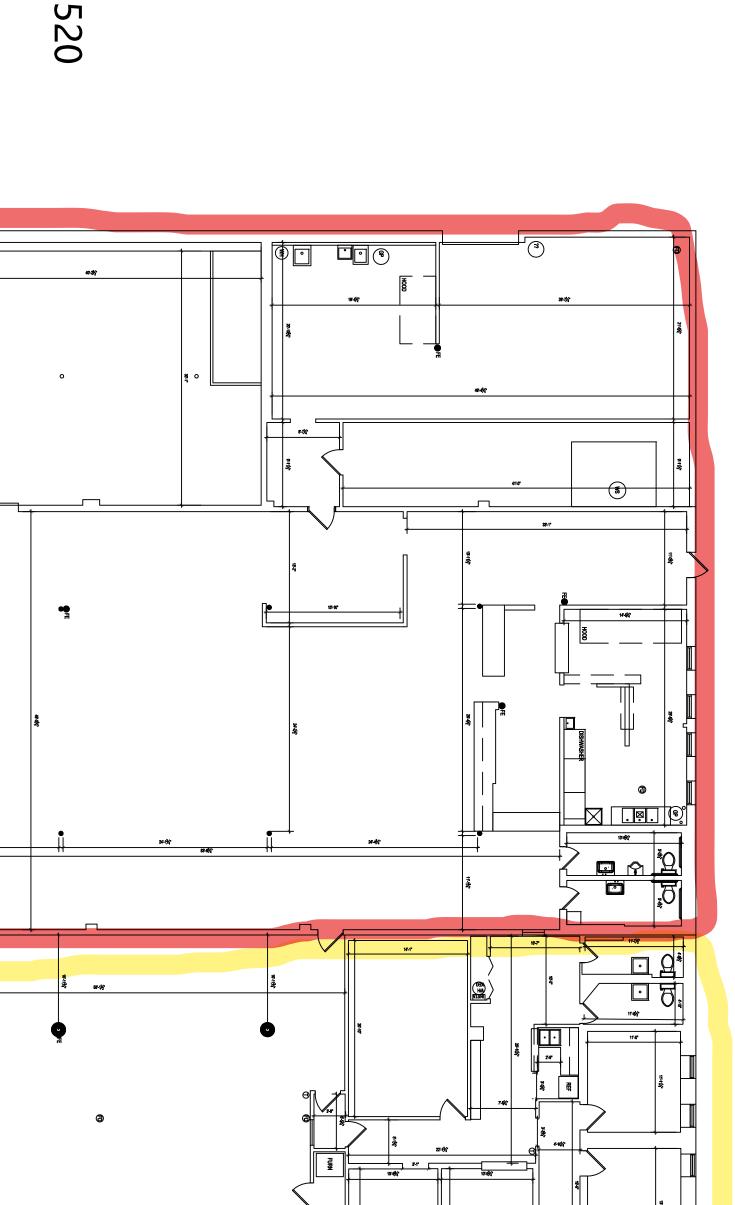


1290 Old Heritage Place
Greenwood Indiana, 46143
317.888.7086

DESIGNS
Www.lehnerdesigns.com

Addendum

7724 DEPOT STREET
MCCORDSVILLE, IN 46055

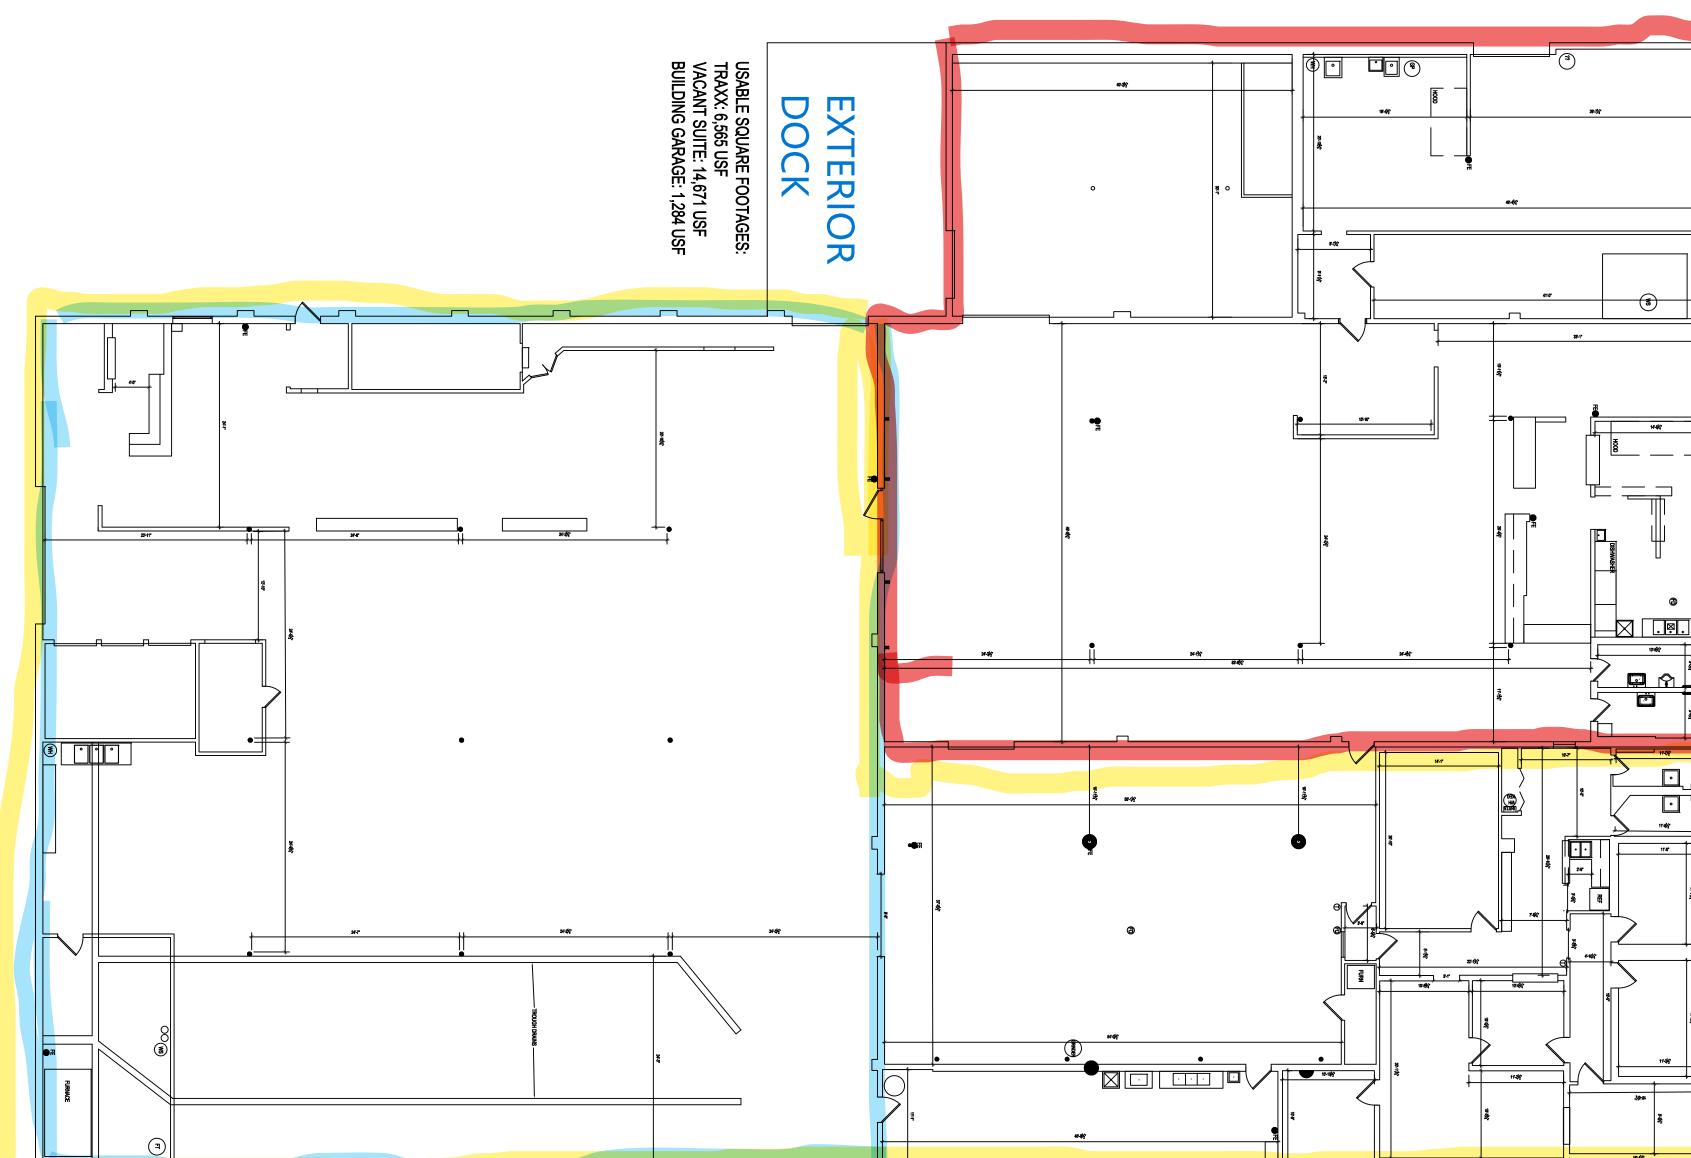

FLOOR PLAN AS-BUILT

Designed By
GL/AT
Checked By PLAN NORTH

#100522 3/32"=1'-0" 08/11/2025