

14272 CHAMBERS ROAD

Tustin, CA

±26,749 SF


Freestanding Flex / Industrial Building
FOR SALE / LEASE



HIGHLIGHTS

- Rehab in process
- Building to be delivered vacant
- Single or multi-tenant building
- Unit A: ±18,249 SF (warehouse / flex space)
- Unit B: ±8,500 SF (warehouse / flex space with private, covered fenced yard)
- 18' clear height
- 600 amps (to verify)
- Fire sprinklers
- 2 GL doors
- 2.1/1,000 (57 spaces)

NEWMARK

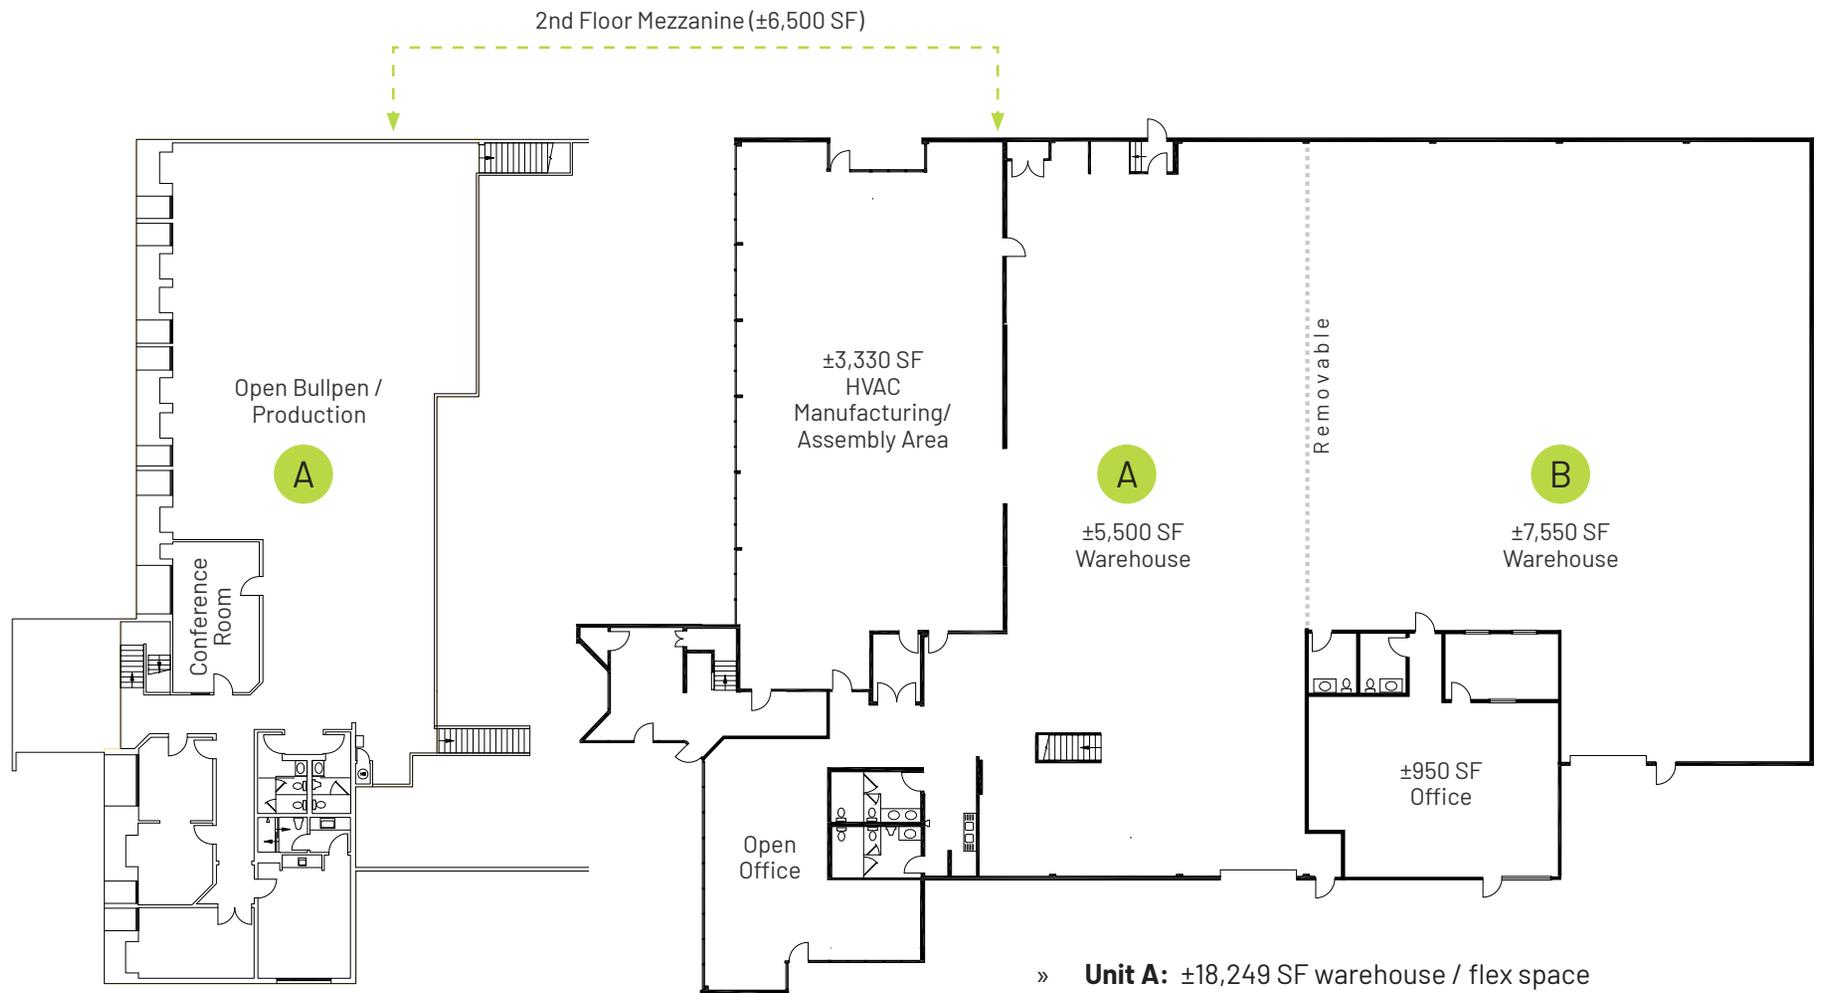


- » **Unit A:** ±18,249 SF warehouse / flex space
- » **Unit B:** ±8,500 SF warehouse / flex space with private/fenced yard
- » **Total SF:** ±26,749 SF


14272 CHAMBERS ROAD

Tustin, CA

AS-BUILT FLOOR PLAN

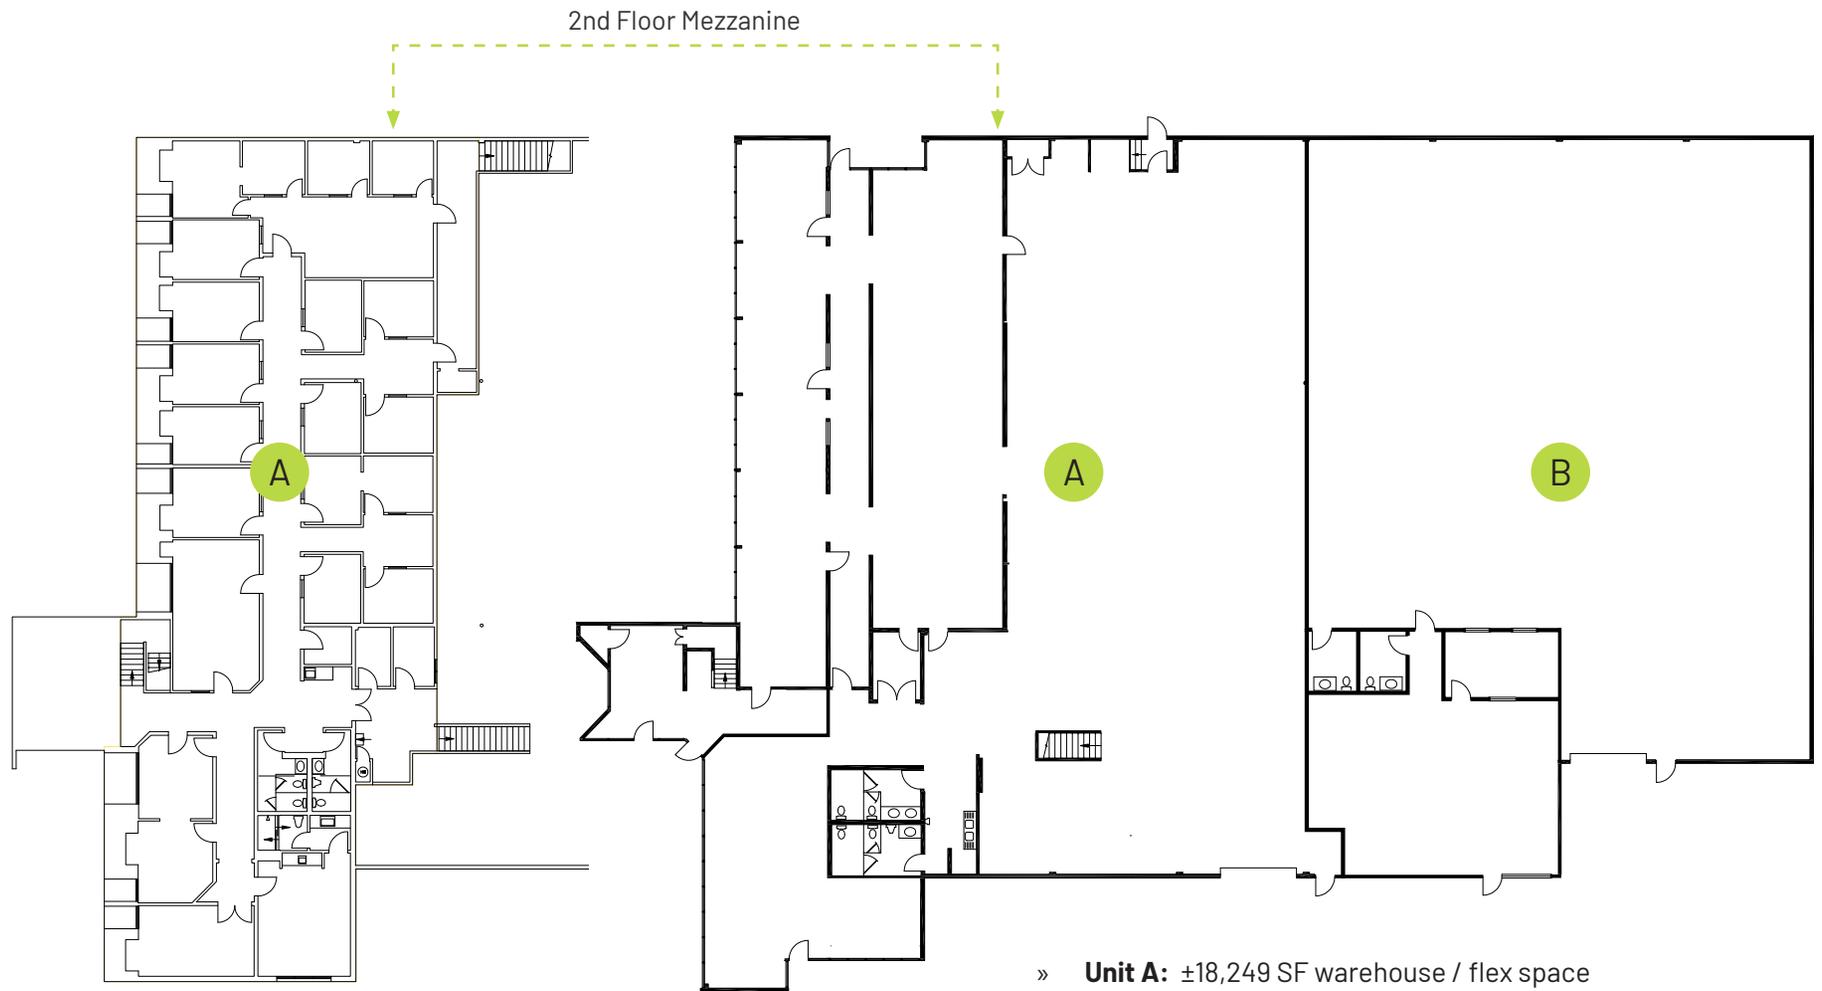

- » **Unit A:** ±18,249 SF warehouse / flex space
- » **Unit B:** ±8,500 SF warehouse / flex space with private/fenced yard
- » **Total SF:** ±26,749 SF

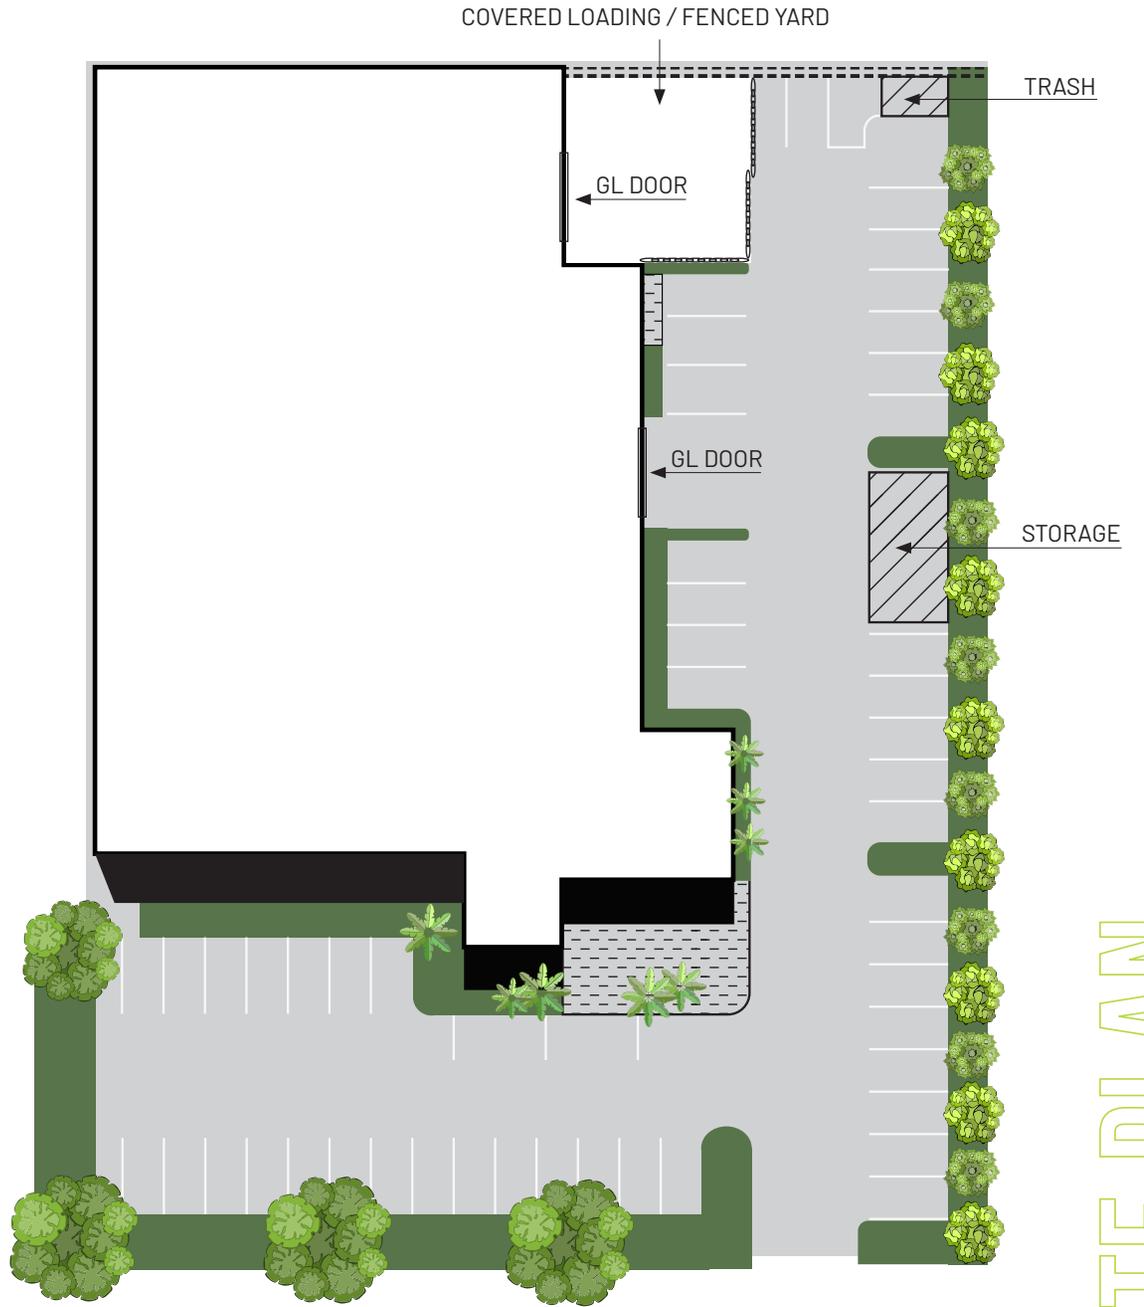

SITE PLAN

14272 CHAMBERS ROAD

Tustin, CA

Nearby Amenities

Major retail and dining: The District at Tustin Legacy and The Market Place in Tustin/Irvine.

Healthcare: Multiple medical offices in the Irvine Business Complex and regional hospitals within a short drive.

Transportation and Access

Freeways and toll roads: Convenient to I-5, SR-55, I-405, and SR-261/241 toll corridors for north-south and east-west connectivity.

Airport: John Wayne Airport (SNA) is within a short drive (7 miles), providing domestic and limited international service.

Rail: Tustin Metrolink Station (Orange County Line/IE-OC Line) nearby for commuter rail to Los Angeles, Irvine, and Inland Empire.



14272 CHAMBERS ROAD

Tustin, CA

±26,749 SF

Freestanding Flex / Industrial Building
FOR SALE / LEASE



EXCLUSIVE ADVISORS:



Troy Wooton
Senior Managing Director
CA RE Lic. #01377431
t 949-608-2020
troy.wooton@nrmk.com



Zac Fielder
Director
CA RE Lic. #01989549
t 949-608-2121
zac.fielder@nrmk.com

Corporate License #01355491

NEWMARK

The information contained herein has been obtained from sources deemed reliable but has not been verified and no guarantee, warranty or representation, either express or implied, is made with respect to such information. Terms of sale or lease and availability are subject to change or withdrawal without notice.