


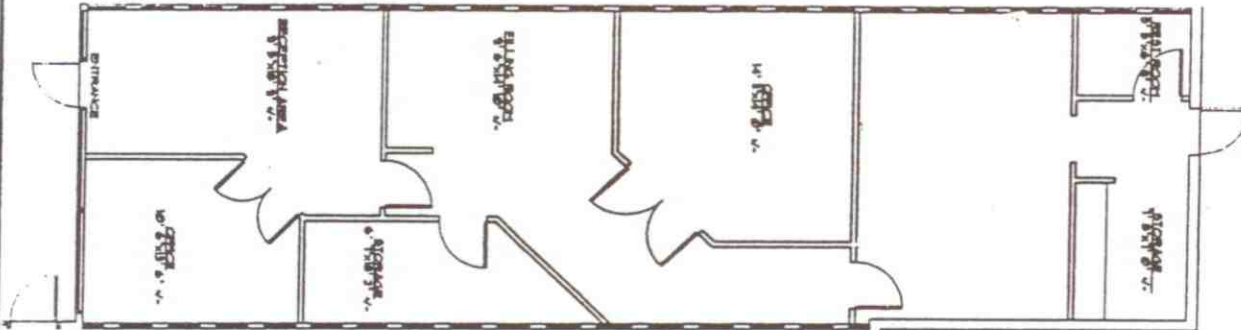

ISLAND LAKE CENTER

1588

SUITE 164

1000 sq. feet

AS-BUILT FLOOR PLAN

THIS IS NOT A SURVEY. ALL DIMENSIONS ARE APPROXIMATE. FIELD VERIFICATION IS REQUIRED.



KELLOGG DEVELOPMENT COMPANY
QUANTILLY COURT
1000 HOLLAND BLVD., SUITE C-200
SEASIDE PARK, FL. 32168

AS-BUILT
FLOOR PLAN
NOT FOR CONSTRUCTION

PROJECT NO. 1588
DATE: 10/1/00
BY: J. TAYLOR

BRILLON
&
TAYLOR
ARCHITECTS

PROJECT NO. 1588
DATE: 10/1/00
BY: J. TAYLOR

NO.	DATE	REVISION
1	10/1/00	ISSUED FOR PERMIT
2		
3		
4		
5		
6		
7		
8		
9		
10		