



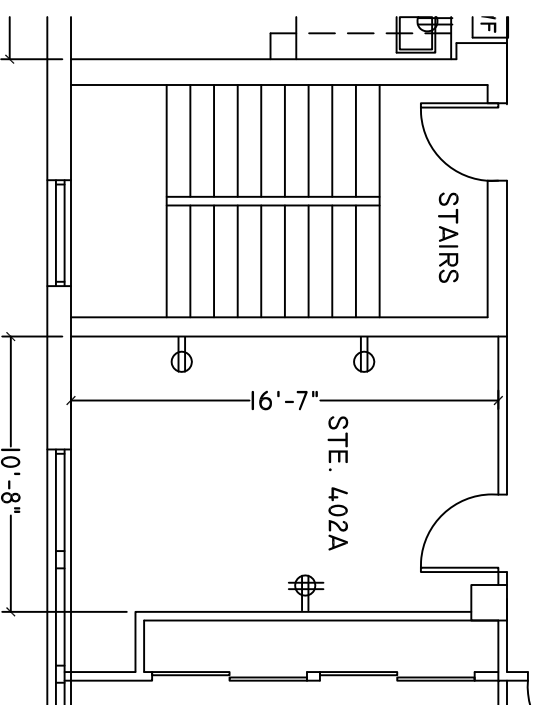

AS-BUILT

SHELL BUILDING
200 E. JOPPA ROAD
TOWSON, MD
SUITE 402A = 209 RENTABLE SQ.FT.

SCALE: 1/8" = 1'-0"
DATE: 3/24/09
REVISED:

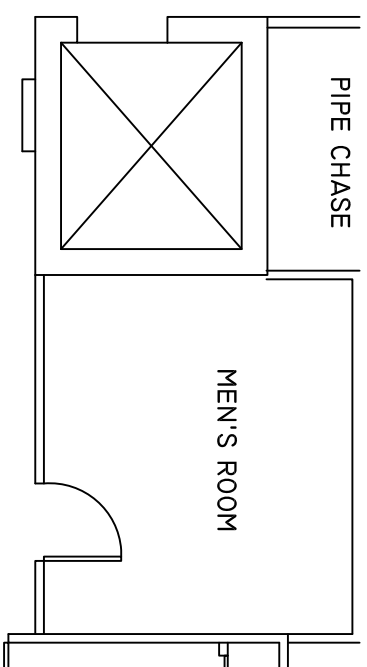

Hill Management Services, Inc.
9640 Deereco Road
Timonium, Maryland 21093
(410) 666-1000
www.hillmgt.com