




3550 LEE HILL DR. WAREHOUSE AS-BUILTS

3550 LEE HILL DR FREDERICKSBURG, VA 22408

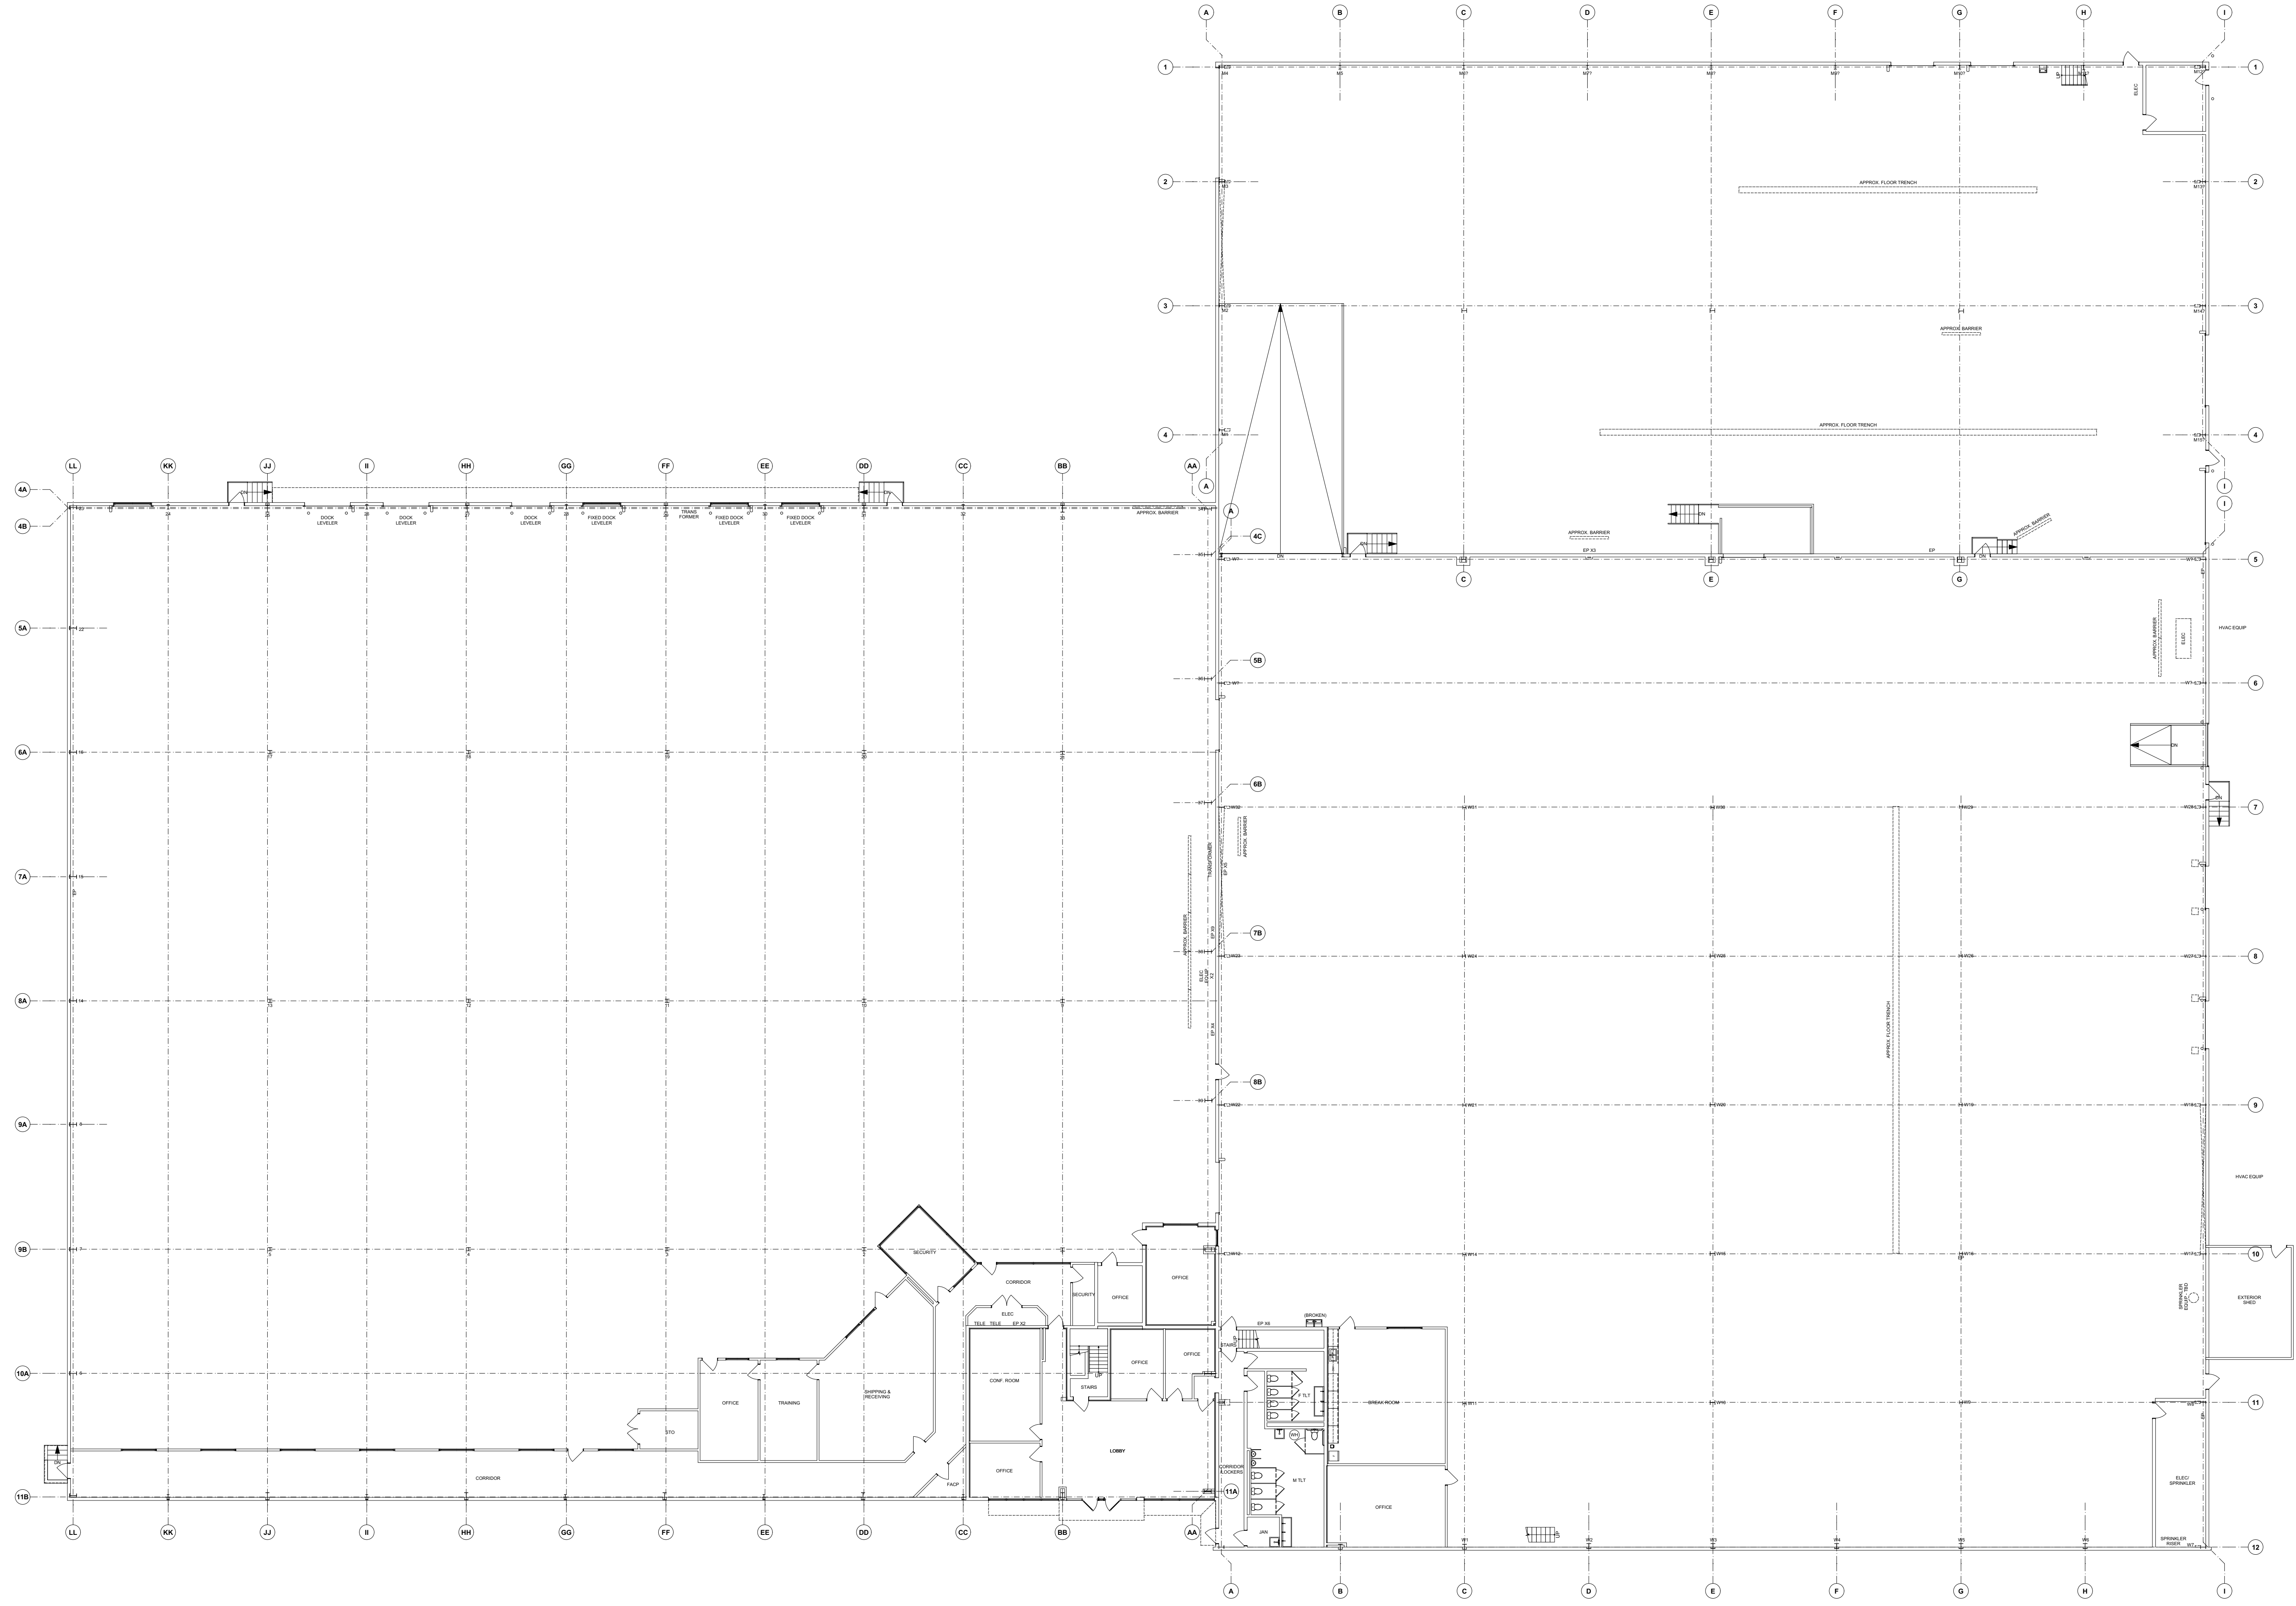


42
01 FLOOR PLAN - 1ST FLOOR
SCALE: 1/16" = 1'-0"




3550 LEE HILL DR. WAREHOUSE AS-BUILTS

3550 LEE HILL DR FREDERICKSBURG, VA 22408

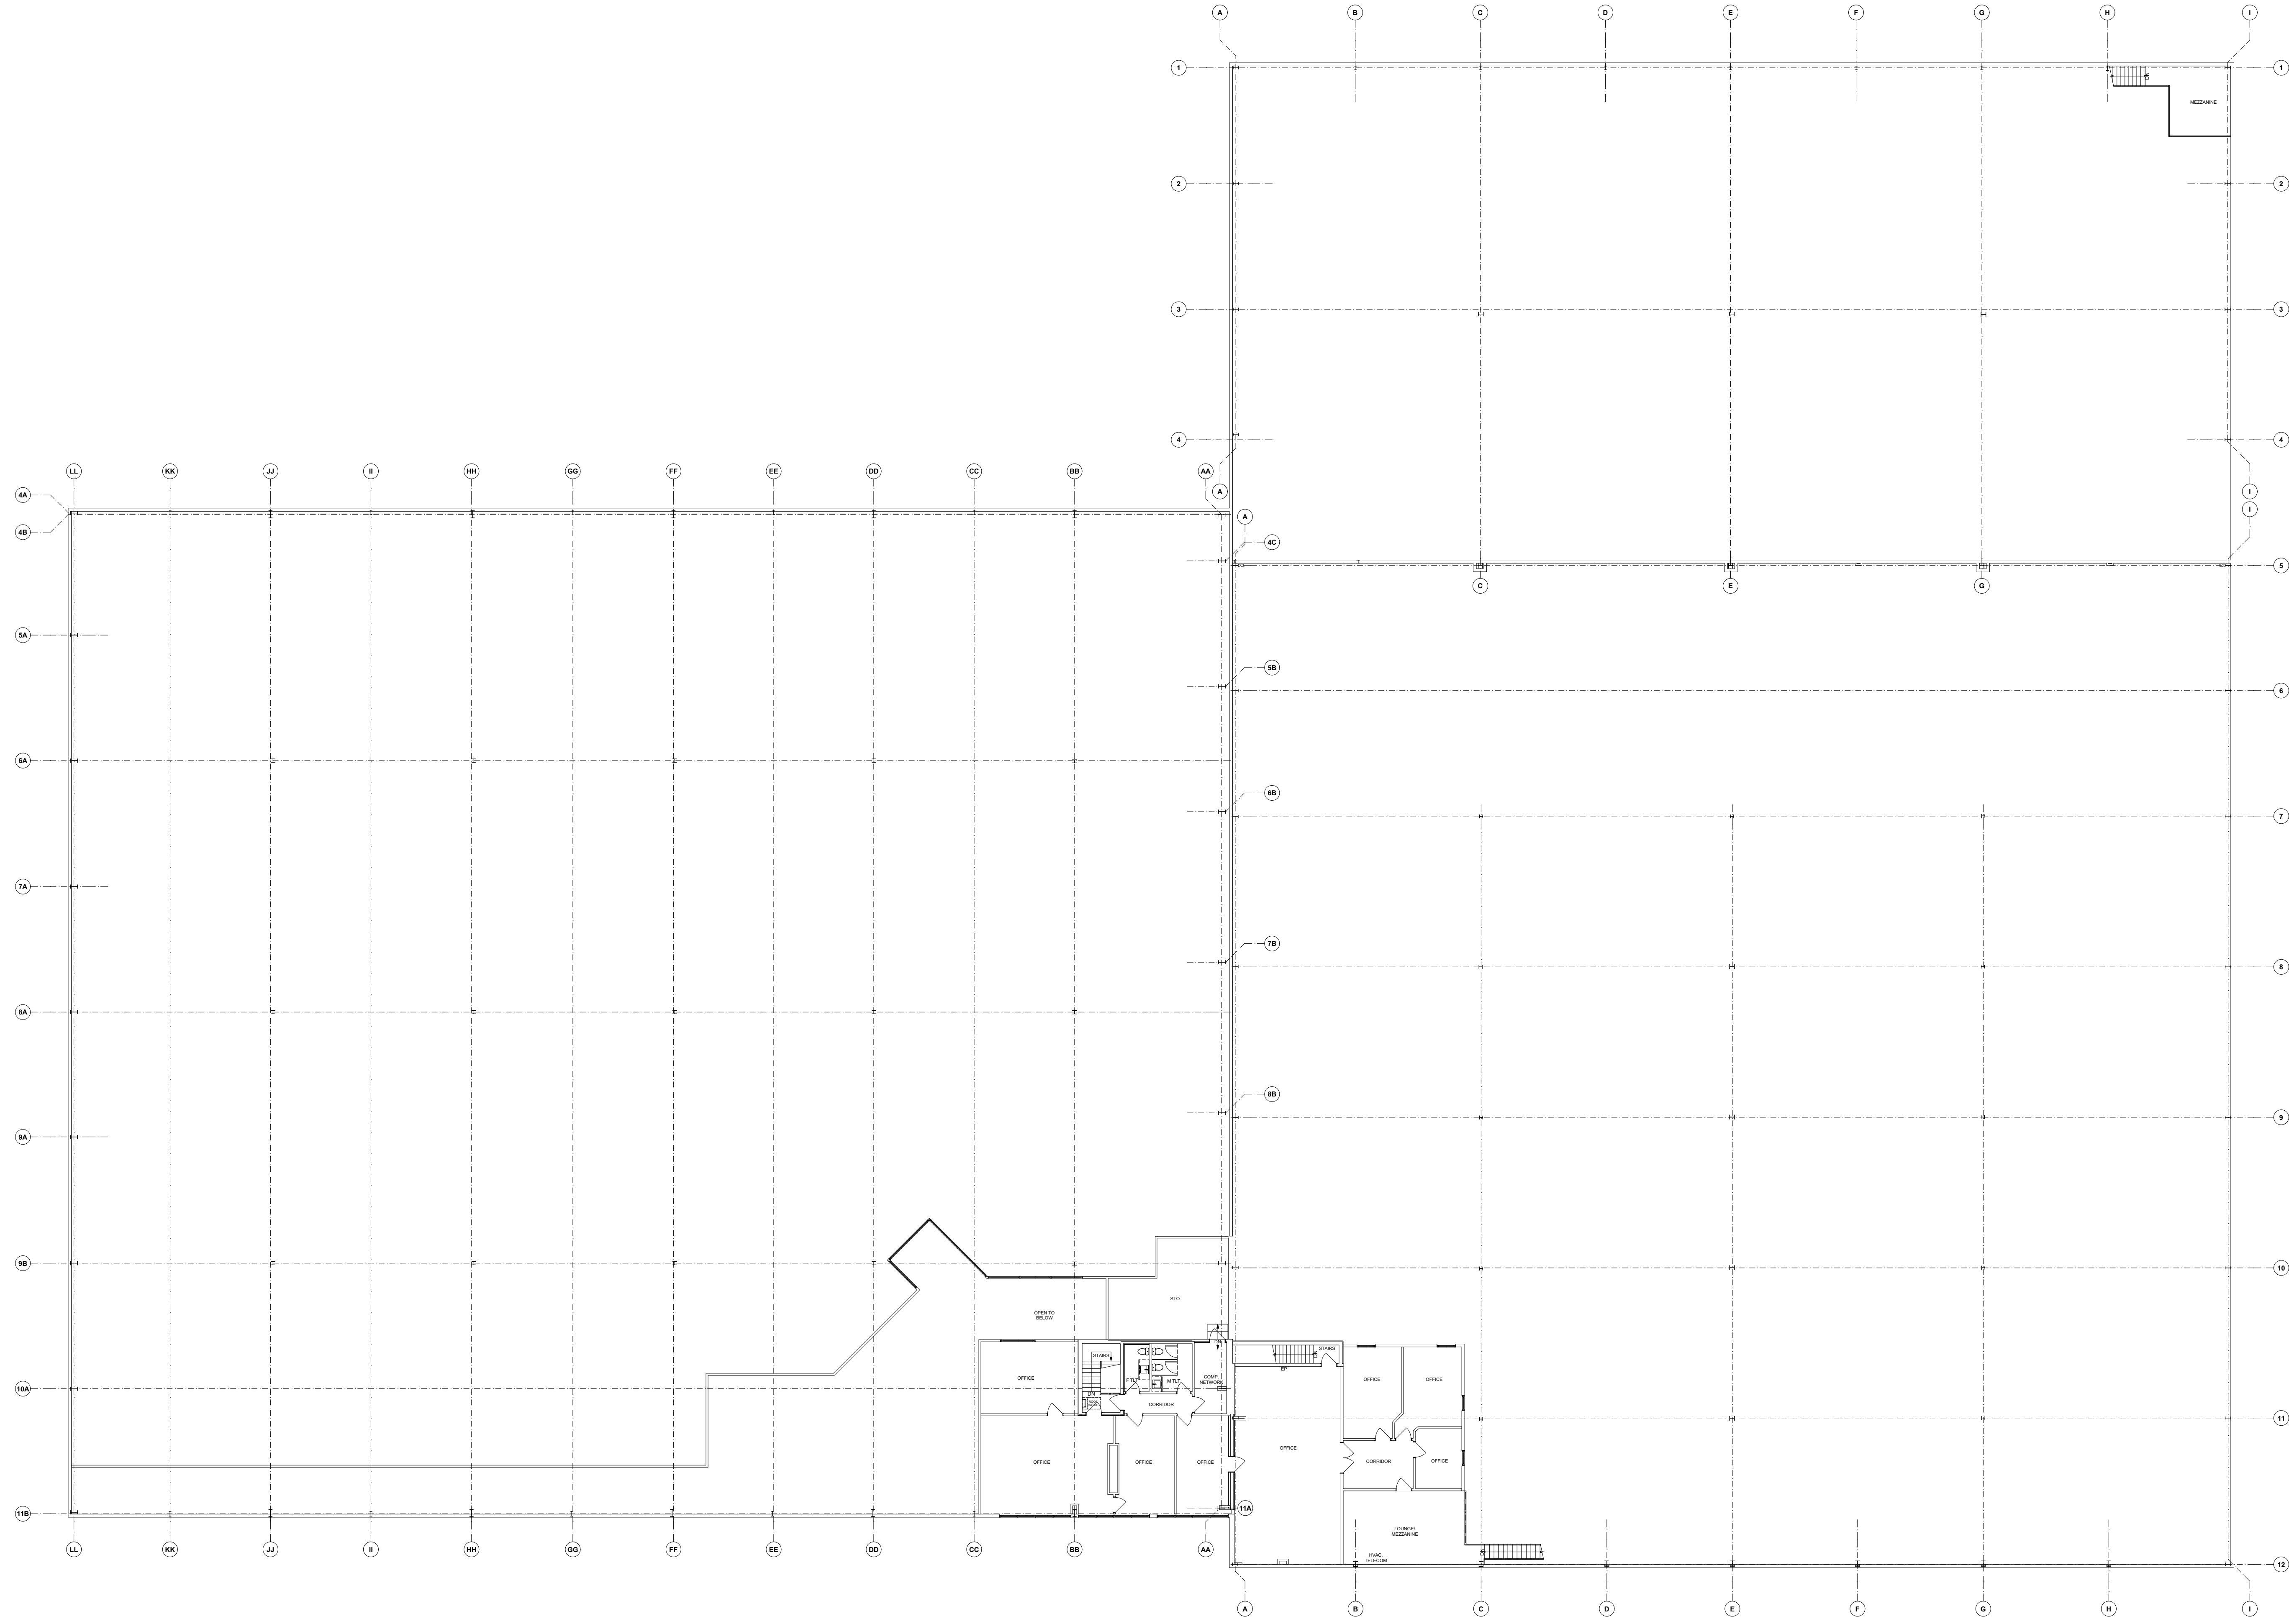

42 FLOOR PLAN - 2ND FLOOR
02 SCALE: 1/16" = 1'-0"

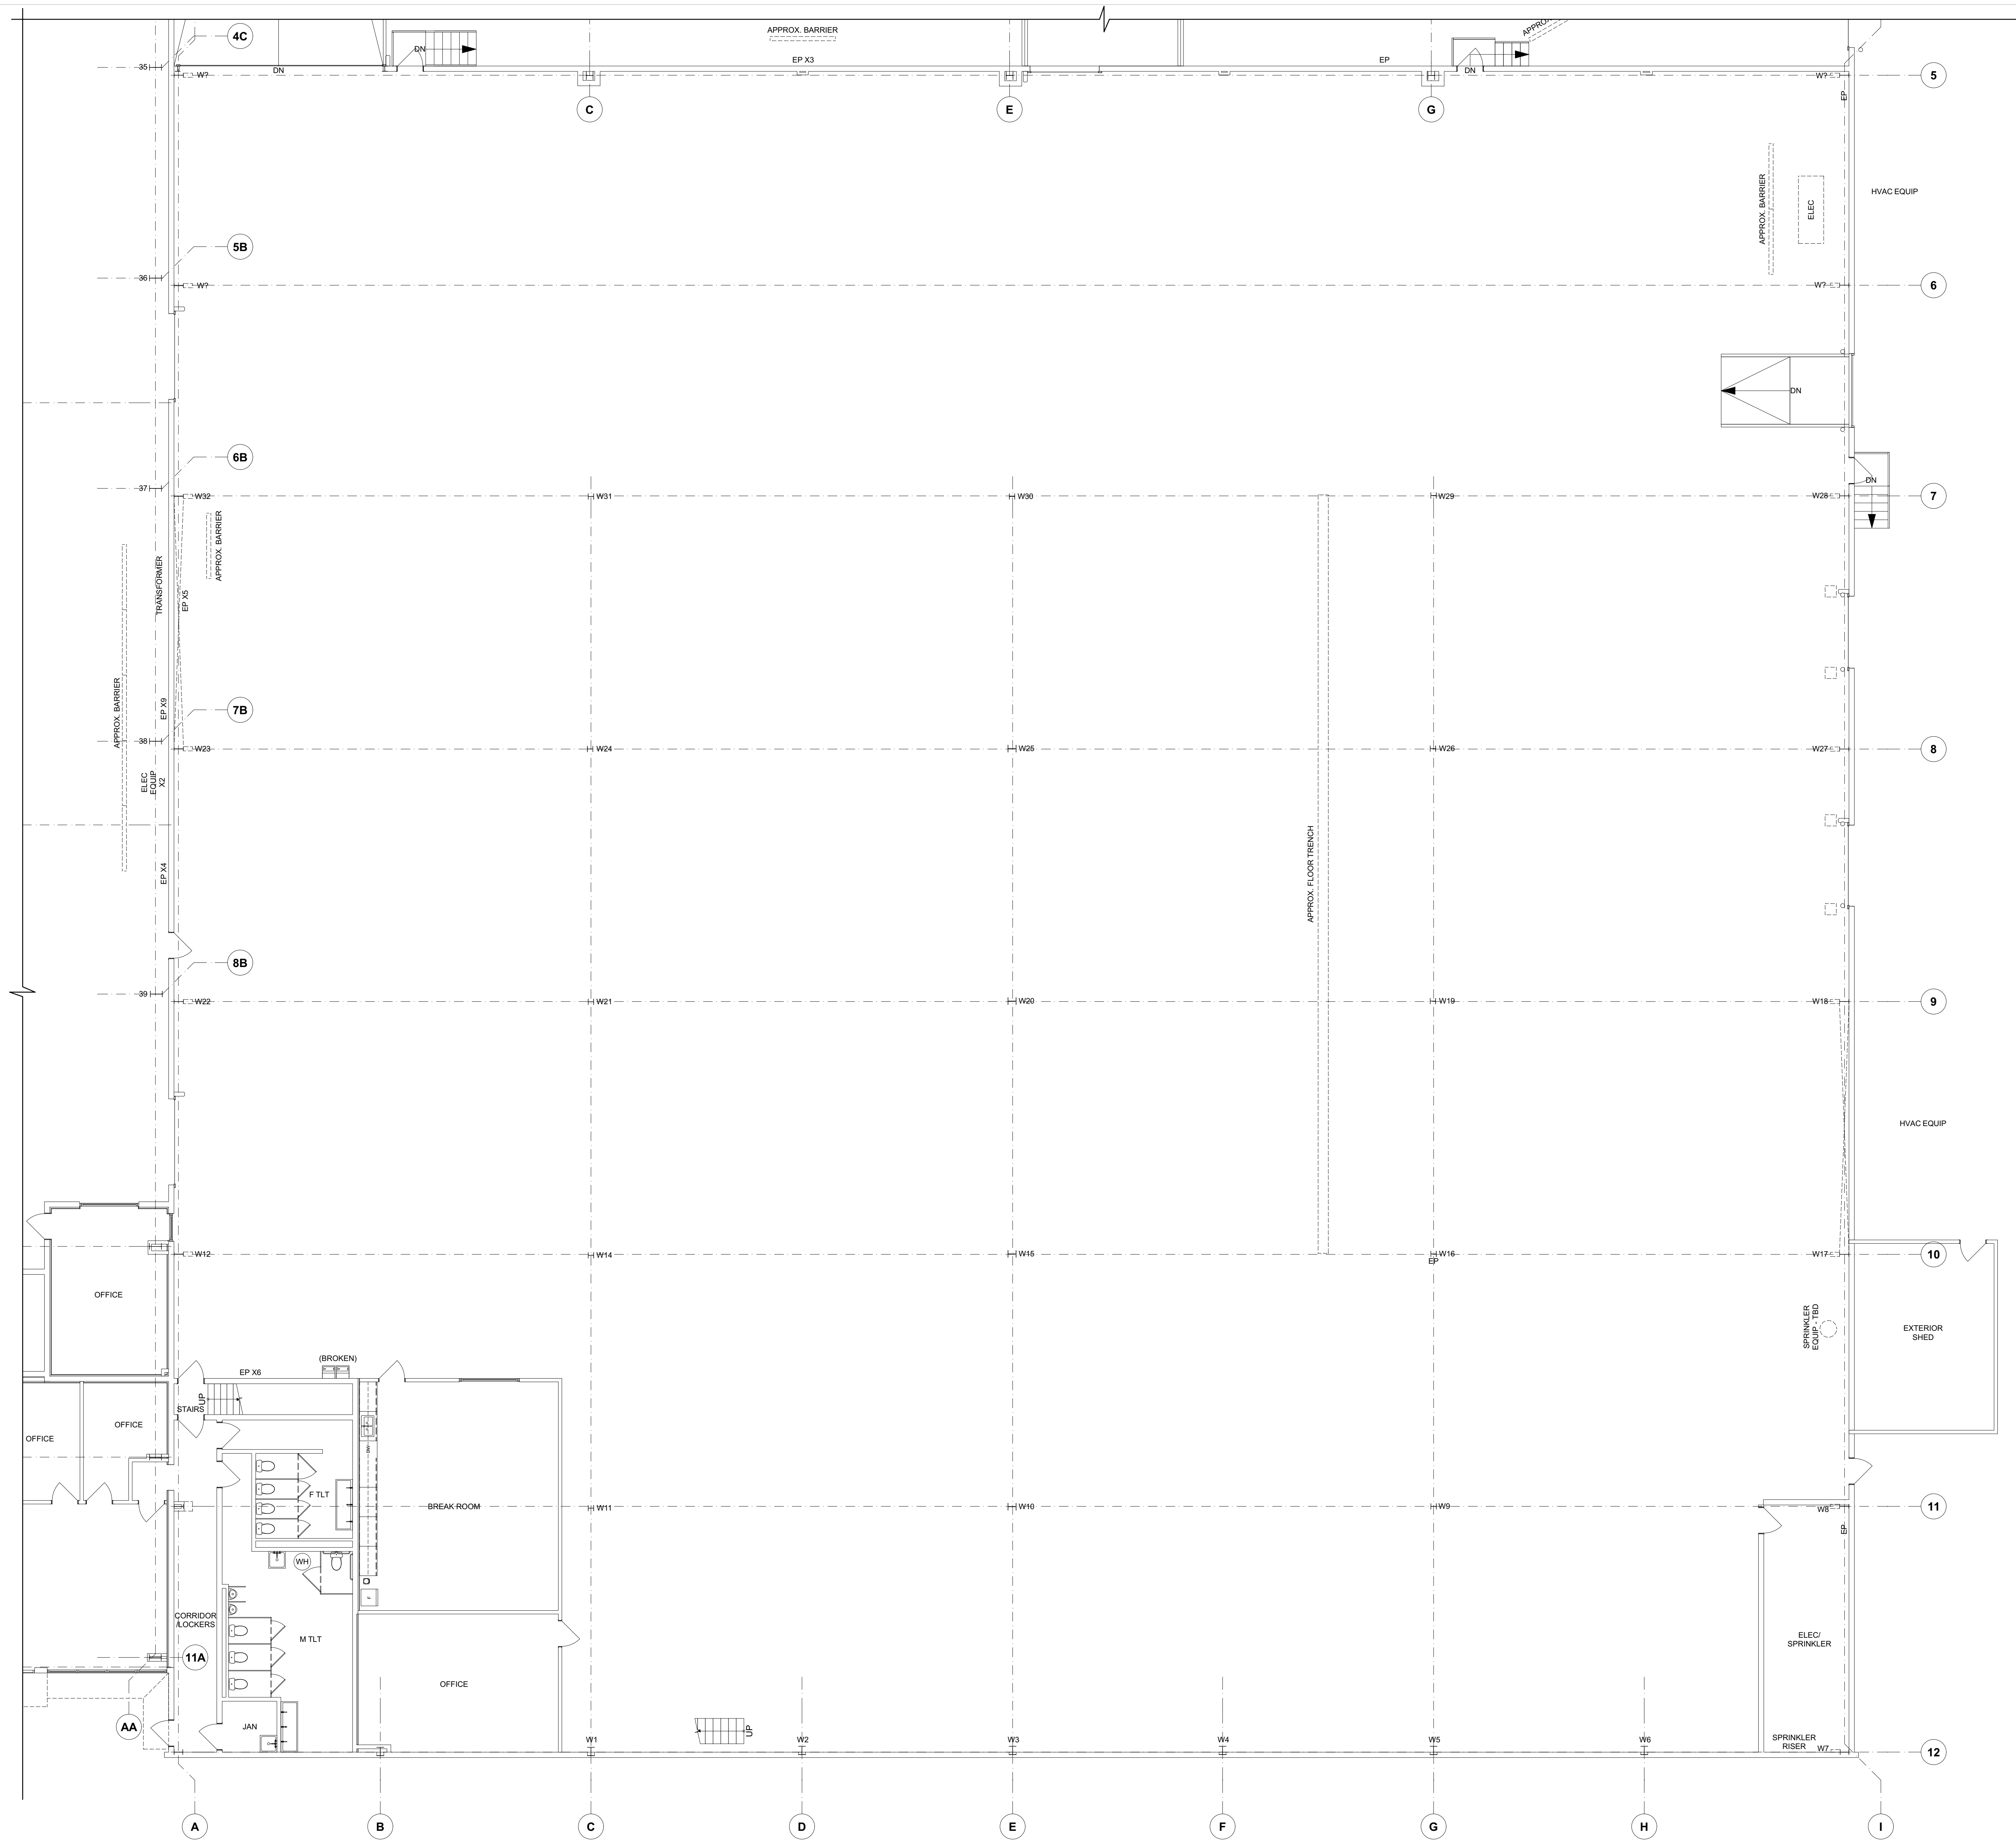

41
03 FLOOR PLAN - 1ST FLOOR - RIGHT HALF FRONT
SCALE: 1/8" = 1'-0"




3550 LEE HILL DR. WAREHOUSE AS-BUILTS
3550 LEE HILL DR FREDERICKSBURG, VA 22408



3550 LEE HILL DR. WAREHOUSE AS-BUILTS

3550 LEE HILL DR FREDERICKSBURG, VA 22408

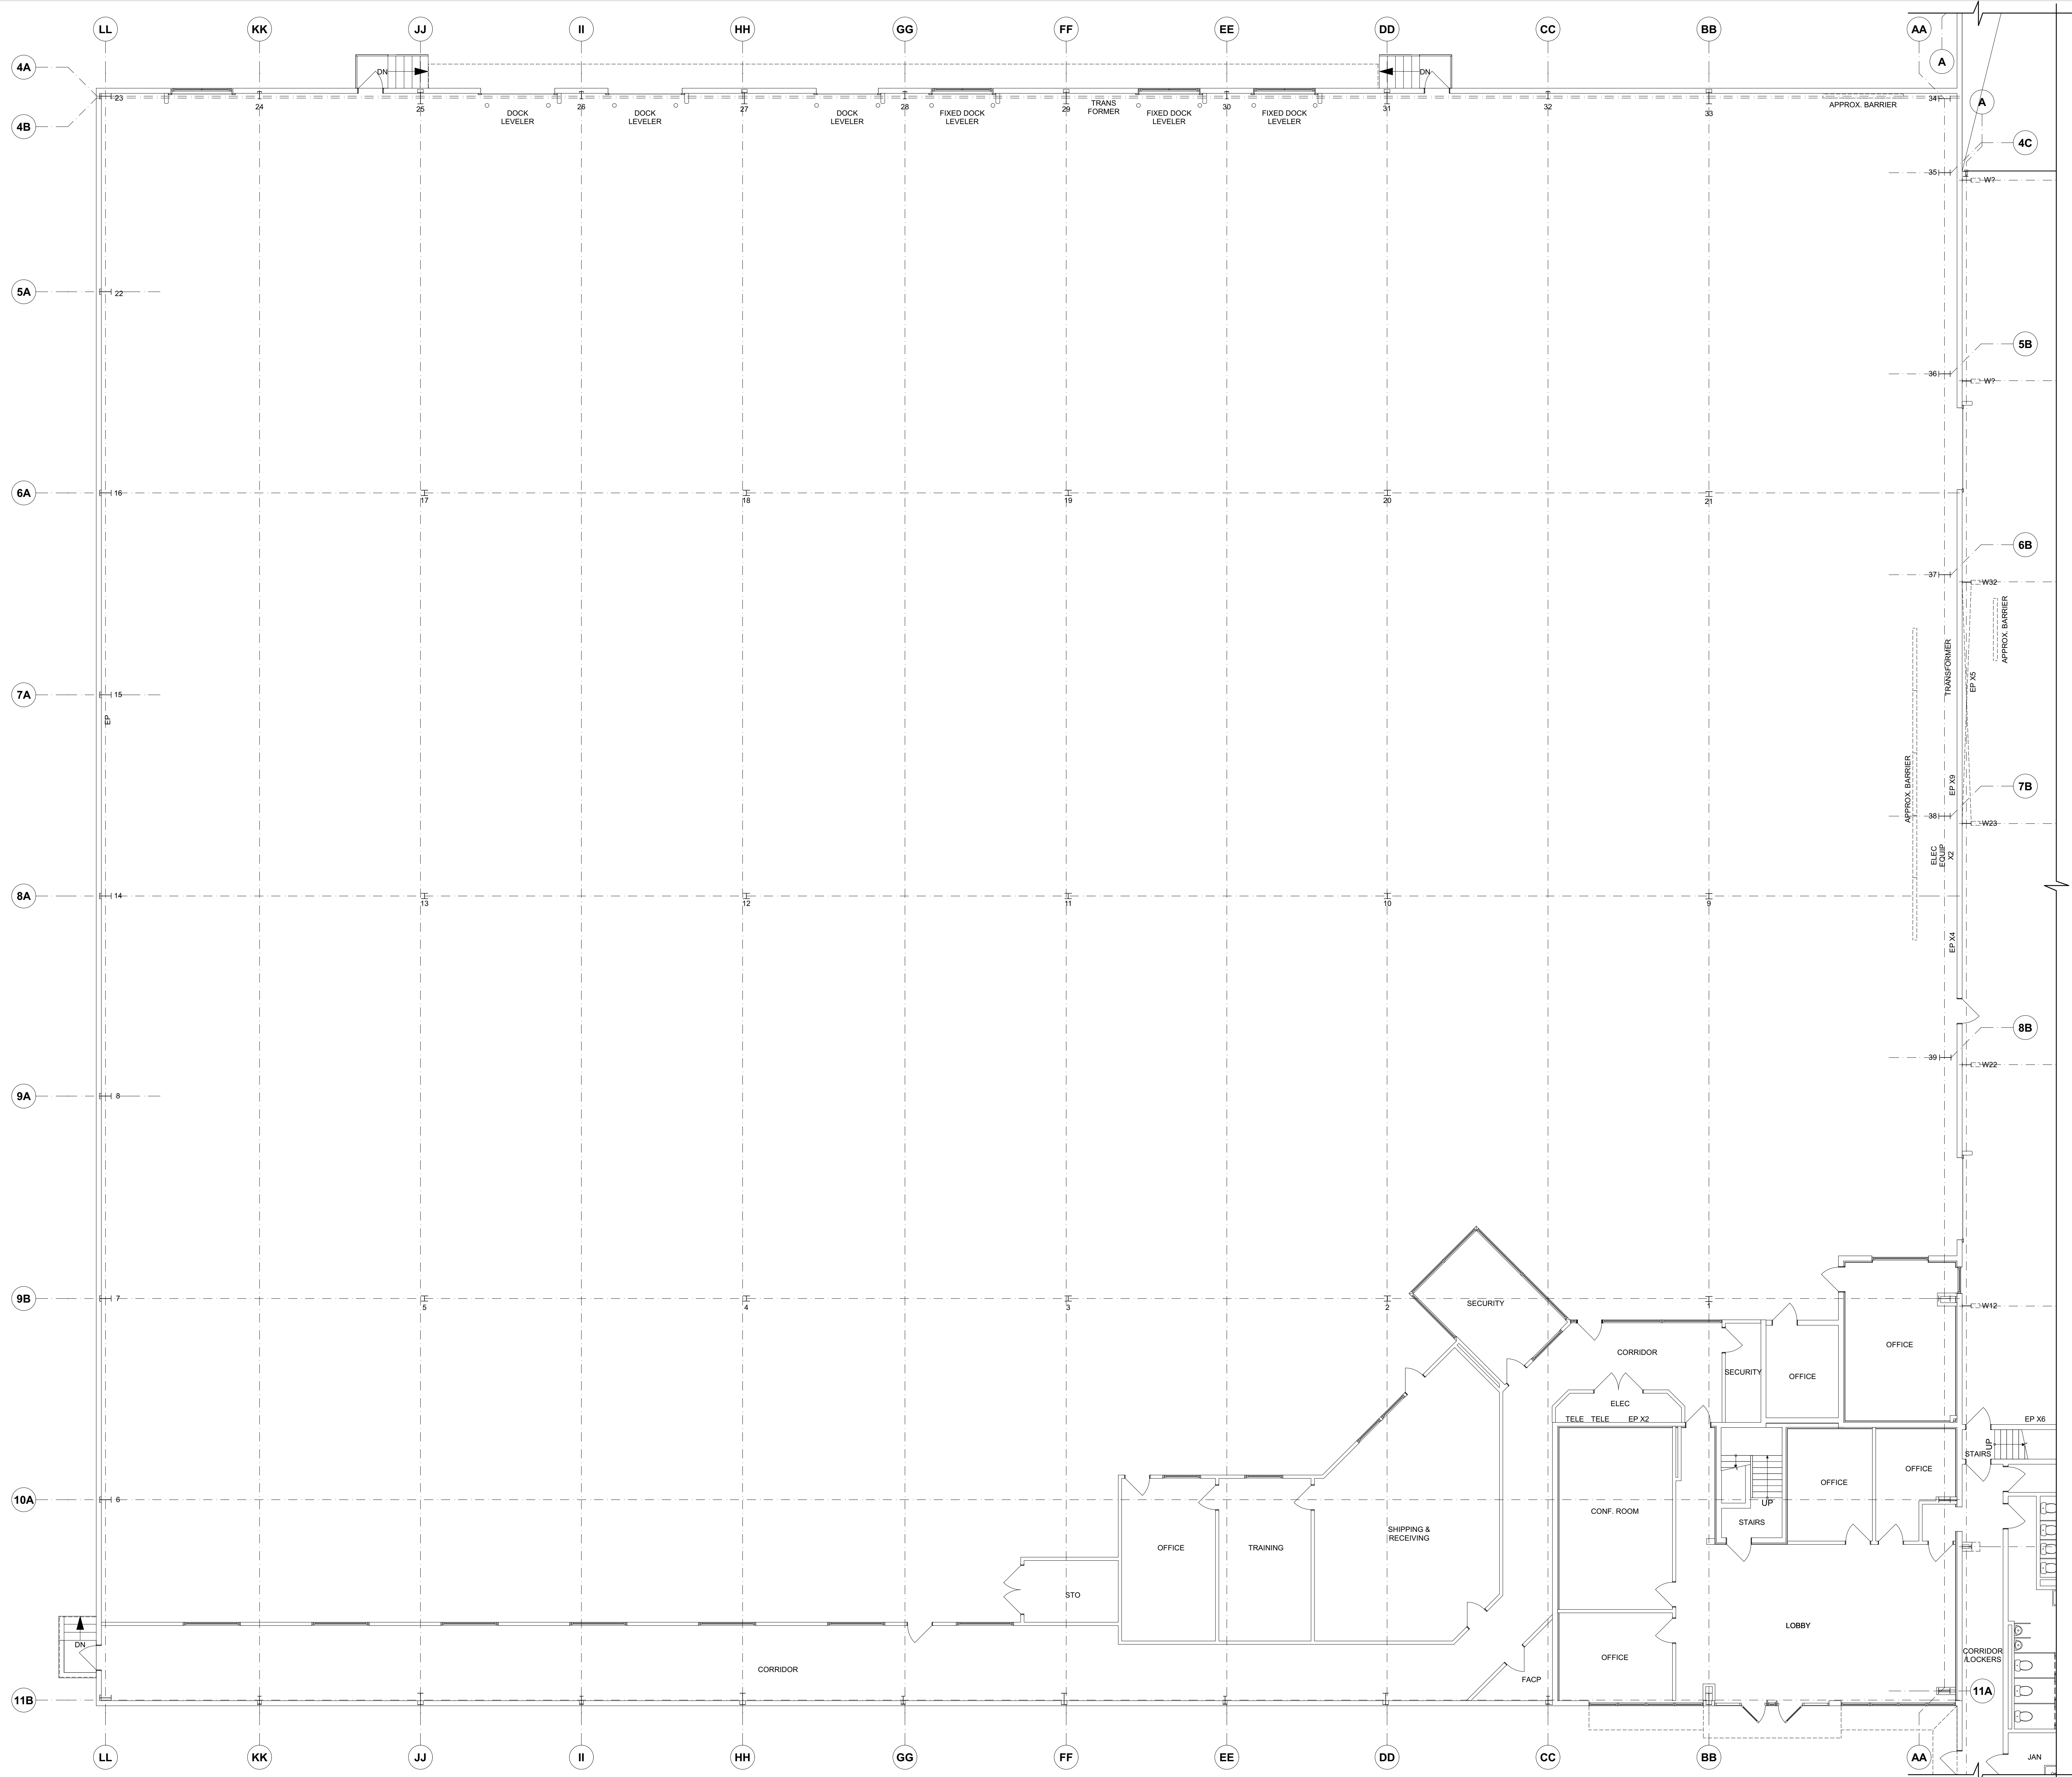


41
05 FLOOR PLAN - 1ST FLOOR - LEFT HALF
SCALE: 1/8" = 1'-0"




3550 LEE HILL DR. WAREHOUSE AS-BUILTS

3550 LEE HILL DR FREDERICKSBURG, VA 22408

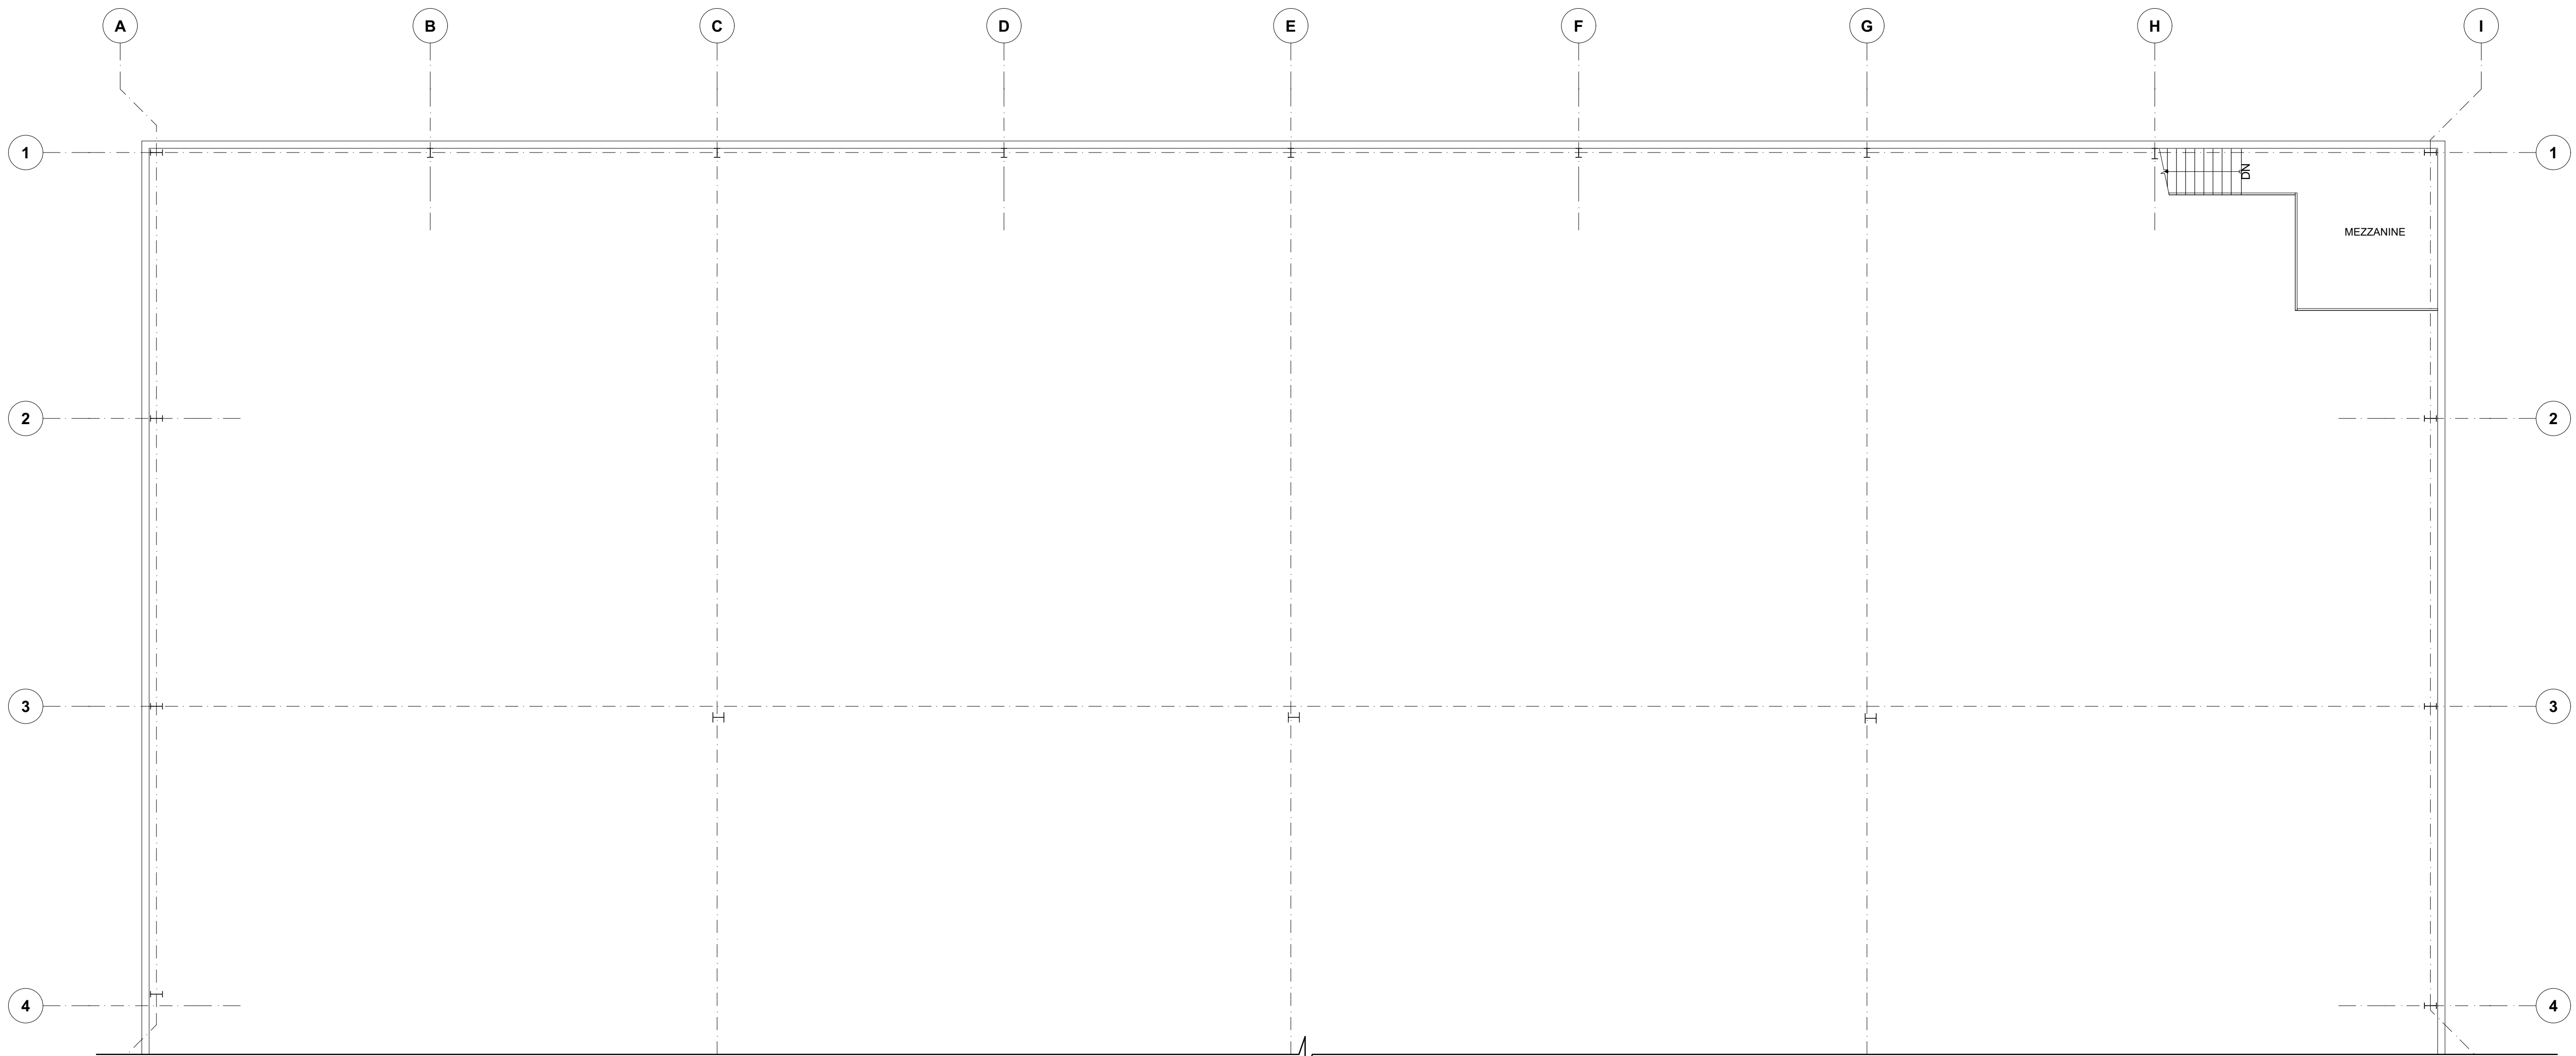

45
06 FLOOR PLAN - 2ND FLOOR - REAR
SCALE: 1/8" = 1'-0"

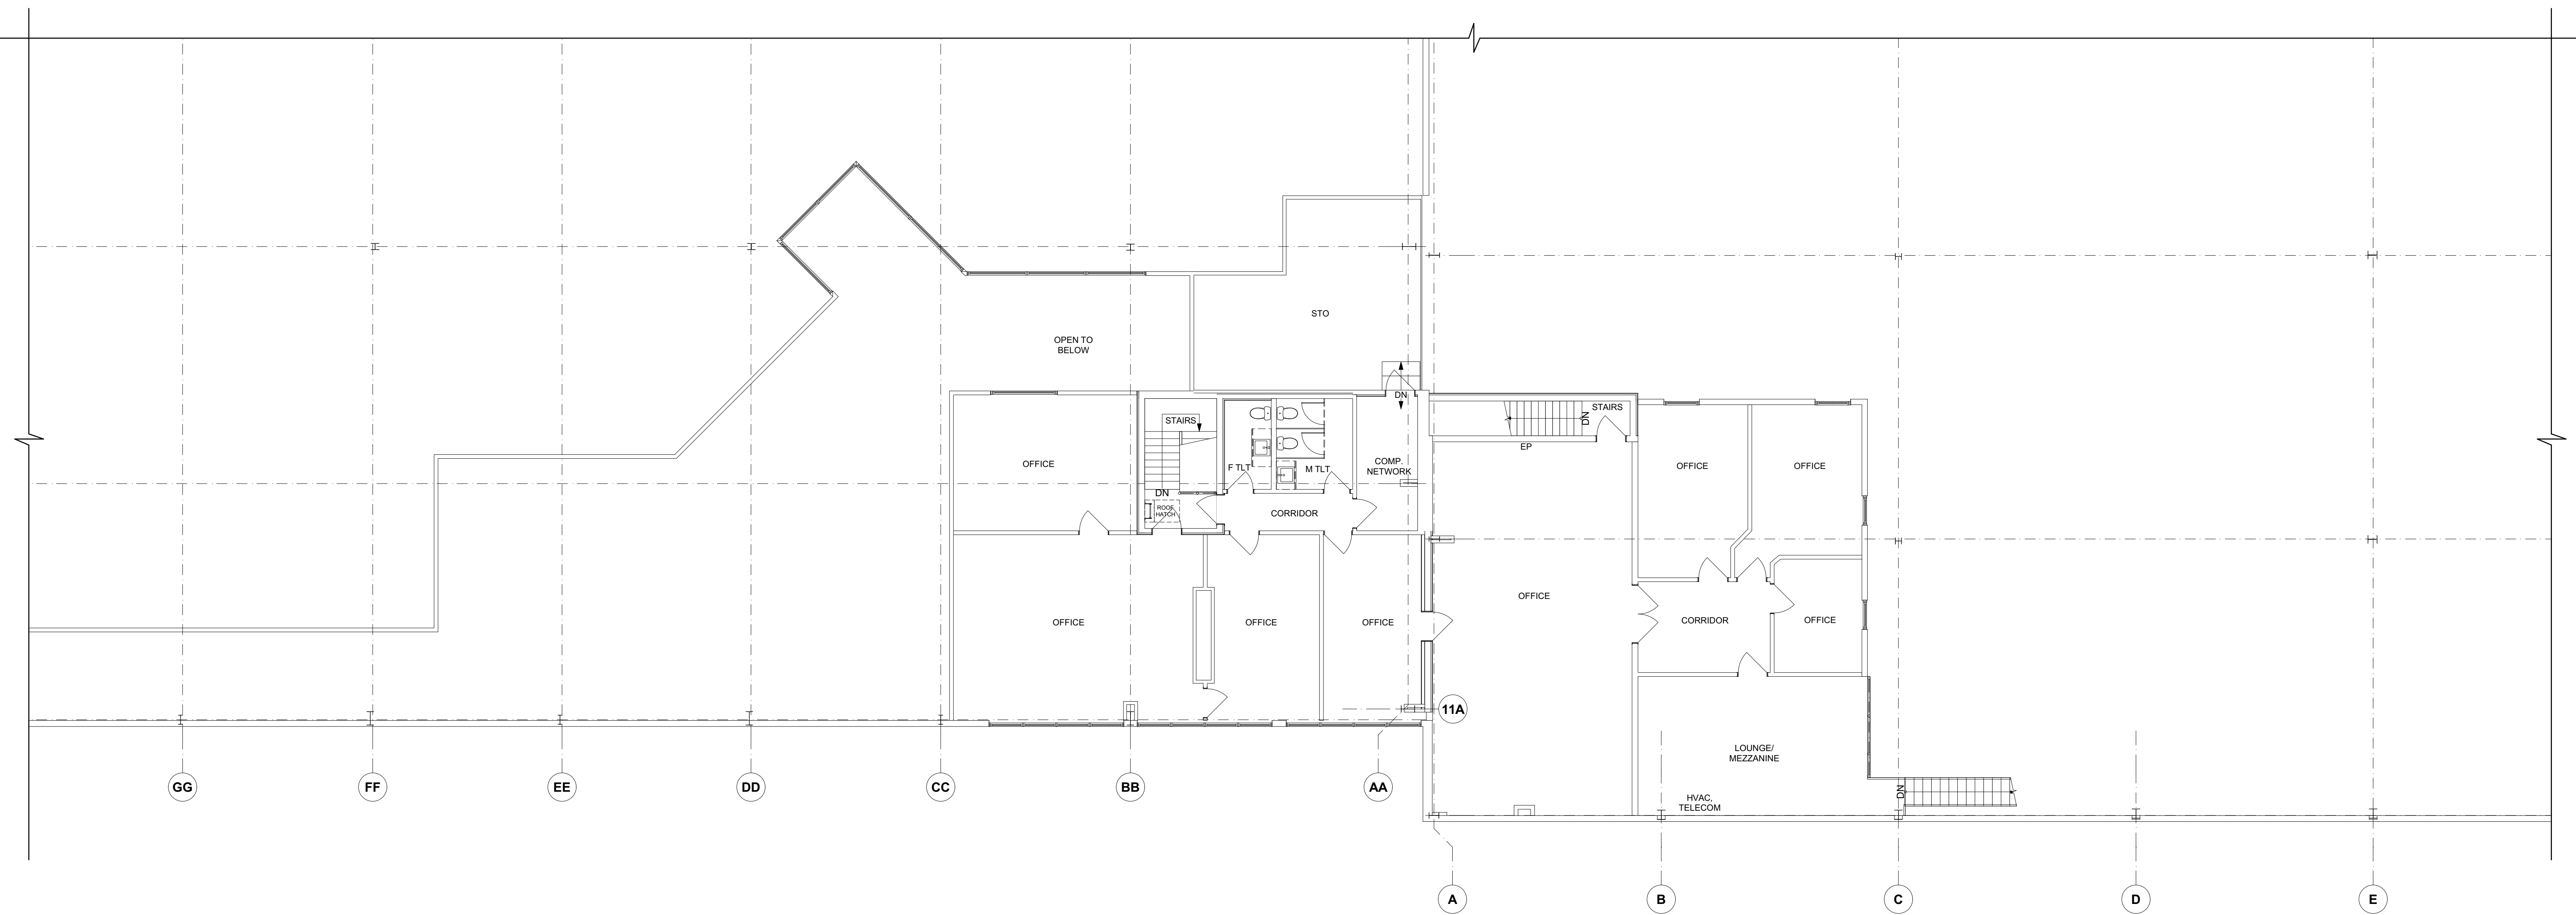

41
06 FLOOR PLAN - 2ND FLOOR - FRONT
SCALE: 1/8" = 1'-0"