

AVAILABILITY

7 at UNION PARK, 3RD FLOOR


LOCATION 6965 UNION PARK AVE. 84047

SF / COST 21,830 / \$28.00-28.50 PSF

STATUS AVAILABLE, CAN BE DEMISED INTO 3 SUITES, SUITE 300 = 10,714 RSF, SUITE 310 = 4,286 & SUITE 320 = 6,830 RSF

AS BUILT FLOOR PLAN


SUITE 300
21,830 SF

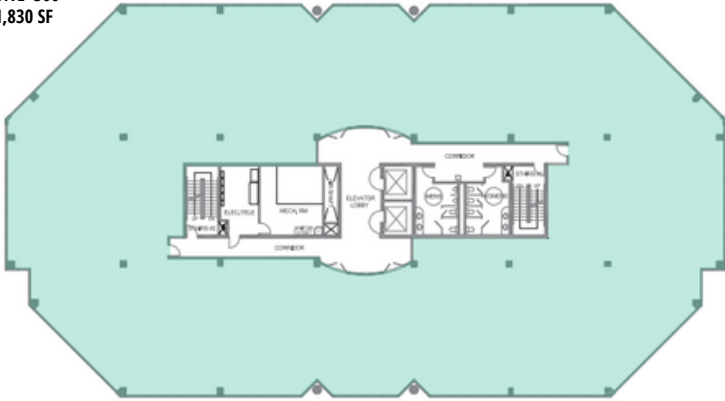

POTENTIAL FLOOR PLAN

SUITE 320
6,773 SF

SUITE 310
4,228 SF

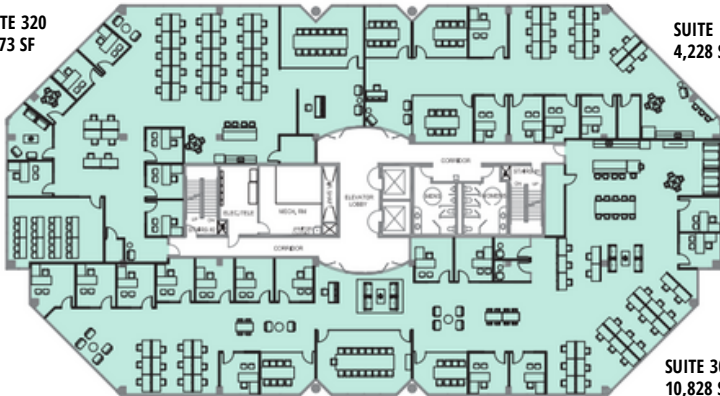

SUITE 300
10,828 SF



AVAILABILITY

7 at UNION PARK, 3RD FLOOR

LOCATION 6965 UNION PARK AVE. 84047

SF / COST 21,829 / \$28.00-28.50 PSF

STATUS AVAILABLE, CAN BE DEMISED INTO 3 SUITES, SUITE 300 = 10,828 RSF, SUITE 310 = 4,228 & SUITE 320 = 6,773 RSF



FUTR.