




BUILDING INFORMATION

	SQFT	BUILDING PERCENTAGE
OFFICE:	9,790	54%
PRODUCTION:	3,552	20%
WAREHOUSE:	4,747	26%
TOTAL AREA:	18,089	
Deck Height:		22'-6" +/-
Clear Height:		18'-6" +/-
Ceiling Height:		VARIES
Sprinklered:		YES
Mechanical Area:		YES

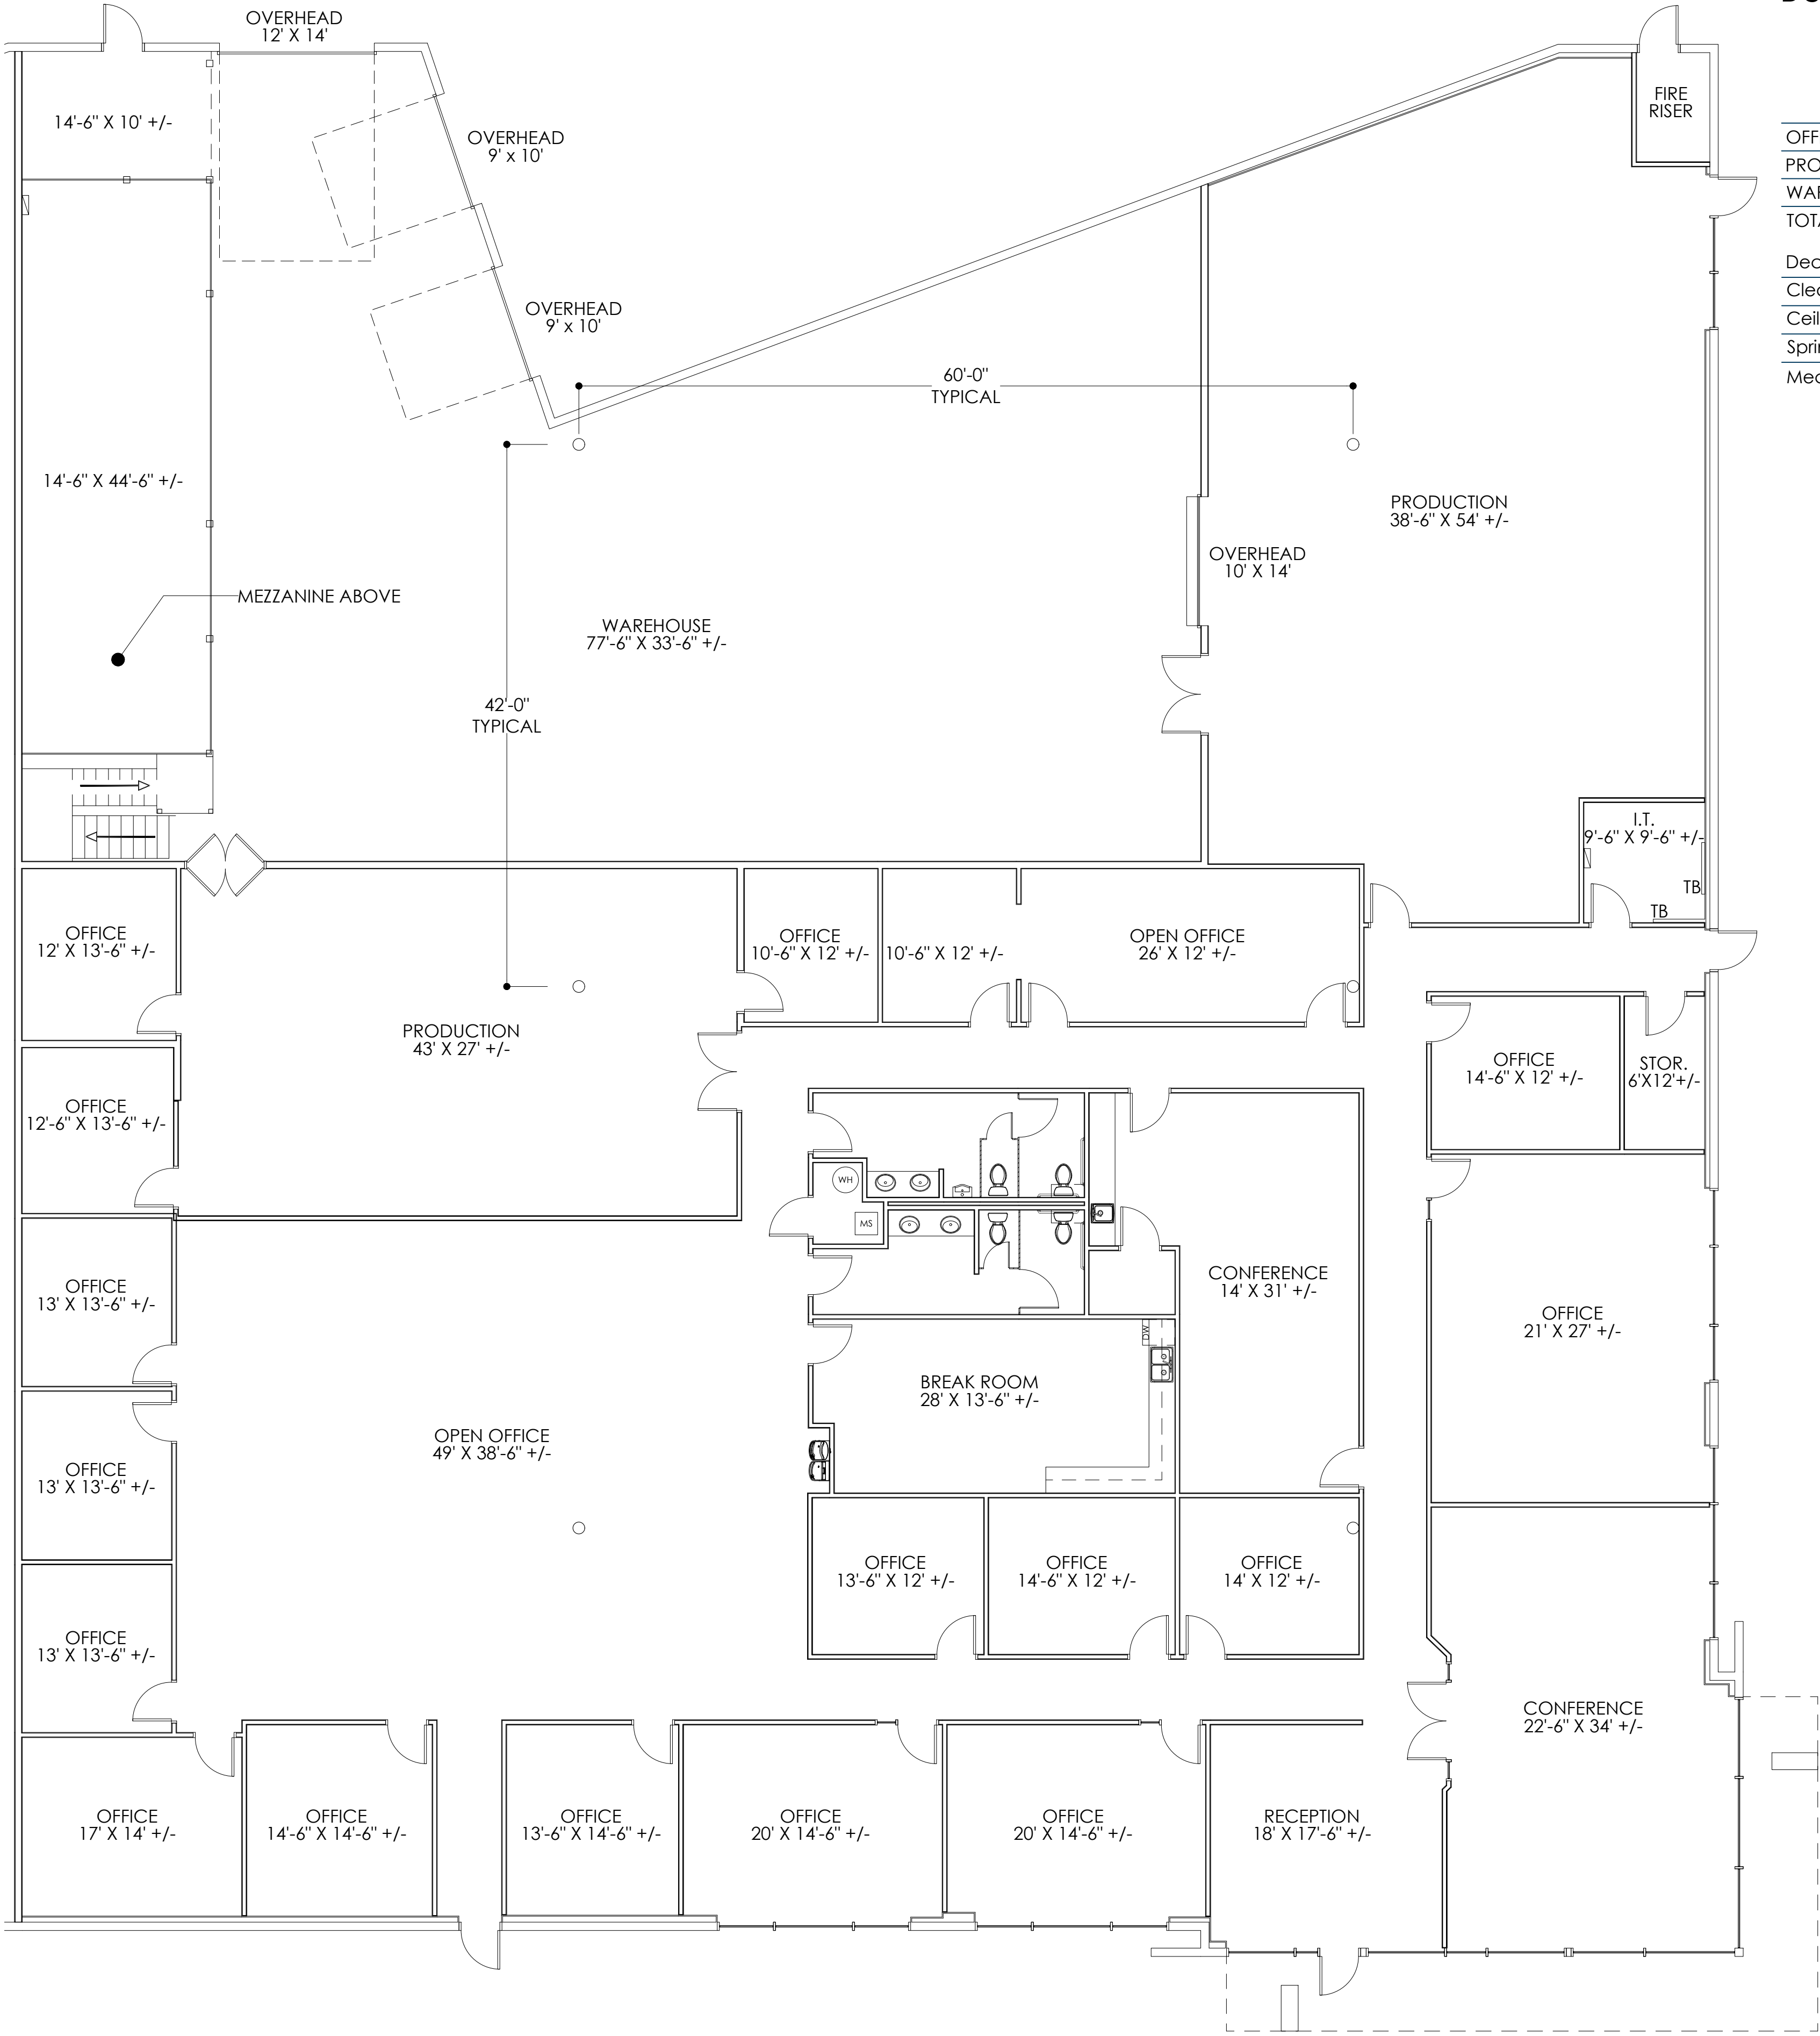

A 18,089 RSF AS BUILT PLAN
AVAILABLE FOR LEASE

2805 E PLANO PARKWAY
SUITE 100
PLANO, TEXAS 75074

Copyright © 2025
Space Planning Specialists
These drawings, or parts
thereof, may not be
reproduced in any form, by
any method, for any
purpose, without prior
written consent from Space
Planning Specialists

SPACE PLANNING SPECIALISTS
COMMERCIAL SPACE PLANNING
& INTERIOR DESIGN
(972) 414-9391
SpacePlanningSpecialists.com

SCALE: 1/8" = 1'-0"
on 36"x24" plot
ISSUE DATES:
05/22/2025
AS BUILT

AS BUILT FLOOR PLAN

