


REGULAR

ARCHITECTURE

COPYRIGHT

THESE PLANS ARE AN INSTRUMENT OF SERVICE AND ARE THE PROPERTY OF REGULAR ARCHITECTURE, LLC, AND MAY NOT BE DUPLICATED, DISCLOSED, OR REPRODUCED WITHOUT THE WRITTEN CONSENT OF REGULAR ARCHITECTURE, LLC. COPYRIGHTS AND INFRINGEMENTS WILL BE ENFORCED AND PROSECUTED.

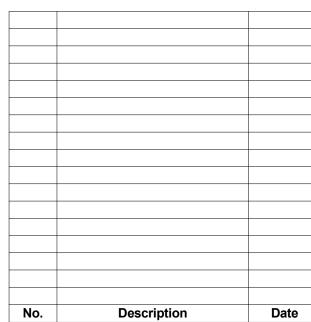


WAREHOUSE

1745 N ERIE

AS BUILT
Issue Date
Drawn by Author
Checked by hecker

AS BUILT 000

ale 1/8" = 1'-0"

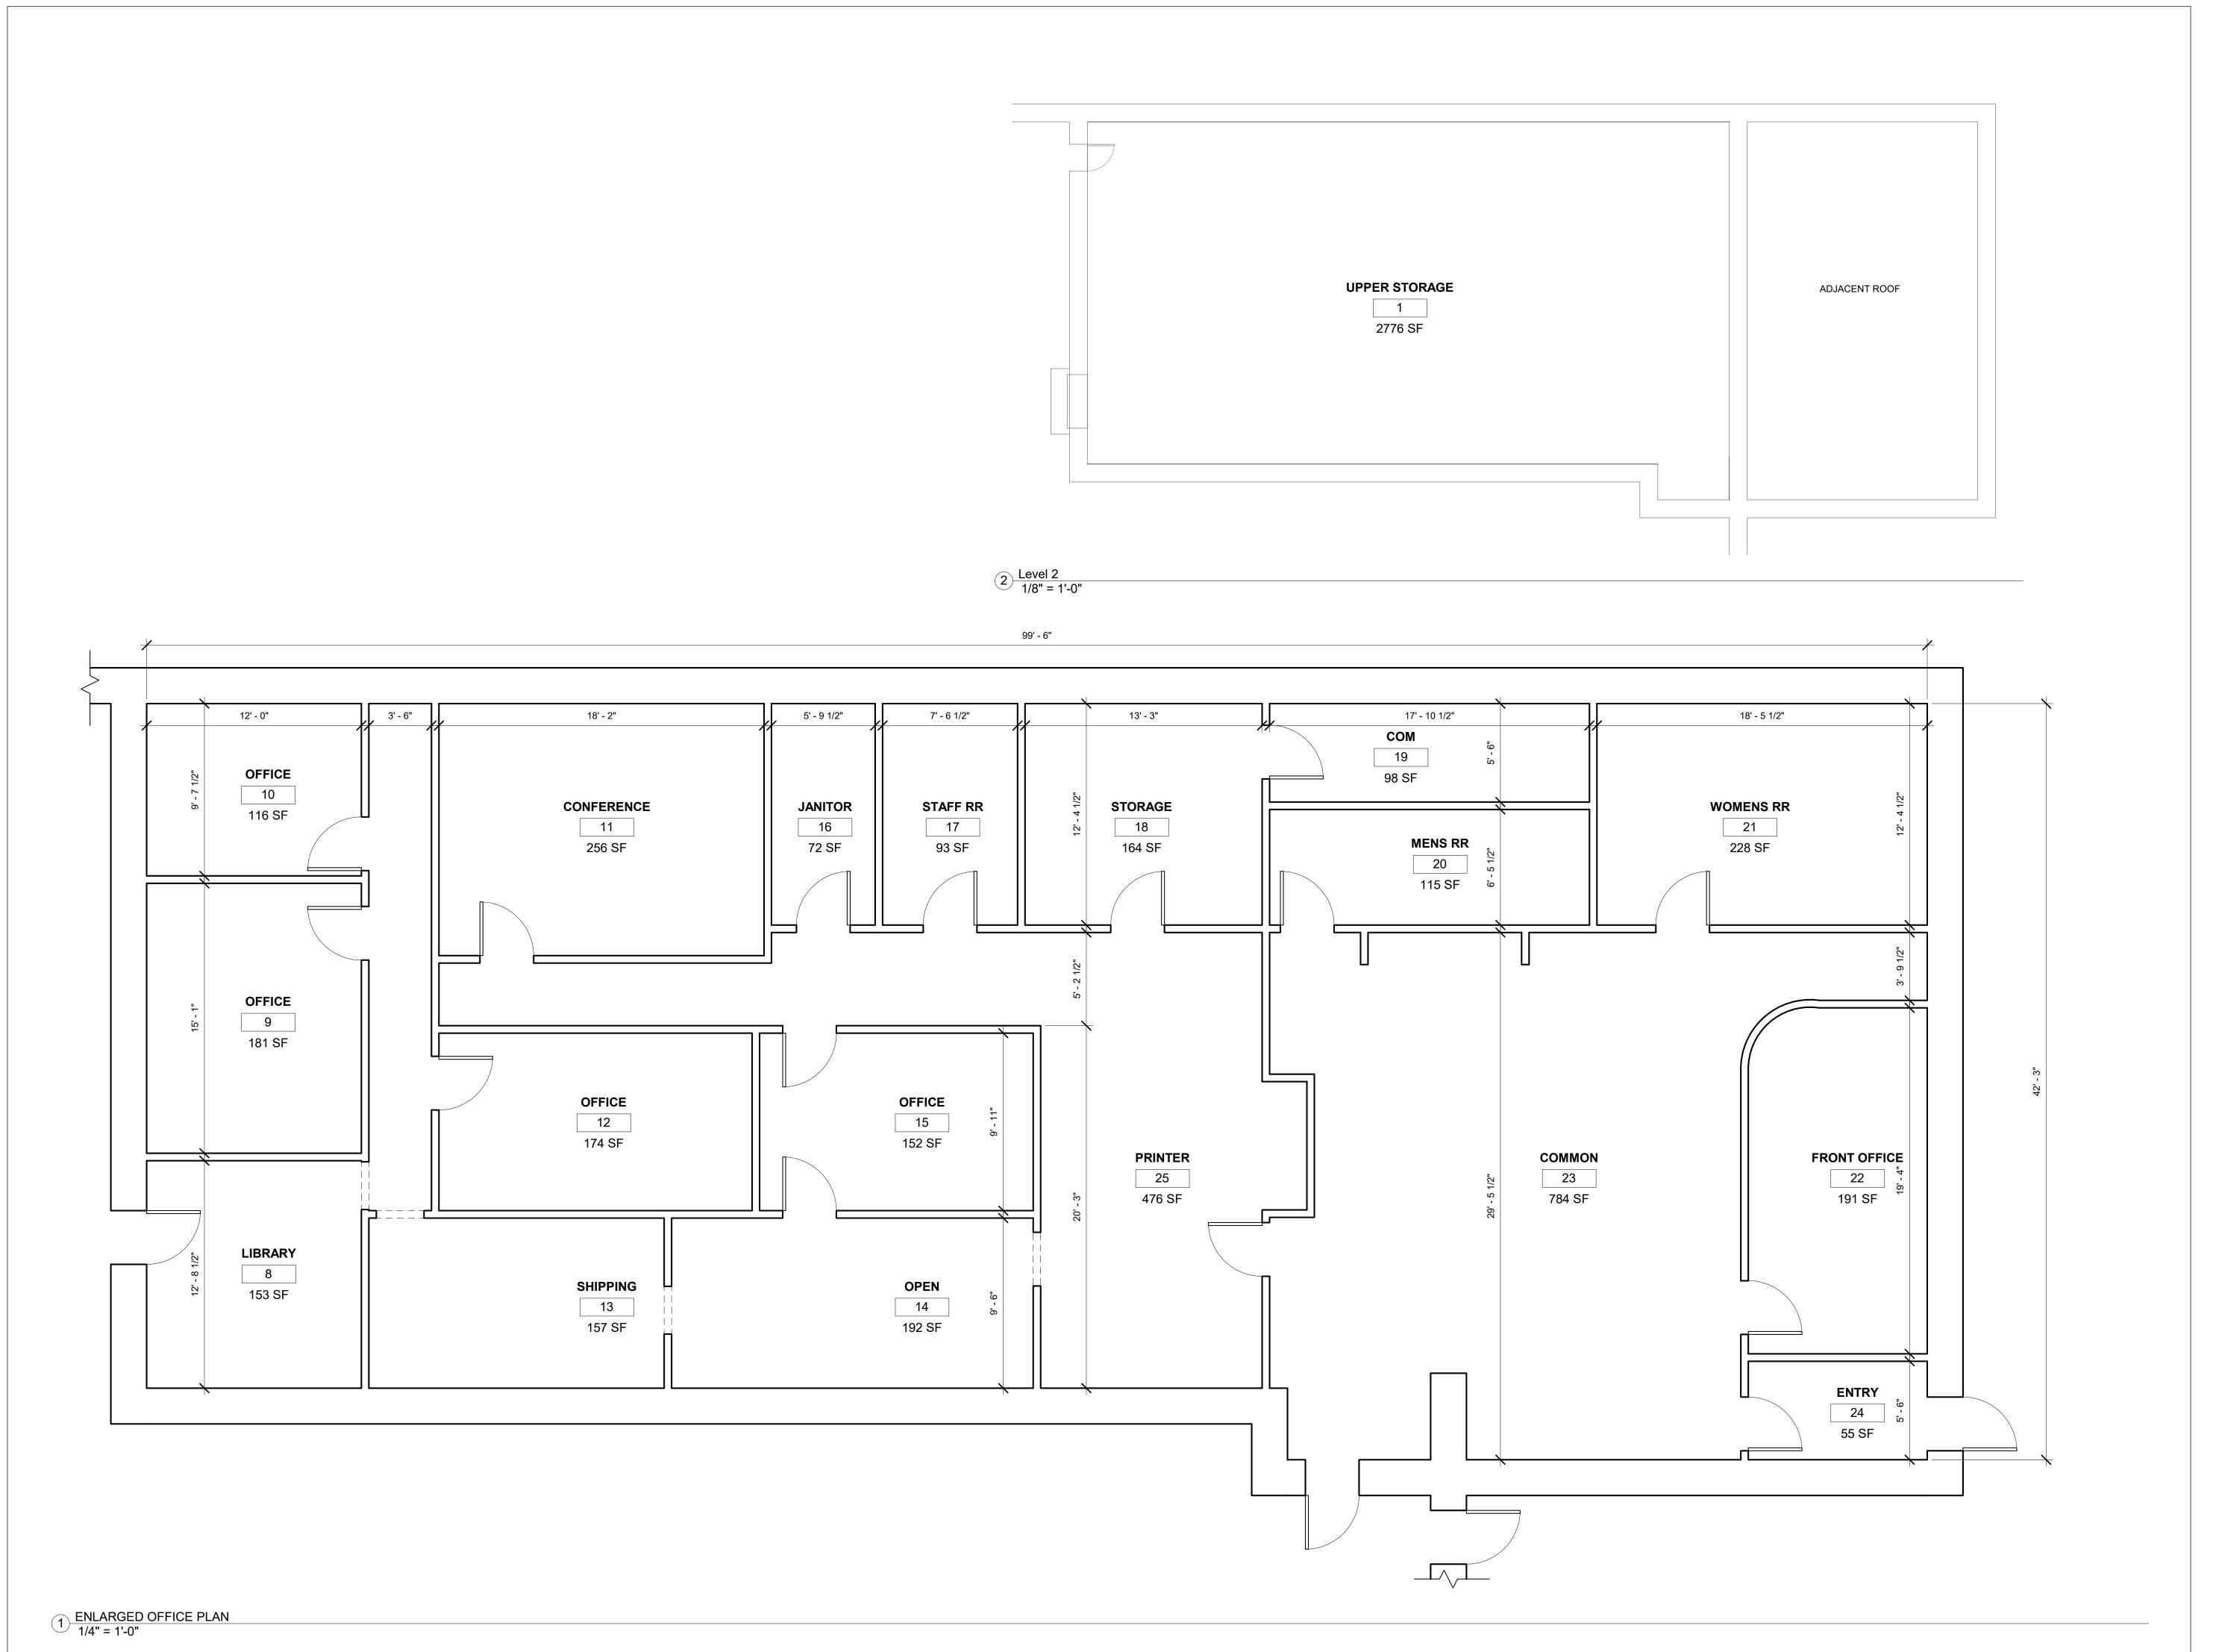


REGULAR

ARCHITECTURE

COPYRIGHT

THESE PLANS ARE AN INSTRUMENT OF SERVICE AND ARE THE PROPERTY OF REGULAR ARCHITECTURE, LLC, AND MAY NOT BE DUPLICATED, DISCLOSED, OR REPRODUCED WITHOUT THE WRITTEN CONSENT OF REGULAR ARCHITECTURE, LLC. COPYRIGHTS AND INFRINGEMENTS WILL BE ENFORCED AND PROSECUTED.

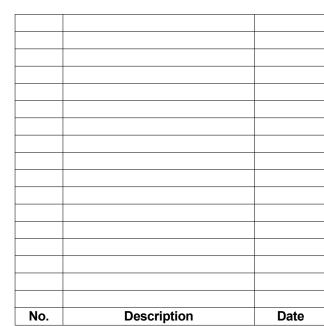

WAREHOUSE

1745 N ERIE

AS BUILT
Issue Date
Drawn by Author
Checked by hecker

AS-BUILT 001

le As indicated