


FLOOR PLAN

SCALE: 1" = 20'-0"

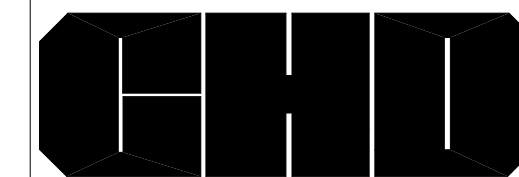

CUSTOM HOME DESIGNS

BY

BILL RASMUSSEN

3398 AUTUMN RIDGE DRIVE
CLEVELAND, TN 37312

BILLRAS53@BELLSOUTH.NET
423-715-0725

AS BUILT PLAN

2000 OVERHEAD BRIDGE ROAD

SHEET NO.

A-1