

1
A-4
1ST FL. AS-BUILT PLAN
SCALE: 1/4" = 1'-0"

TENANT FITOUT
FOR
GOSHEN MAIN ST LLC

PROJECT ADDRESS
224 MAIN ST.
GOSHEN, NY

COHEN
DESIGN / BUILD
ARCHITECT

5512 MERRICK RD.
MASSAPEQUA, NY 11758
(516)799-6022

REVISION		
NO.	DATE	DESCRIPTION

SHEET TITLE
1ST FL. AS-BUILT PLAN


DESIGNED BY
WILLIAM J. COHEN, AIA


DATE
7/15/22

DRAWN BY WJC	CHECKED BY WJC
-----------------	-------------------

SHEET NUMBER

A-4
© 2022
COHEN DESIGN/BUILD ARCHITECT
ALL RIGHTS RESERVED.

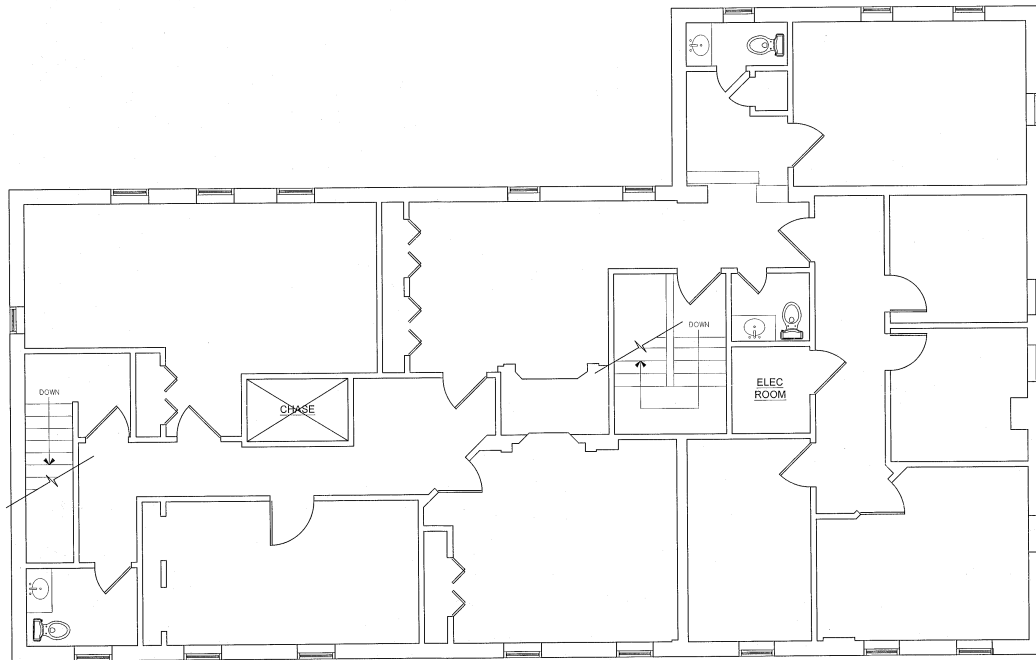

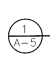
2ND FL. AS-BUILT PLAN
 SCALE: 1/4" = 1'-0"

TENANT FITOUT
 FOR
 GOSHEN MAIN ST LLC

PROJECT ADDRESS:
 224 MAIN ST.
 GOSHEN, NY

COHEN
 DESIGN / BUILD
 ARCHITECT

5512 MERRICK RD.
 MASSAPEQUA, NY 11758
 (516) 788-0022

REVISION		
NO.	DATE	DESCRIPTION

SHEET TITLE:
 2ND FL. AS-BUILT PLAN

WILLIAM J. COHEN, AIA

ISSUE DATE:
 7/15/22

DRAWN BY: WJC	CHECKED BY: WJC
------------------	--------------------

SHEET NUMBER:

A-5

© 2022
 COHEN DESIGN/BUILD ARCHITECT
 ALL RIGHTS RESERVED