

THE DISTRICT

TUSTIN LEGACY

- 1.0 Million square feet
- Entertainment-Lifestyle Center

Entertainment

AMC Tustin 14

Bowlero

Shika Shima Japanese BBQ & Grill

Bar Louie

J. Zhou Oriental Cuisine

The Winery Restaurant & Wine Bar

Lucille's Smokehouse Bar-B-Que

Prego Mediterranean

World of Racing

RGB Run

Lifestyle

Whole Foods Market

Target

Costco

Barnes & Noble

Lowe's

T.J. Maxx/HomeGoods

ULTA Beauty

Planet Fitness

Michaels



POPULATION

1-mile

20,597

3-mile

181,934

5-mile

578,760



AVG HH INCOME

1-mile

\$158,304

3-mile

\$153,094

5-mile

\$159,498



DAYTIME POPULATION

1-mile

28,825

3-mile

280,410

5-mile

605,116

TRAFFIC COUNTS

Jamboree 75,000 cars per day | Barranca 36,000 cars per day



For More Information,
Please Contact:


Wally Limburg CalBRE Lic: 00468578
949.500.1396 | wally.limburg@SRA-re.com

NWC Jamboree & Barranca • Tustin, CA



AVAILABLE SPACES

1,665 SF • 1,157 SF

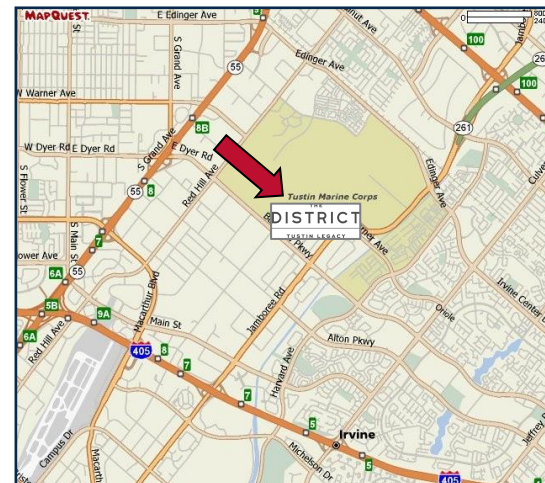

Managed by





1,665 SF AVAILABLE



1,157 SF AVAILABLE



AVAILABLE SPACES	
Suite #	Size
S003J	1,665 SF
S003L	1,157 SF

Shops 1	
Costco	1,665 SF
Costco	1,665 SF
Costco	1,665 SF

Shops 2	
Costco	1,665 SF
Costco	1,665 SF

Shops 3	
Costco	1,665 SF
Costco	1,665 SF
Shops 4	
Costco	1,665 SF
Costco	1,665 SF
Shops 5	
Costco	1,665 SF
Costco	1,665 SF
Shops 6	
Costco	1,665 SF
Costco	1,665 SF
Shops 7	
Costco	1,665 SF
Costco	1,665 SF
Site Area
100 Acres
Building Area
1,000,000 Square Feet
Parking
4,833 Spaces

THE DISTRICT TUSTIN LEGACY Tustin, California

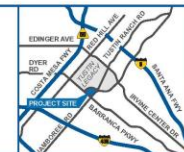


SEC of Jamboree Road & Barranca Parkway
brr
ARCHITECTURE



1,665 SF AVAILABLE



1,157 SF AVAILABLE

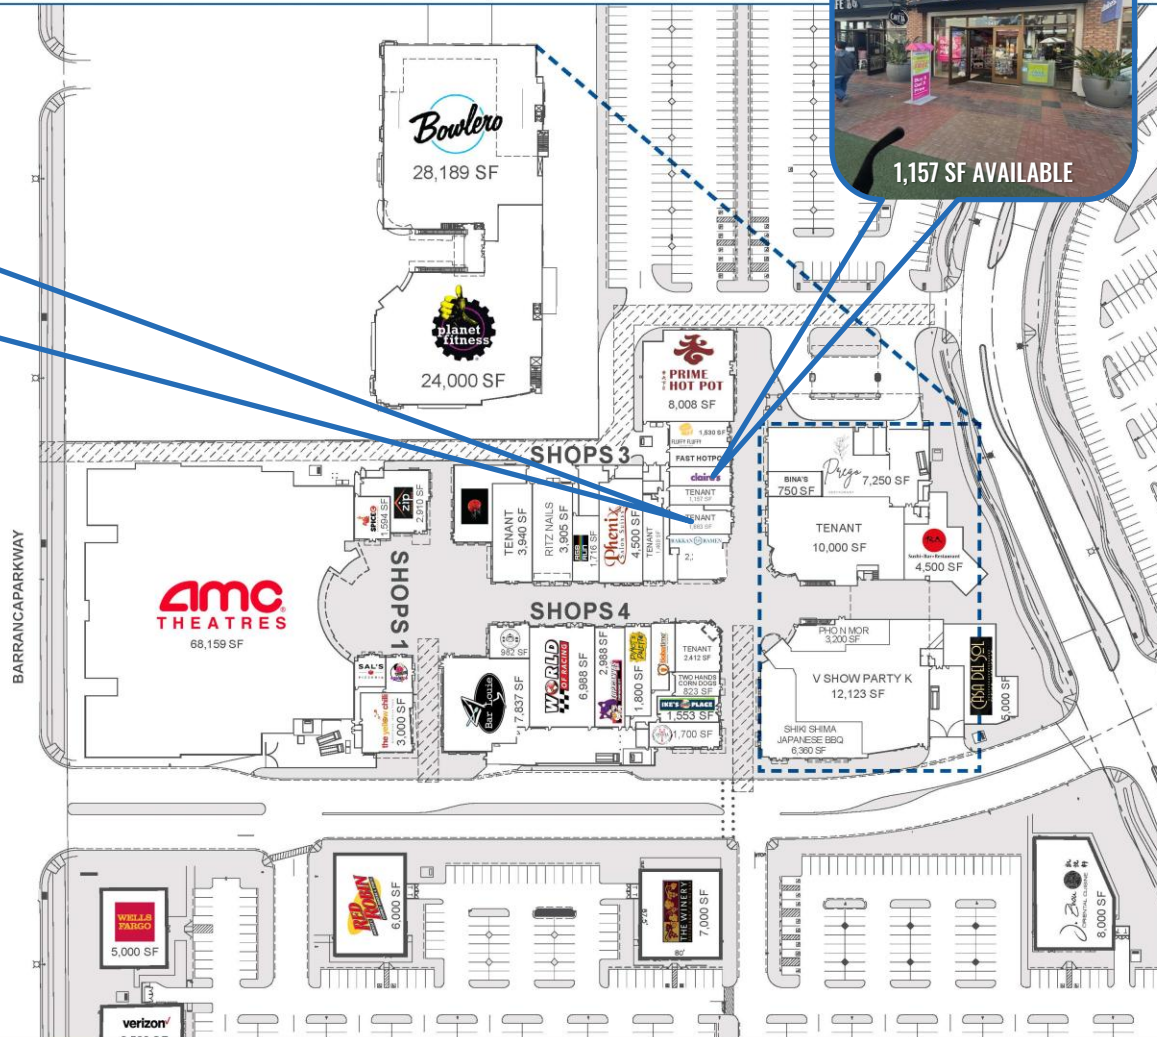

AVAILABLE SPACES	
Suite #	Size
S003J	1,665 SF
S003L	1,157 SF

Shops 1	
Clare's	1,665 SF
Clare's	1,665 SF
Clare's	1,665 SF

Shops 3	
Clare's	1,665 SF
Clare's	1,665 SF
Shops 4	
Clare's	1,665 SF
Clare's	1,665 SF

Site Area
100 Acres
Building Area
1,000,000 Square Feet
Parking
4,833 Spaces


THE DISTRICT TUSTIN LEGACY Tustin, California



SEC of Jamboree
Road & Barranca
Parkway



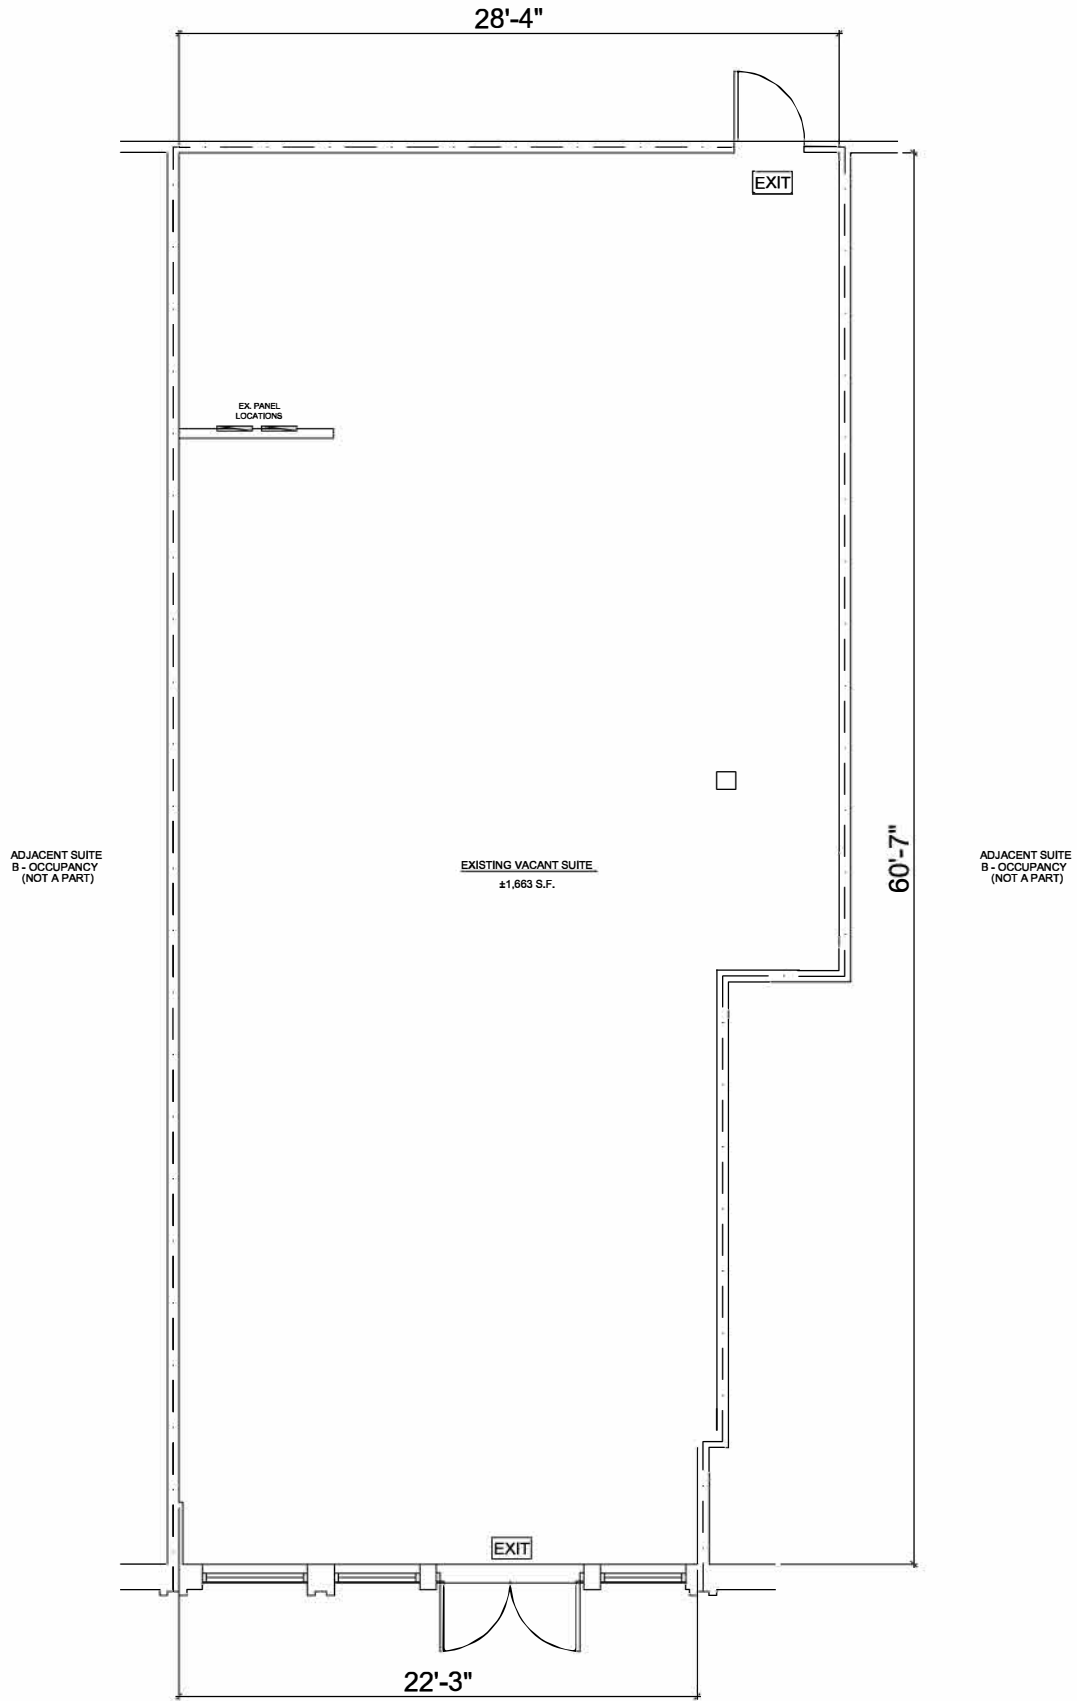

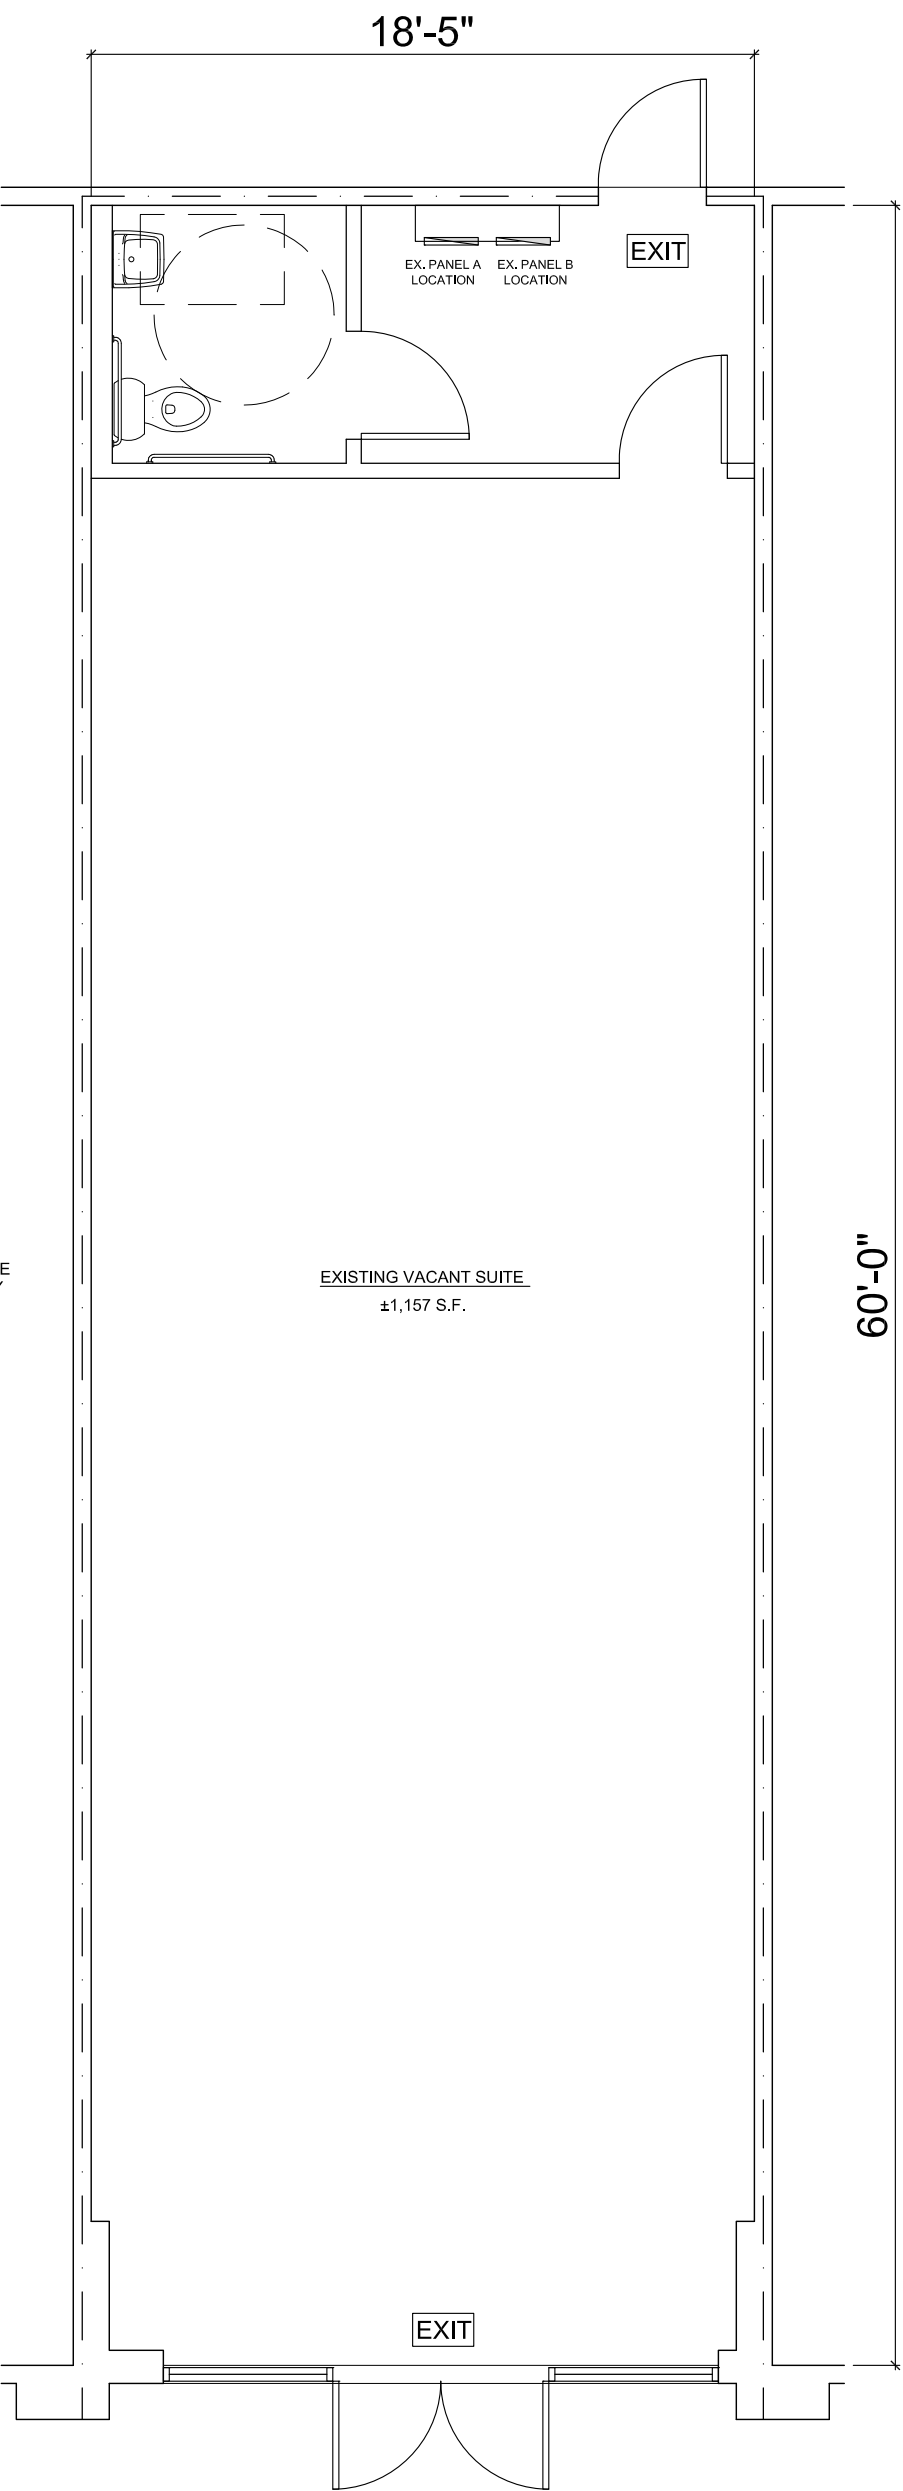

1

EXISTING AS-BUILT FLOOR PLAN

DISTRICT AT TUSTIN LEGACY
2421 PARK AVE.
TUSTIN, CA 92782

SCALE: 3/16"=1'-0"



KEVIN R. BARNES
ARCHITECT

THE DISTRICT

TUSTIN LEGACY

NWC Jamboree Rd & Barranca Pkwy
Tustin, CA



STRATEGIC RETAIL ADVISORS