


Property Key

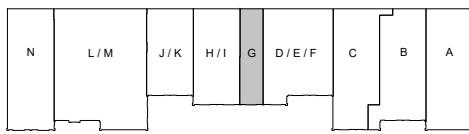

Total Area - 2,575 SF

Starkey As Built Marketing Package

12505 Starkey Road, Largo, FL 33773

Building: 12505

Suite: G

Sheet: A-5


Scale: Not to Scale
Sheet Size: 8.5" x 11"
Not For Construction



BAY SPACE

Building Information

DECK HEIGHT:	Not Accessible
CEILING HEIGHT:	9'-10"
CLEAR HEIGHT:	Not Accessible
SPRINKLERED:	Yes

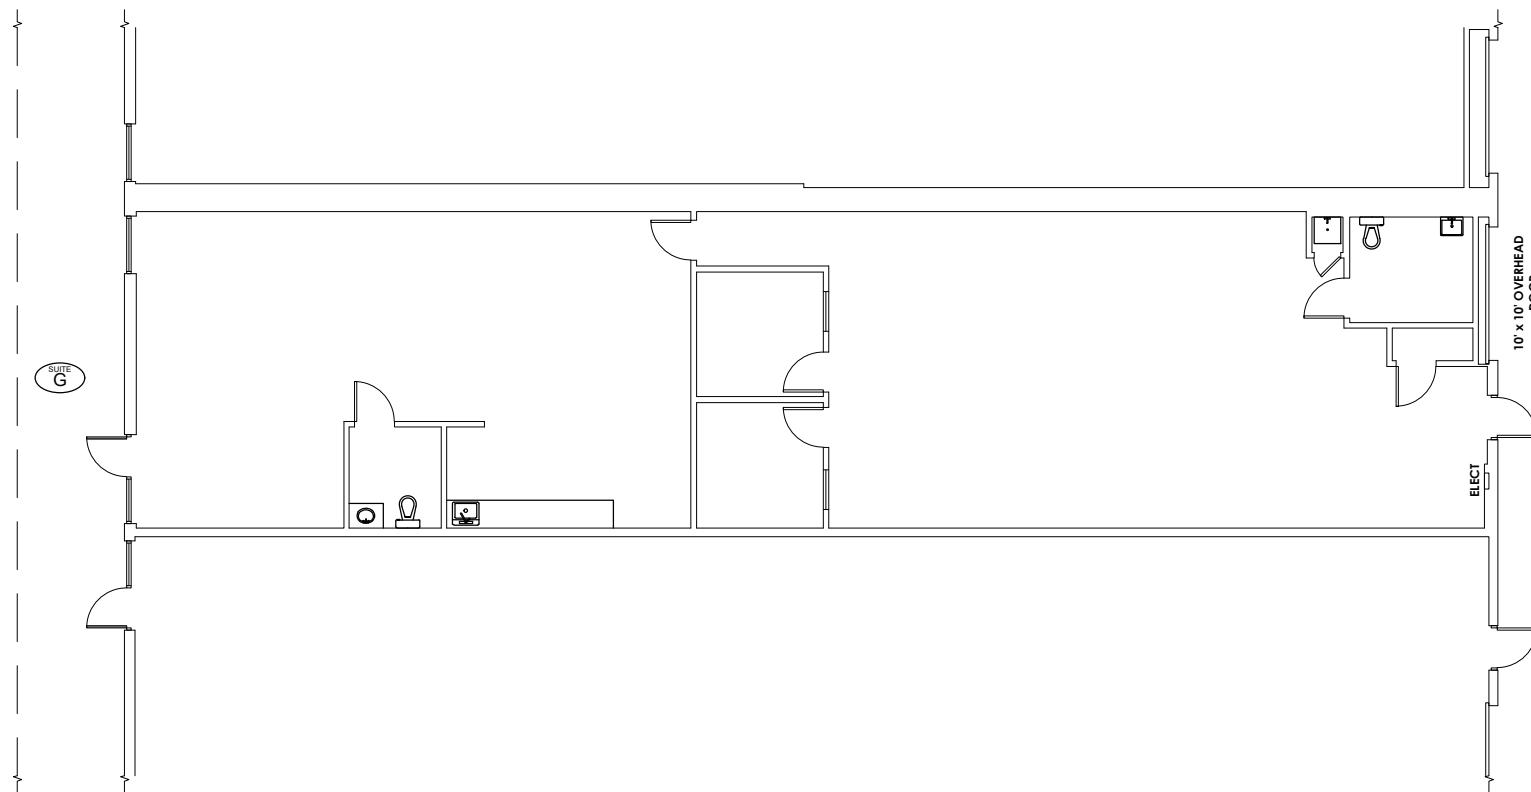

As Built Floor Plan for Marketing

