


# AS BUILT

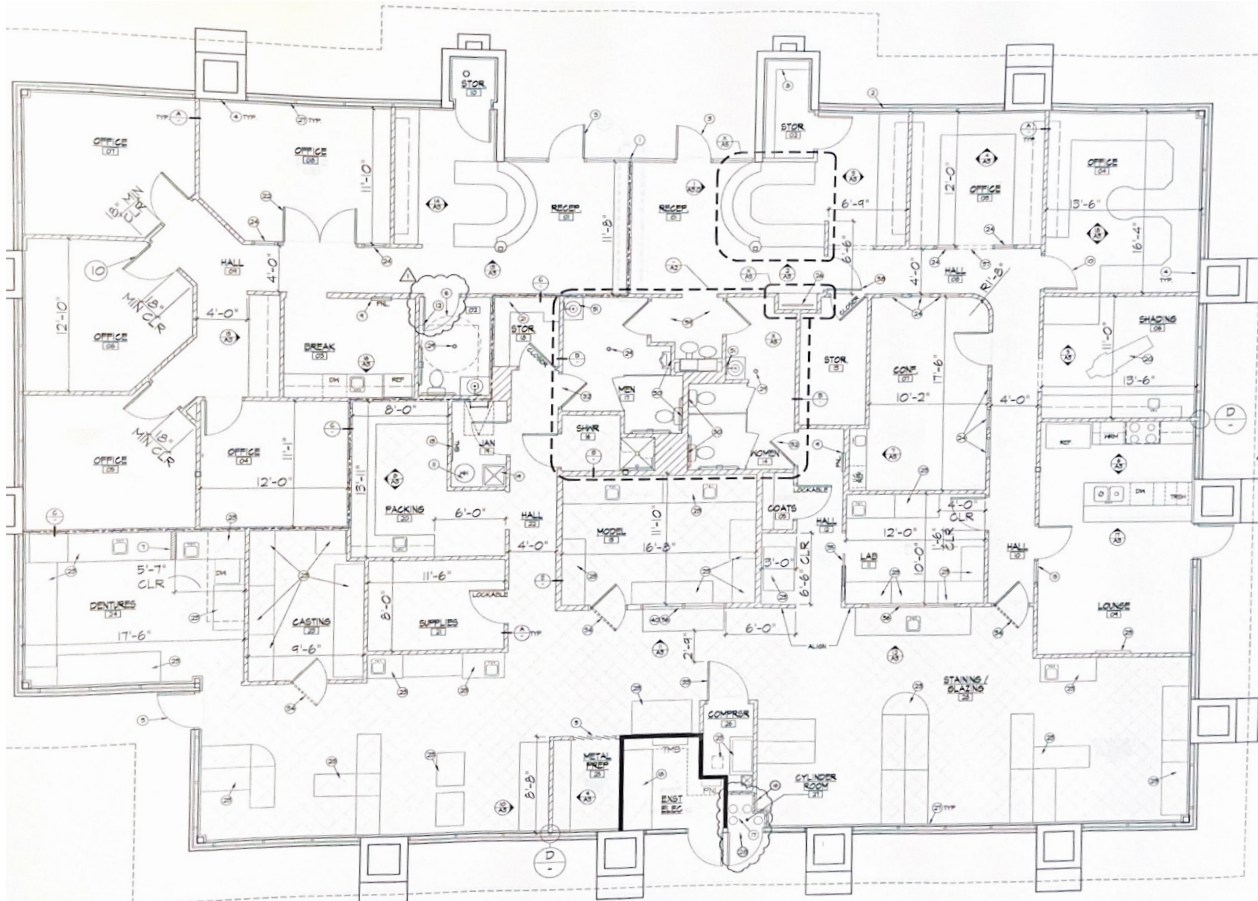

6,468 SF

AVAILABLE

*Represented by*

PERRY GABUZZI, CCIM  
602.513.5116  
perry.gabuzzi@kidder.com

RACHAEL THOMPSON  
602.513.5122  
rachael.thompson@kidder.com