

GRANITE VALLEY MEDICAL OFFICE

14506 W GRANITE VALLEY DR | SUN CITY WEST, AZ 85375


Floor 2

Suite 201

AS-BUILT

7,613 SF

AVAILABLE

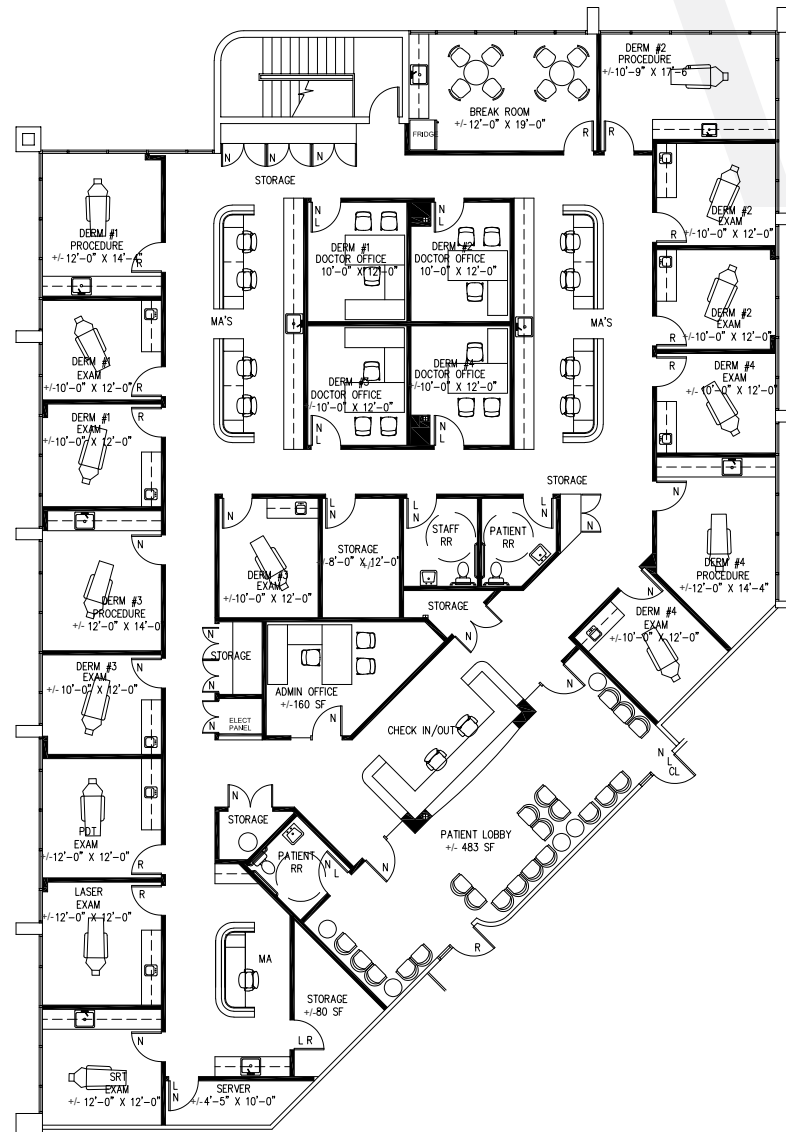

RACHAEL THOMPSON
Senior Vice President
602.513.5122
rachael.thompson@kidder.com

PERRY GABUZZI, CCIM
Senior Vice President
602.513.5116
perry.gabuzzi@kidder.com



View Portfolio

**km Kidder
Mathews**

GRANITE
VALLEY
MEDICAL
OFFICE

14506 W GRANITE VALLEY DR | SUN CITY WEST, AZ 85375


Floor 2

Suite 206

AS-BUILT

2,621 SF

AVAILABLE

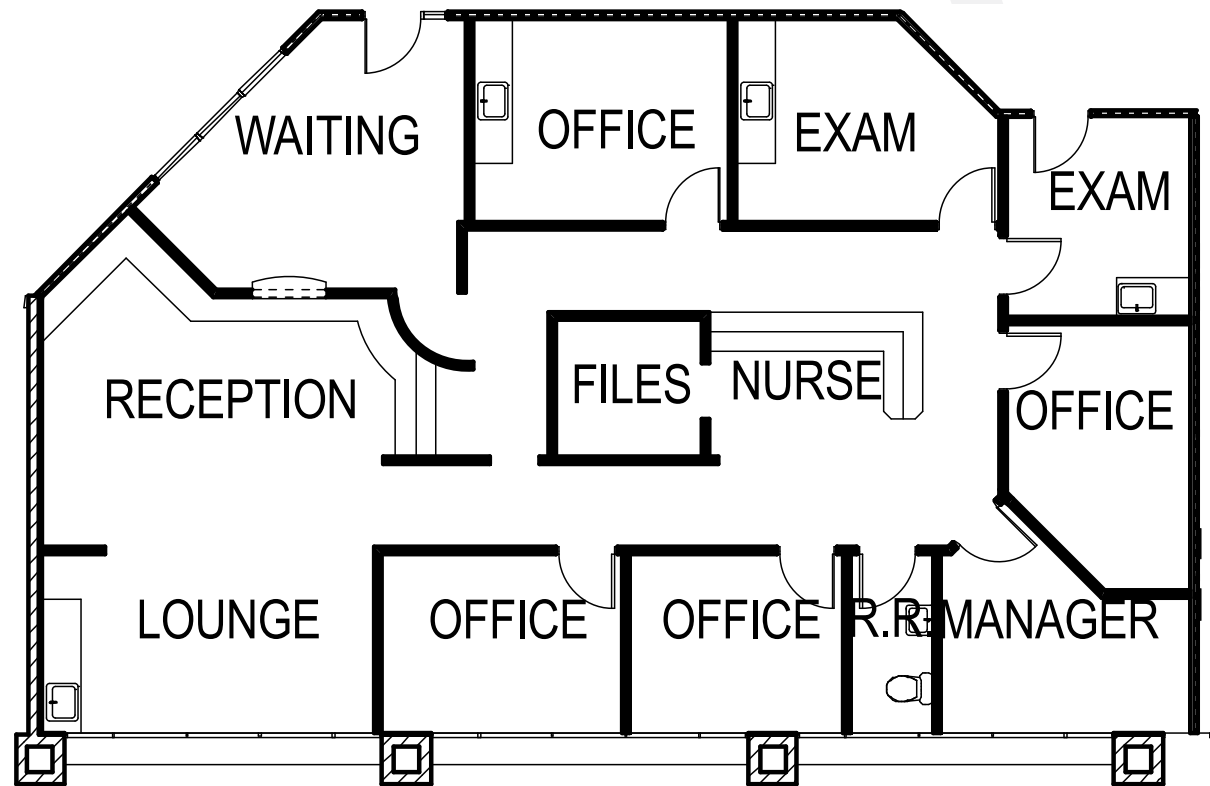

RACHAEL THOMPSON
Senior Vice President
602.513.5122
rachael.thompson@kidder.com

PERRY GABUZZI, CCIM
Senior Vice President
602.513.5116
perry.gabuzzi@kidder.com



View Portfolio

km Kidder
Mathews

GRANITE VALLEY MEDICAL OFFICE

14506 W GRANITE VALLEY DR | SUN CITY WEST, AZ 85375


Floor 2

Suite 209

AS-BUILT

2,174 SF

AVAILABLE

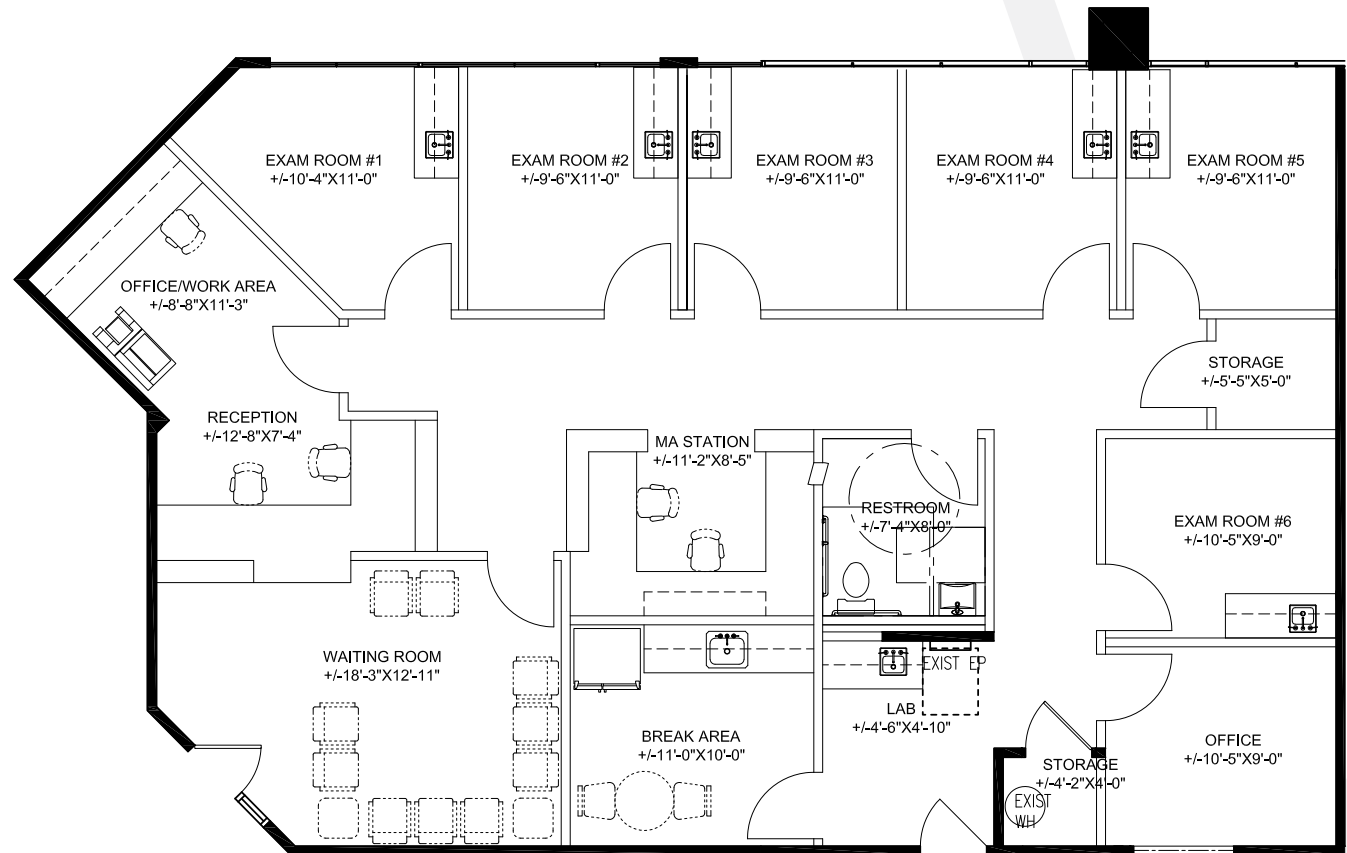

RACHAEL THOMPSON
Senior Vice President
602.513.5122
rachael.thompson@kidder.com

PERRY GABUZZI, CCIM
Senior Vice President
602.513.5116
perry.gabuzzi@kidder.com



View Portfolio

**km Kidder
Mathews**

GRANITE
VALLEY
MEDICAL
OFFICE

14506 W GRANITE VALLEY DR | SUN CITY WEST, AZ 85375


Floor 2

Suite 214

AS-BUILT

1,369 SF

AVAILABLE

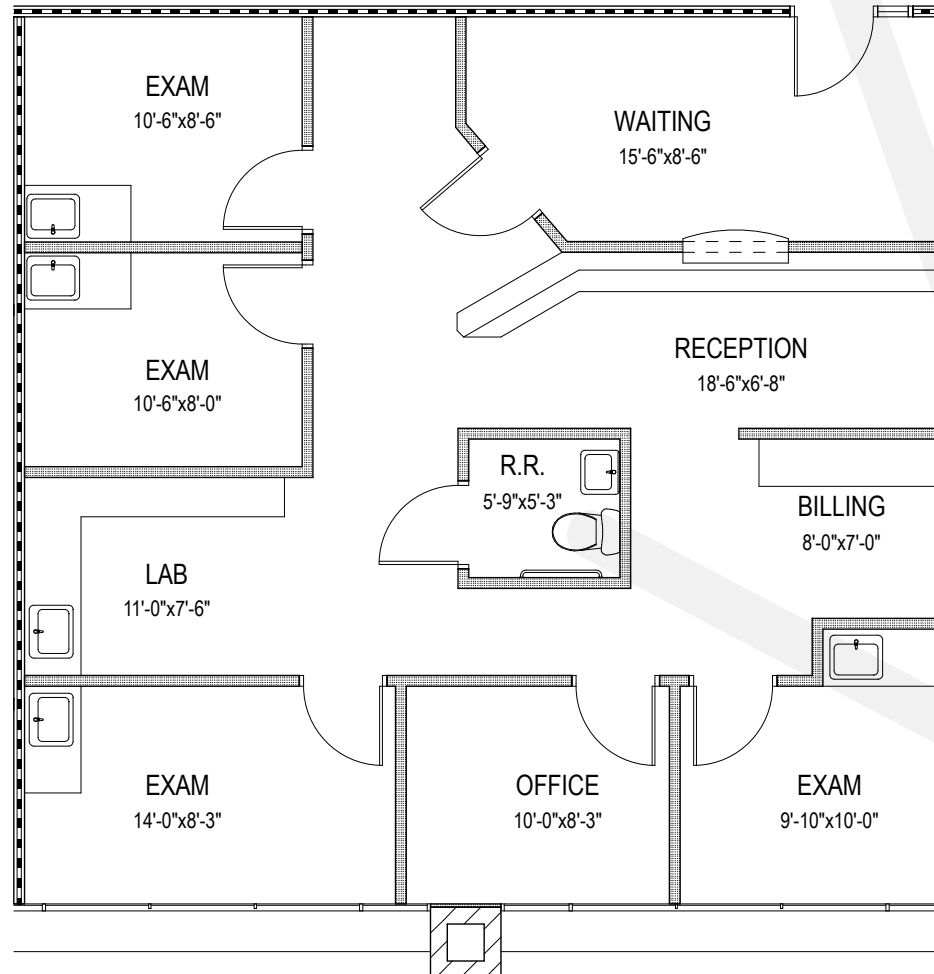

RACHAEL THOMPSON
Senior Vice President
602.513.5122
rachael.thompson@kidder.com

PERRY GABUZZI, CCIM
Senior Vice President
602.513.5116
perry.gabuzzi@kidder.com



View Portfolio

km Kidder
Mathews

GRANITE
VALLEY
MEDICAL
OFFICE

14506 W GRANITE VALLEY DR | SUN CITY WEST, AZ 85375


Floor 2

Suite 217

AS-BUILT

1,049 SF

AVAILABLE

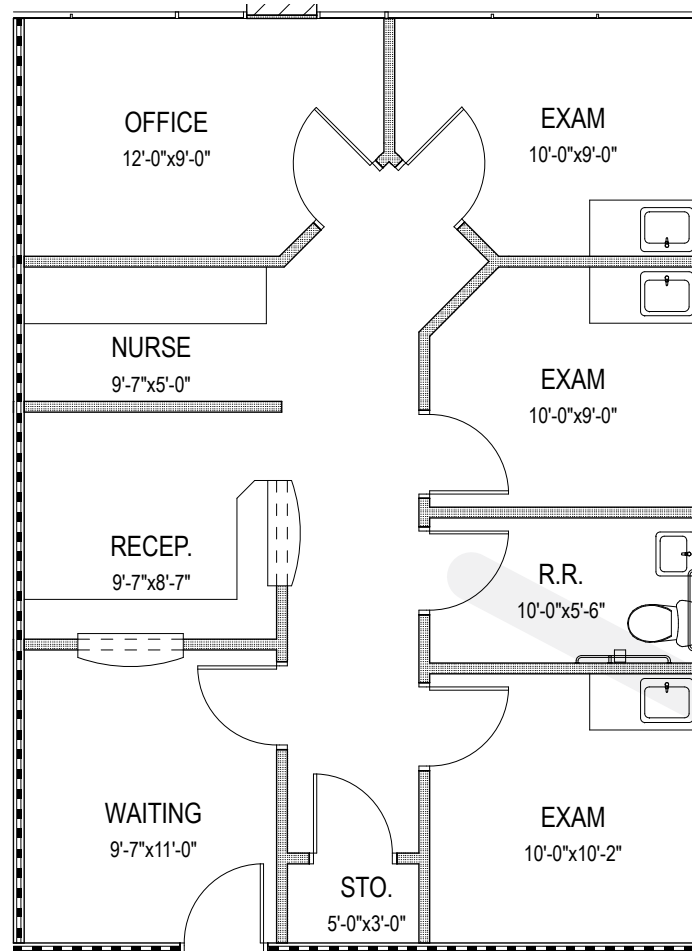

RACHAEL THOMPSON
Senior Vice President
602.513.5122
rachael.thompson@kidder.com

PERRY GABUZZI, CCIM
Senior Vice President
602.513.5116
perry.gabuzzi@kidder.com



View Portfolio

km Kidder
Mathews

GRANITE
VALLEY
MEDICAL
OFFICE

14506 W GRANITE VALLEY DR | SUN CITY WEST, AZ 85375


Floor 2

Suite 222

AS-BUILT

1,589 SF

AVAILABLE

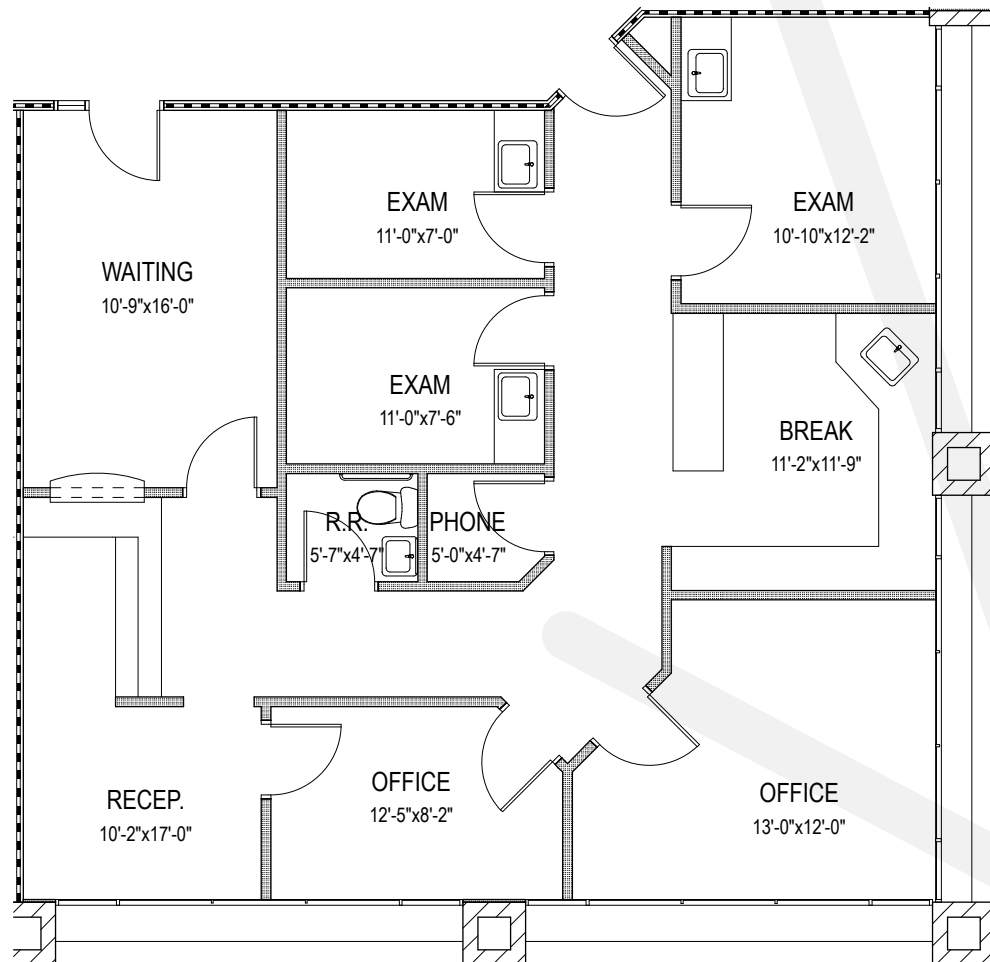

RACHAEL THOMPSON
Senior Vice President
602.513.5122
rachael.thompson@kidder.com

PERRY GABUZZI, CCIM
Senior Vice President
602.513.5116
perry.gabuzzi@kidder.com



km Kidder
Mathews