


A SUITE 203 AS
SCALE: $1/4" = 1'-0"$

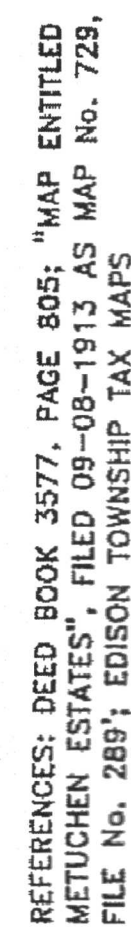

B PLOT P1
SCALE : 1" = 30'

1.) USE GROUP: B (BUSINESS)

2.) CONSTRUCTION CLASSIFICATION:
2B - UNLIMITED AREA BUILDING

3.) INTERIOR FINISHES: CL 2 MIN. FLAME SPREAD RATING

4.) THESE PLANS COMPLY WITH THE FOLLOWING CODES:

- A. 2018 INTERNATIONAL BUILDING CODE, NJ EDITION.
- B. 2017 NATIONAL ELECTRICAL CODE.
- C. 2018 NATIONAL STANDARD PLUMBING CODE.
- D. BARRIER FREE 2018 IBC/NJ EDITION AND ANSI ICC A-117.1-2009
- E. 2018 INTERNATIONAL MECHANICAL CODE.

	EXISTING WALL TO REMAIN
	EXISTING DOOR TO REMAIN
	EXIST. EMERGENCY EXIT LIGHT. WITH BATTERY BACK-UP
	EXISTING EMERGENCY LIGHTS WITH BATTERY BACK-UP
EXIT	EXISTING EXIT DIRECTION LIGHT

RONALD J. KACMARSKY -AIA-
N.J. LIC. # 13972

CONTRACTOR SHALL VERIFY ALL FIELD CONDITIONS AND DIMENSIONS AND BE RESPONSIBLE FOR FIELD FIT AND QUANTITY OF WORK. NO ALLOWANCES SHALL BE MADE ON BEHALF OF THE CONTRACTOR FOR ANY ERROR OR NEGLIGENCE ON HIS PART. DRAWINGS SHALL NOT BE SCALED.

[illegible]

DRAWING TITLE:

AS-BUILT
FOR
ORANGE
TO
ORANGE
LLC
295
PIERSON
AVENUE
SUITE 203
EDISON,
NJ 08837

DRAWING NAME:

AS-BUILT
FLOOR PLAN

LOT NO.	_____
BLOCK NO.	_____

PRINT NUMBER: -	DRAWN BY: CHRIS K
DATE: 01-31-2021	SCALE: AS NOTED
DRAWING NUMBER:	

A1