

(D1)-SPECIALTY EQUIPMENT SCHEDULE			
I.D.	Room: Name	Description	Count
A3	PHARMACY	Fill PC (Data Entry)	1
A35	GENERAL SALES	Photo kiosk computer station	3
A102	PHARMACY	Pharmacy scale and gun	1
A106	PHARMACY	Performance desktop printer	1
A108	PHARMACY	3 tray laser printer	1
A109	GENERAL SALES	Poster printer	1
A110	EXIT PASSAGE	Desktop CPU	1
A110	GENERAL SALES	Desktop CPU	3
A110	OFFICE	Desktop CPU	2
A110	PHARMACY	Desktop CPU	4
A111	ENTRY	19" touchscreen monitor	1
A111	GENERAL SALES	19" touchscreen monitor	3
A111	PHARMACY	19" touchscreen monitor	1
A112	EXIT PASSAGE	19" widescreen monitor	1
A112	GENERAL SALES	19" widescreen monitor	3
A112	OFFICE	19" widescreen monitor	2
A112	PHARMACY	19" widescreen monitor	1
A113	ENTRY	Register stand	1
A113	GENERAL SALES	Register stand	3
A113	PHARMACY	Register stand	4
A114	EXIT PASSAGE	Wireless keyboard	1
A114	GENERAL SALES	Wireless keyboard	7
A114	OFFICE	Wireless keyboard	2
A114	PHARMACY	Wireless keyboard	5
A115	EXIT PASSAGE	Computer mouse	1
A115	GENERAL SALES	Computer mouse	7
A115	OFFICE	Computer mouse	2
A115	PHARMACY	Computer mouse	5
A116	OFFICE	IP phone	2
A116	PHARMACY	IP phone	2
A117	PHARMACY	Cash till	4
A118	PHARMACY	Cash drawer	4
A119	PHARMACY	Intercom Plus	4
A120	GENERAL SALES	Hand scanner stand	4
A120	PHARMACY	Hand scanner stand	3
A121	GENERAL SALES	Hand scanner	4
A121	PHARMACY	Hand scanner	3
A122	PHARMACY	Payment pinpad stand	3
A123	PHARMACY	Payment pinpad	3
A124	PHARMACY	Multi-function POS printer	3
A125	PHARMACY	Duplex sheet fed document scanner	4
CT5	OFFICE	Office PC	2
CT10	EXIT PASSAGE	Training PC	1
M1	ENTRY	Electronic article surveillance system	1
M3	GENERAL SALES	Cartwell system	1
M4	ENTRY	Hand basket storage	1
M5	ENTRY	Rolling Basket Storage	1
M6	GENERAL SALES	Ad stand	1
M7	ENTRY	Automatic Teller Machine	1
M8	GENERAL SALES	Queue checkout fixture	3
M11	GENERAL SALES	Pole mounted 40" monitor	1
M12	GENERAL SALES	FedEx cabinet	2
M24	GENERAL SALES	6'-0" L x 10" H left shelving cornice	2
M25	GENERAL SALES	6'-0" L x 10" H middle shelving cornice	7
M26	GENERAL SALES	6'-0" L x 10" H right shelving cornice	4
M27	GENERAL SALES	6'-1" L x 10" H left shelving cornice	4
M28	GENERAL SALES	6'-1" L x 10" H right shelving cornice	1
M36	GENERAL SALES	Sunglass end stand	1
M55	GENERAL SALES	66" high gondola unit	60
M56	GENERAL SALES	66" high gondola unit	36
M71	GENERAL SALES	66" high gondola end cap	15
M72	GENERAL SALES	66" pop end cap assembly	1
M74	GENERAL SALES	Gift card end cap	1
M75	GENERAL SALES	Reading glasses end cap	1
M89	ENTRY	13" x 36" x 54" wall shelving assembly	1
M89	GENERAL SALES	13" x 36" x 54" wall shelving assembly	2
M95	GENERAL SALES	84" high shelving unit	1
M117	GENERAL SALES	22" x 36" x 84" wall shelving assembly	10
M125	GENERAL SALES	ACE Plus profile "B" card display	22
M135	STOCKROOM	Metal stock room shelving	3
M136	STOCKROOM	30" x 84" x 120" stock room shelving	4
M139	STOCKROOM	42" x 48" x 96" stock room shelving	1
M140	STOCKROOM	42" x 96" x 96" stock room shelving	2
M141	STOCKROOM	30" x 48" x 96" stock room shelving	1
M142	STOCKROOM	120" break pack shelving	1
M143	STOCKROOM	96" accessory cabinet fixture mounted assembly	1
M145	STOCKROOM	36" x 96" x 120" stock room shelving	2
M150	STOCKROOM	24" nest-a-flex	1
M160	WALK-IN COOLER	Wire rack	3
M161	WALK-IN FREEZER	Wire rack	1
M165	GENERAL SALES	84" high shelving unit	20
M166	GENERAL SALES	66" high shelving unit	19
M168	PHARMACY	Pharmacy narcotics safe	2
M169	PHARMACY	Pharmacy narcotics safe	2
M183	STOCKROOM	Baler	1
M211	GENERAL SALES	19" x 36" x 84" wall shelving assembly	2
M263	WALK-IN FREEZER	Cooler/Freezer Shelving	1
M265	WALK-IN COOLER	Freezer/cooler Shelving	1

(D1)-SPECIALTY EQUIPMENT SCHEDULE			
I.D.	Room: Name	Description	Count
M270	PHARMACY WAITING AREA	Pharmacy queue system	1
M272	PHARMACY	Heavy duty flex Rx island section	10
M273	PHARMACY	Heavy duty flex Rx wall section	4
M274	PHARMACY	16" speed shelves	11
M275	PHARMACY	Wall bottle bays	2
M276	PHARMACY	36" speed shelves	3
M280	PHR	Private health room type C	1
M296	OFFICE	Safe	1
M297	OFFICE	Till locker	1
M298	OFFICE	2 drawer file cabinet	1
M300	EXIT PASSAGE	2 door storage cabinet	1
M301	EXIT PASSAGE	12" x 84" 6 tier locker	2
M302	EXIT PASSAGE	12" x 84" 6 tier locker w/ ADA locker	3
M304	EXIT PASSAGE	12" x 48" 1 tier locker	1
M305	TECH CLOSET	Store cabinet	2
M316	PORTER CLOSET	5" X 18" restroom shelf	2
M317	EMPLOYEE ROOM	Paper towel dispenser	1
M327	EMPLOYEE ROOM	Channel frame mirror	1
M357	GENERAL SALES	16" X 36" X 54" fragrance case	2
M392	GENERAL SALES	49"H x 32-5/8"W passport screen	1
M557	GENERAL SALES	19" x 36" x 66" wall shelving assembly	11
N1	RESTROOM	Baby changing station	2
N5	RESTROOM	Sanitary napkin disposal	2
N9	RESTROOM	Seat cover dispenser	2
N17	RESTROOM	Toilet tissue dispenser	2
N29	RESTROOM	Soap dispenser	2
N33	RESTROOM	Soap dish	2
N37	RESTROOM	Towel Dispenser/Waste Receptacle	2
N39	RESTROOM	Dome top waste receptacle	2
N40	RESTROOM	Paper towel dispenser	2
N58	RESTROOM	18" X 36" Channel frame mirror	2
N64	RESTROOM	18" grab bar	2
N67	RESTROOM	36" grab bar	2
N88	RESTROOM	42" grab bar	2

CASEWORK SCHEDULE			
I.D.	Room: Name	Description	Count
C10	GENERAL SALES	Photo counter cutting cabinet	1
C6	GENERAL SALES	Right-hand modular checkout	3
C8	GENERAL SALES	Right-hand ADA checkout	1
C9	GENERAL SALES	Photo paper processor	1
C11	GENERAL SALES	Photo counter finished work cabinet	1
C12	GENERAL SALES	Photo counter poster board cabinet	1
C13	GENERAL SALES	Photo counter storage cabinet	1
C14	GENERAL SALES	3 station photo kiosk	1
C28	PHARMACY	15' left-hand checkout assembly	1
C31	PHARMACY	Rx Consultation Desk	1
C32	PHARMACY	12' finished work assembly	1
C32.1	PHARMACY	Pharmacy checkout drawer unit	1
C37	PHARMACY	Insert #1 - 3 drawer unit	1
C38	PHARMACY	Insert #2 - 3 drawer file unit	1
C39	PHARMACY	Insert #3 - Open unit	1
C40	PHARMACY	Insert #8 - Conveyor motor unit	2
C41	PHARMACY	Insert #5 - Printer insert	1
C45	PHARMACY	Left-hand script drop bin	1
C47	PHARMACY	Pharmacy sink upper cabinet	1
C50	GENERAL SALES	Pharmacy privacy panel	2
C51	EXIT PASSAGE	New employee training counter	1
C52	EMPLOYEE ROOM	Countertop with backsplash	1
C53	EMPLOYEE ROOM	Employee room sink assembly	1
C53	EMPLOYEE ROOM	Upper cabinets	1
C54	OFFICE	Undercounter shelf unit	1
C55	OFFICE	Countertop shelf unit	1
C57	PHR	Mobile cabinet	1
C63	PHARMACY	Pharmacy 6' work counter shell w/ no conveyor	2
C64	PHARMACY	Pharmacy work countertop	1
C100	PHARMACY	Pharmacy sink and cabinet	1
C100	PHARMACY	Pharmacy sink base cabinet	1
C103	EMPLOYEE ROOM	Base cabinet for employee room	1
C113	GENERAL SALES	General sales insert filler piece	3
C114	PHARMACY	Rx insert filler piece	1
C157	ENTRY	Back panel 81" W x 55" H - BE	1
C166	GENERAL SALES	48" x 55" checkout end panel	1
C168	GENERAL SALES	43" x 55" checkout gate end panel	1
C170	GENERAL SALES	57" x 55" checkout gate end panel	1
C270	GENERAL SALES	Poster storage bin	1
C360	GENERAL SALES	End cap pallet	1
C365	GENERAL SALES	General sales corner filler piece	2

Cash Register Schedule			
I.D.	Room: Name	Description	Count
CR1	PHARMACY	Pharmacy cash register	3
CR2	GENERAL SALES	Front checkout cash register	4
CR3	PHARMACY	Drive thru checkout cash register	1
Grand total			8

RX SHELVING		
Description	Rx Linear Footage	Bottle Bays
Heavy duty flex Rx island section	60' - 8"	52
Heavy duty flex Rx wall section	9' - 4"	8
Wall bottle bays	7' - 0"	6
Total Rx Shelving	77' - 0"	66

REFRIGERATION SCHEDULE			
I.D.	Room: Name	Description	Count
R1	PHARMACY	Vaccine Refrigerator	1
R2	PHARMACY	Undercounter laboratory refrigerator & freezer	1
R3	PHARMACY	Medical freezer	1
R4	EMPLOYEE ROOM	Employee room refrigerator	1
R5	GENERAL SALES	Glass door merchandiser	1

FURNITURE SCHEDULE			
I.D.	Room: Name	Description	Count
F1	PHARMACY WAITING AREA	Bariatric chair	1
F2	PHARMACY WAITING AREA	Guest chair	2
F2	PHR	Guest chair	1
F3	GENERAL SALES	Guest stool	1
F4	PHARMACY WAITING AREA	Side table	1
F5	OFFICE	Task chair	1
F6	OFFICE	Task stool	1
F7	EMPLOYEE ROOM	Slacker	4
F7	EXIT PASSAGE	Side chair	1
F8	EMPLOYEE ROOM	Employee room table	1
F10	PHR	Medical stool	1
F11	PHR	Armless guest chair with casters	1
F12	GENERAL SALES	Kiosk chair	3

RETAIL LINEAR BY STORE AREA		
Store Area	Retail Linear Footage	Fixture Count
COOLER	32' - 3 1/2"	11
CHECKOUT	21' - 7 1/4"	6
GENERAL SALE	828' - 0 3/4"	293
PHARMACY	16' - 11"	6
FREEZER	11' - 7"	4
GRAND TOTAL	910' - 4 1/2"	320

SQUARE FOOT AREA SUMMARY	
Name	Area
ELECTRICAL AREA	153 SF
ENTRY	318 SF
EXIT PASSAGE	158 SF
GENERAL SALE	5854 SF
PHARMACY	684 SF
PHARMACY WAITING AREA	181 SF
PHR	43 SF
REFRIGERATION	318 SF
SERVICE	618 SF
STOCKROOM	1187 SF
Gross Square Footage	9515 SF

FIXTURE LEGEND			
Code	Description	Dimensions	Material/Finish
G	GONDOLA	1919 36 66"	WT COLOR
DT	DISPLAY TABLE	D. W.	WT COLOR
MS	METAL SHELVING	24 75 120" /2S	NUM. OF SHELVES
MS	METAL SHELVING	24 84 120" /5S	NUM. OF SHELVES
MS	METAL SHELVING	30 84 120" /5S	NUM. OF SHELVES
MS	METAL SHELVING	30 96 120" /5S	NUM. OF SHELVES
MS	METAL SHELVING	32 96 120" /5S	NUM. OF SHELVES
MS	METAL SHELVING	36 84 120" /5S	NUM. OF SHELVES


ALL OTHER FIXTURES ARE TYPICALLY CALLED OUT BY DEPTH AND WIDTH.

EXAMPLE:
30 48
DT
DISPLAY TABLE D. W.

EXAMPLE:
22 36
CAB
CABINET D. W.

FE
FINISHED END PANEL
SIZES ARE NOT NOTED ON D-111 PLAN

* DOES NOT INCLUDE STANDARDS, WOOD GROUNDS, OR FINISHED END PANELS.

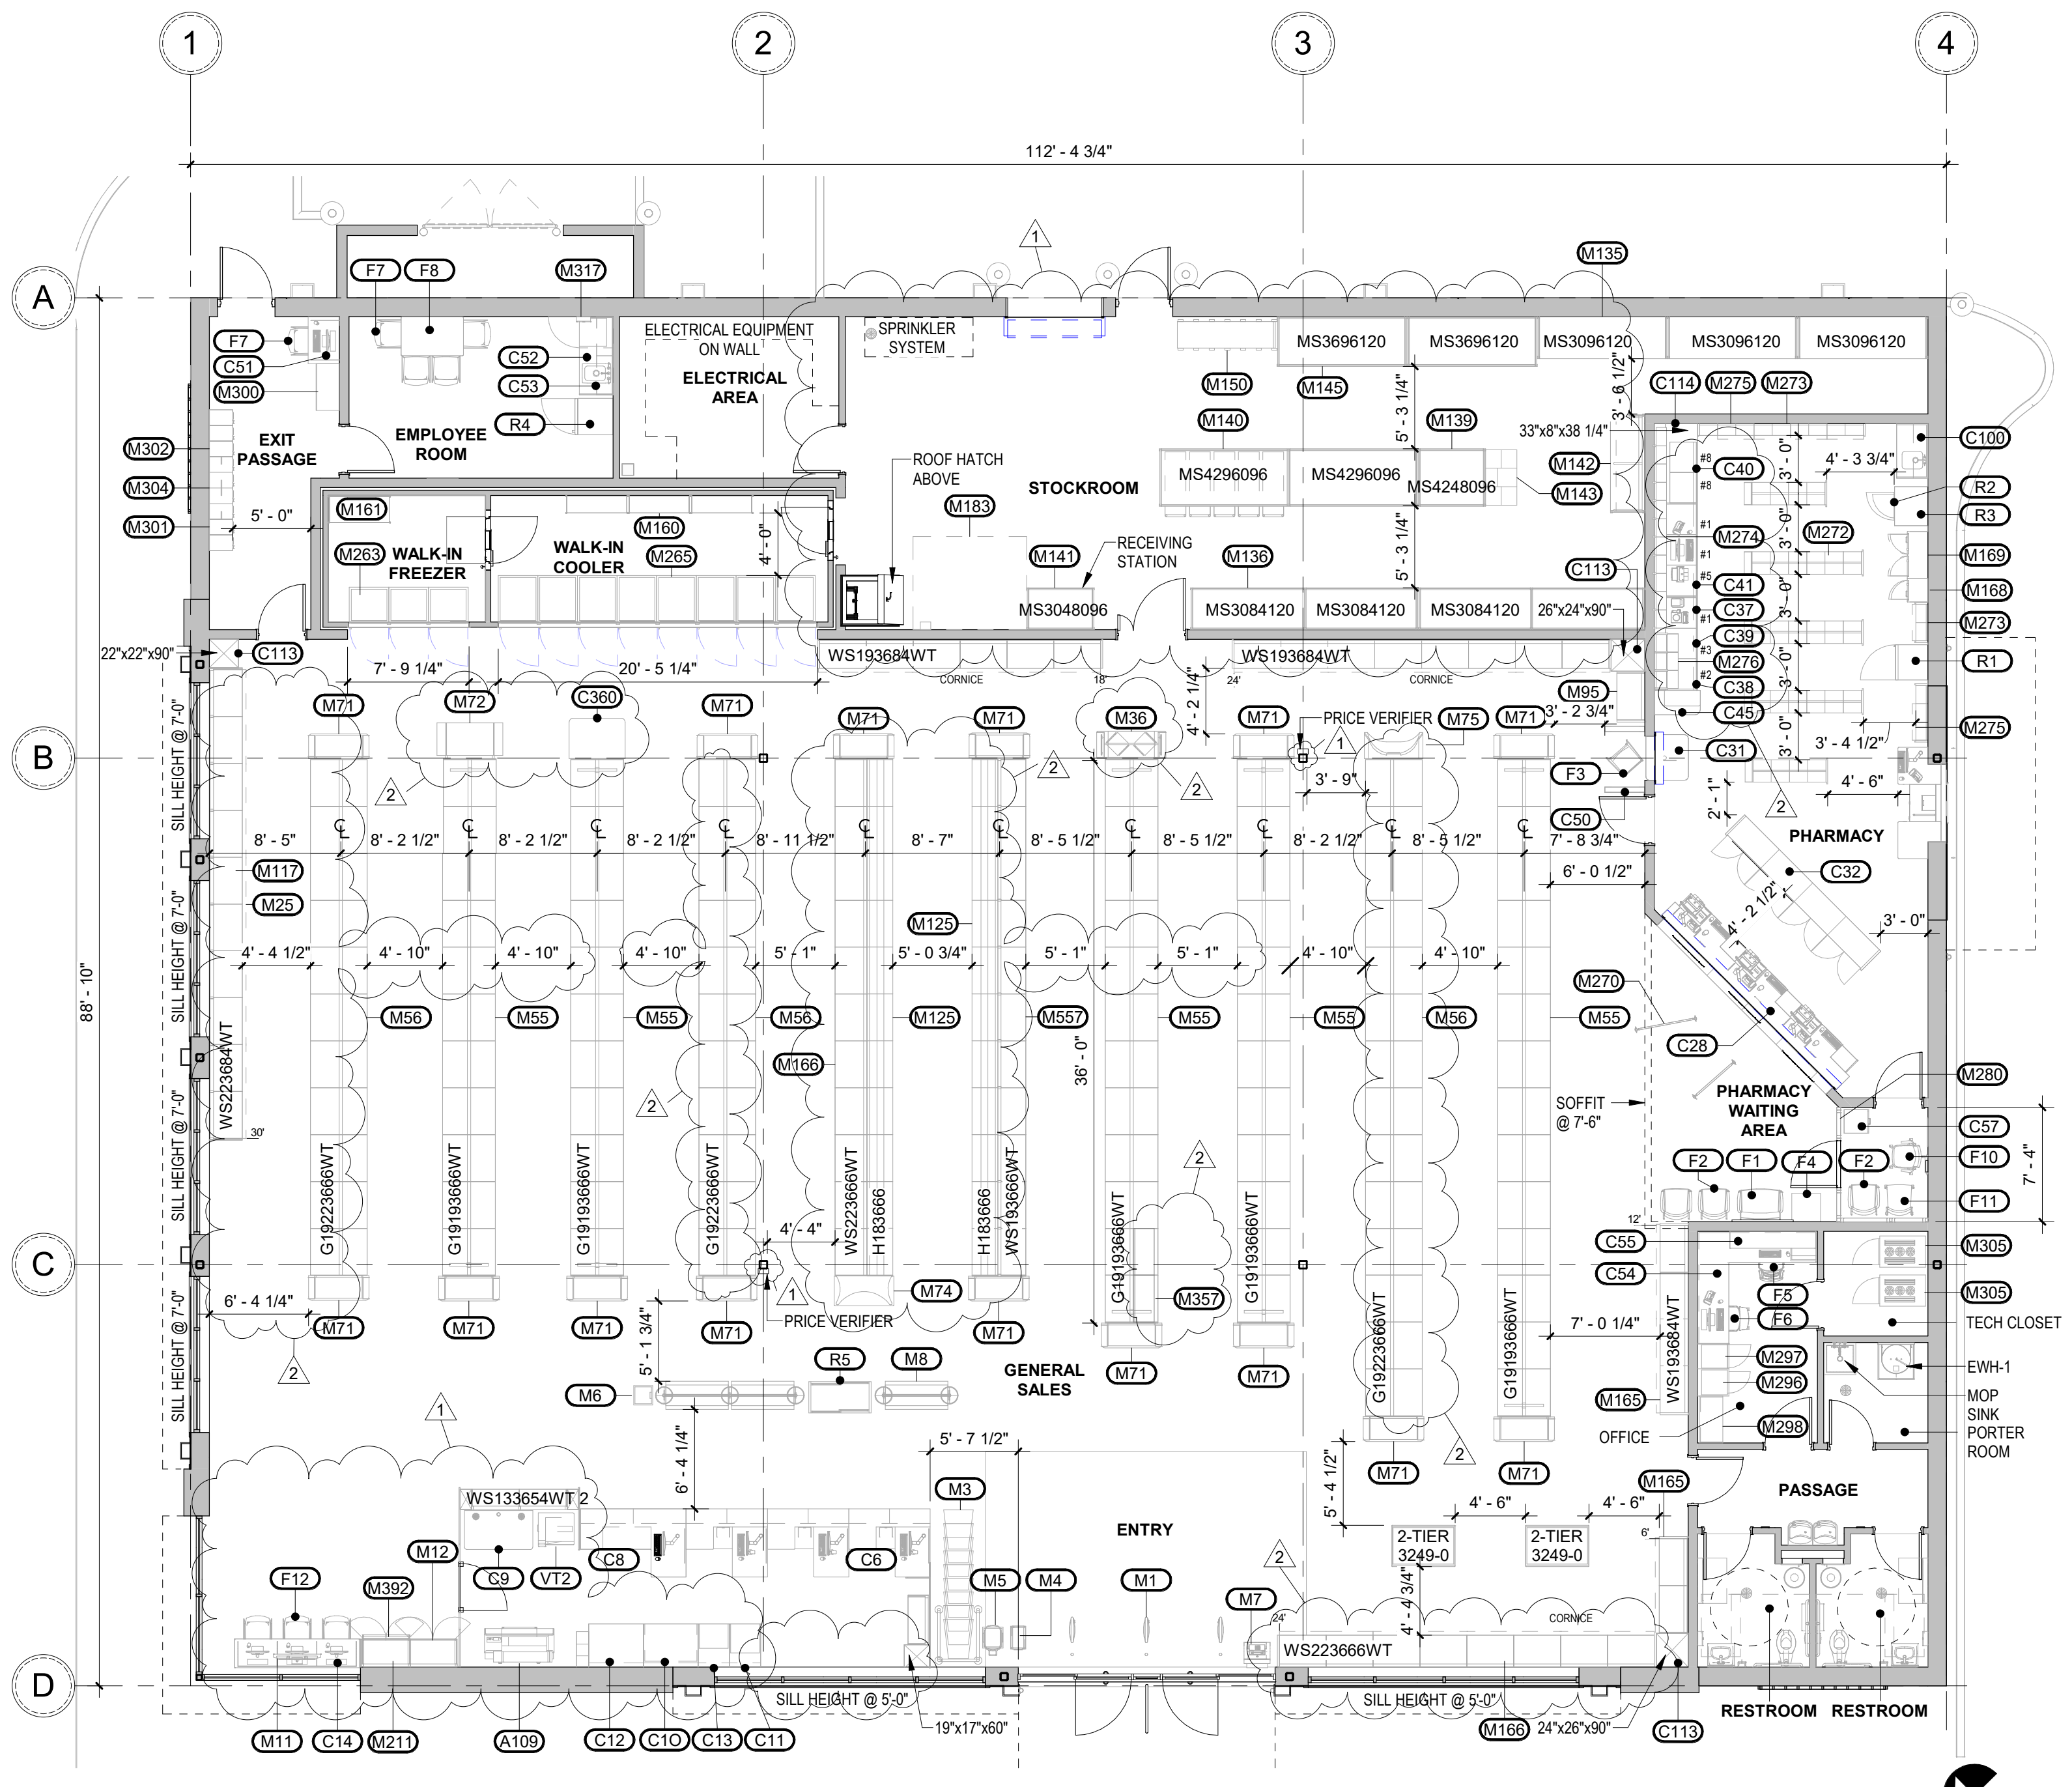

1 FIRST FLOOR FIXTURE PLAN
1/8" = 1'-0"

STORE DEVELOPMENT + STORE CARE
106 WILLMOT ROAD
DEERFIELD, IL 60015-5105

I HEREBY CERTIFY THAT THIS PLAN AND SPECIFICATIONS WERE PREPARED BY ME OR UNDER MY DIRECT SUPERVISION AND THAT I AM A DULY REGISTERED ENGINEER UNDER THE LAWS OF THIS STATE AS SIGNIFIED BY MY HAND AND SEAL.

STEVEN B. RABINOFF ARCHITECT
ARCHITECTS • ENGINEERS • PLANNERS
58-15 Forest Hills Boulevard, Flushing, New York 11354-1439
Tel: 718-224-6841 Fax: 718-224-6841
NATIONAL PROFESSIONAL ORGANIZATION: NYS E.C.E. REG. NO. 14470
NATIONAL PROFESSIONAL ORGANIZATION: NYS E.C.E. REG. NO. 14470

NO.	DATE	BY	DESCRIPTION	REVISIONS
2	09/22/20	MDT	Coordination	
1	08/04/20	MDT	Waigants Review Comments	

CADD PLOT: 9/22/20 05:31 AM
DRAWN BY: Author
DATE: Issue Date
REVIEWED: Checker

STORE # 17259
WALGREENS
467 IYANNOUGH ROAD,
HYANNIS, MA
PROJECT: 19002

FIRST FLOOR FIXTURE PLAN

D-111.00

COPYRIGHT © 2016 WALGREEN CO.