


GENERAL NOTES

- ALL WINDOWS ARE APPROXIMATELY REPRESENTED TO THE ROUGH OPENING IN THEIR RESPECTIVE WALLS, ACTUAL WINDOW SIZE TO BE CONFIRMED IN FIELD WHEN PRECISE DIMENSIONS ARE CRITICAL TO THE SCOPE OF WORK
- ALL WALL THICKNESS REPRESENTED DOES NOT INCLUDE TRIM SIZING

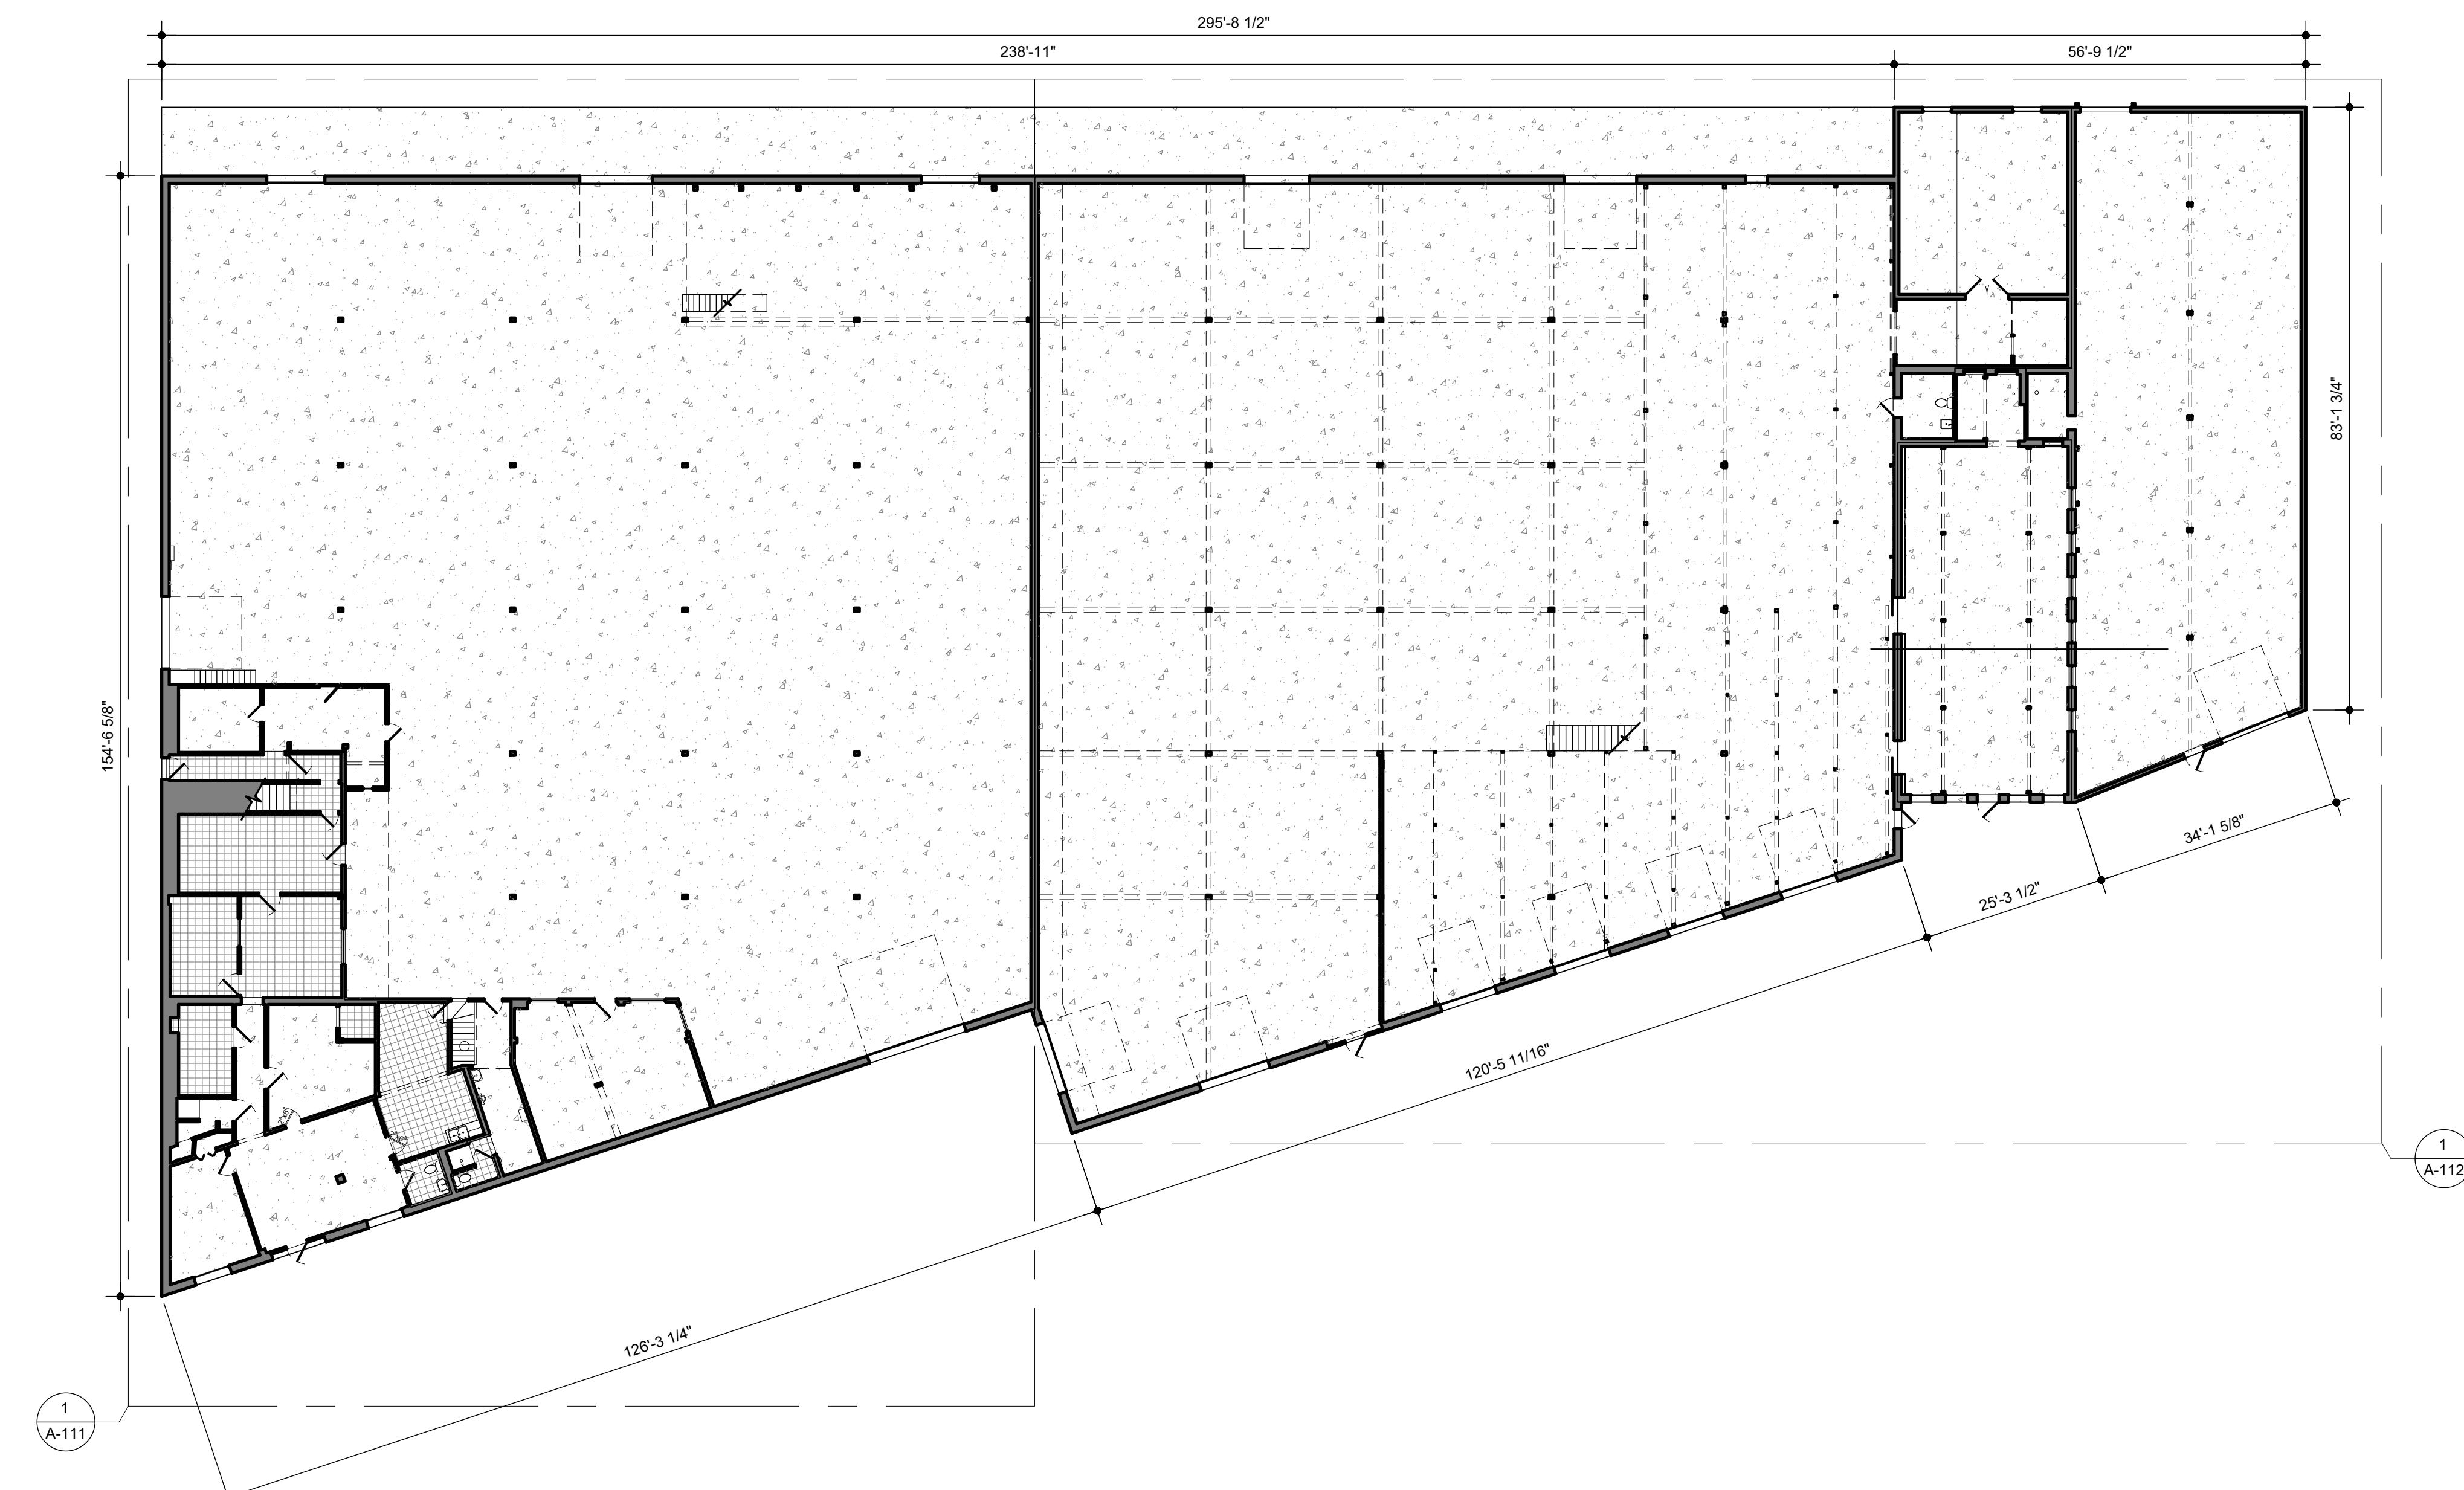

NORTH

OVERALL FLOOR PLAN
1 A-110 1/16"=1'-0"

SQUARE FOOTAGE		
SUITE A	16,219	SF
FIRST FLOOR	3,271	SF
SECOND FLOOR		
SUITE B	14,496	SF
FIRST FLOOR	4,662	SF
SECOND FLOOR		
SUITE C	1,291	SF
FIRST FLOOR		
SUITE D	2,957	SF
FIRST FLOOR		
TOTAL OF ALL SPACES	42,896	SF



210-705-1238 AlamoAsbuilts.com
Asbuilts@alamoasbuilts.com Design@alamoasbuilts.com


200 SEGUIN ST
SAN ANTONIO, TX

AS-BUILT FIRST
FLOOR PLAN

DATE: 10/16/2025

Sheet Number

AS-BUILTS
A-110

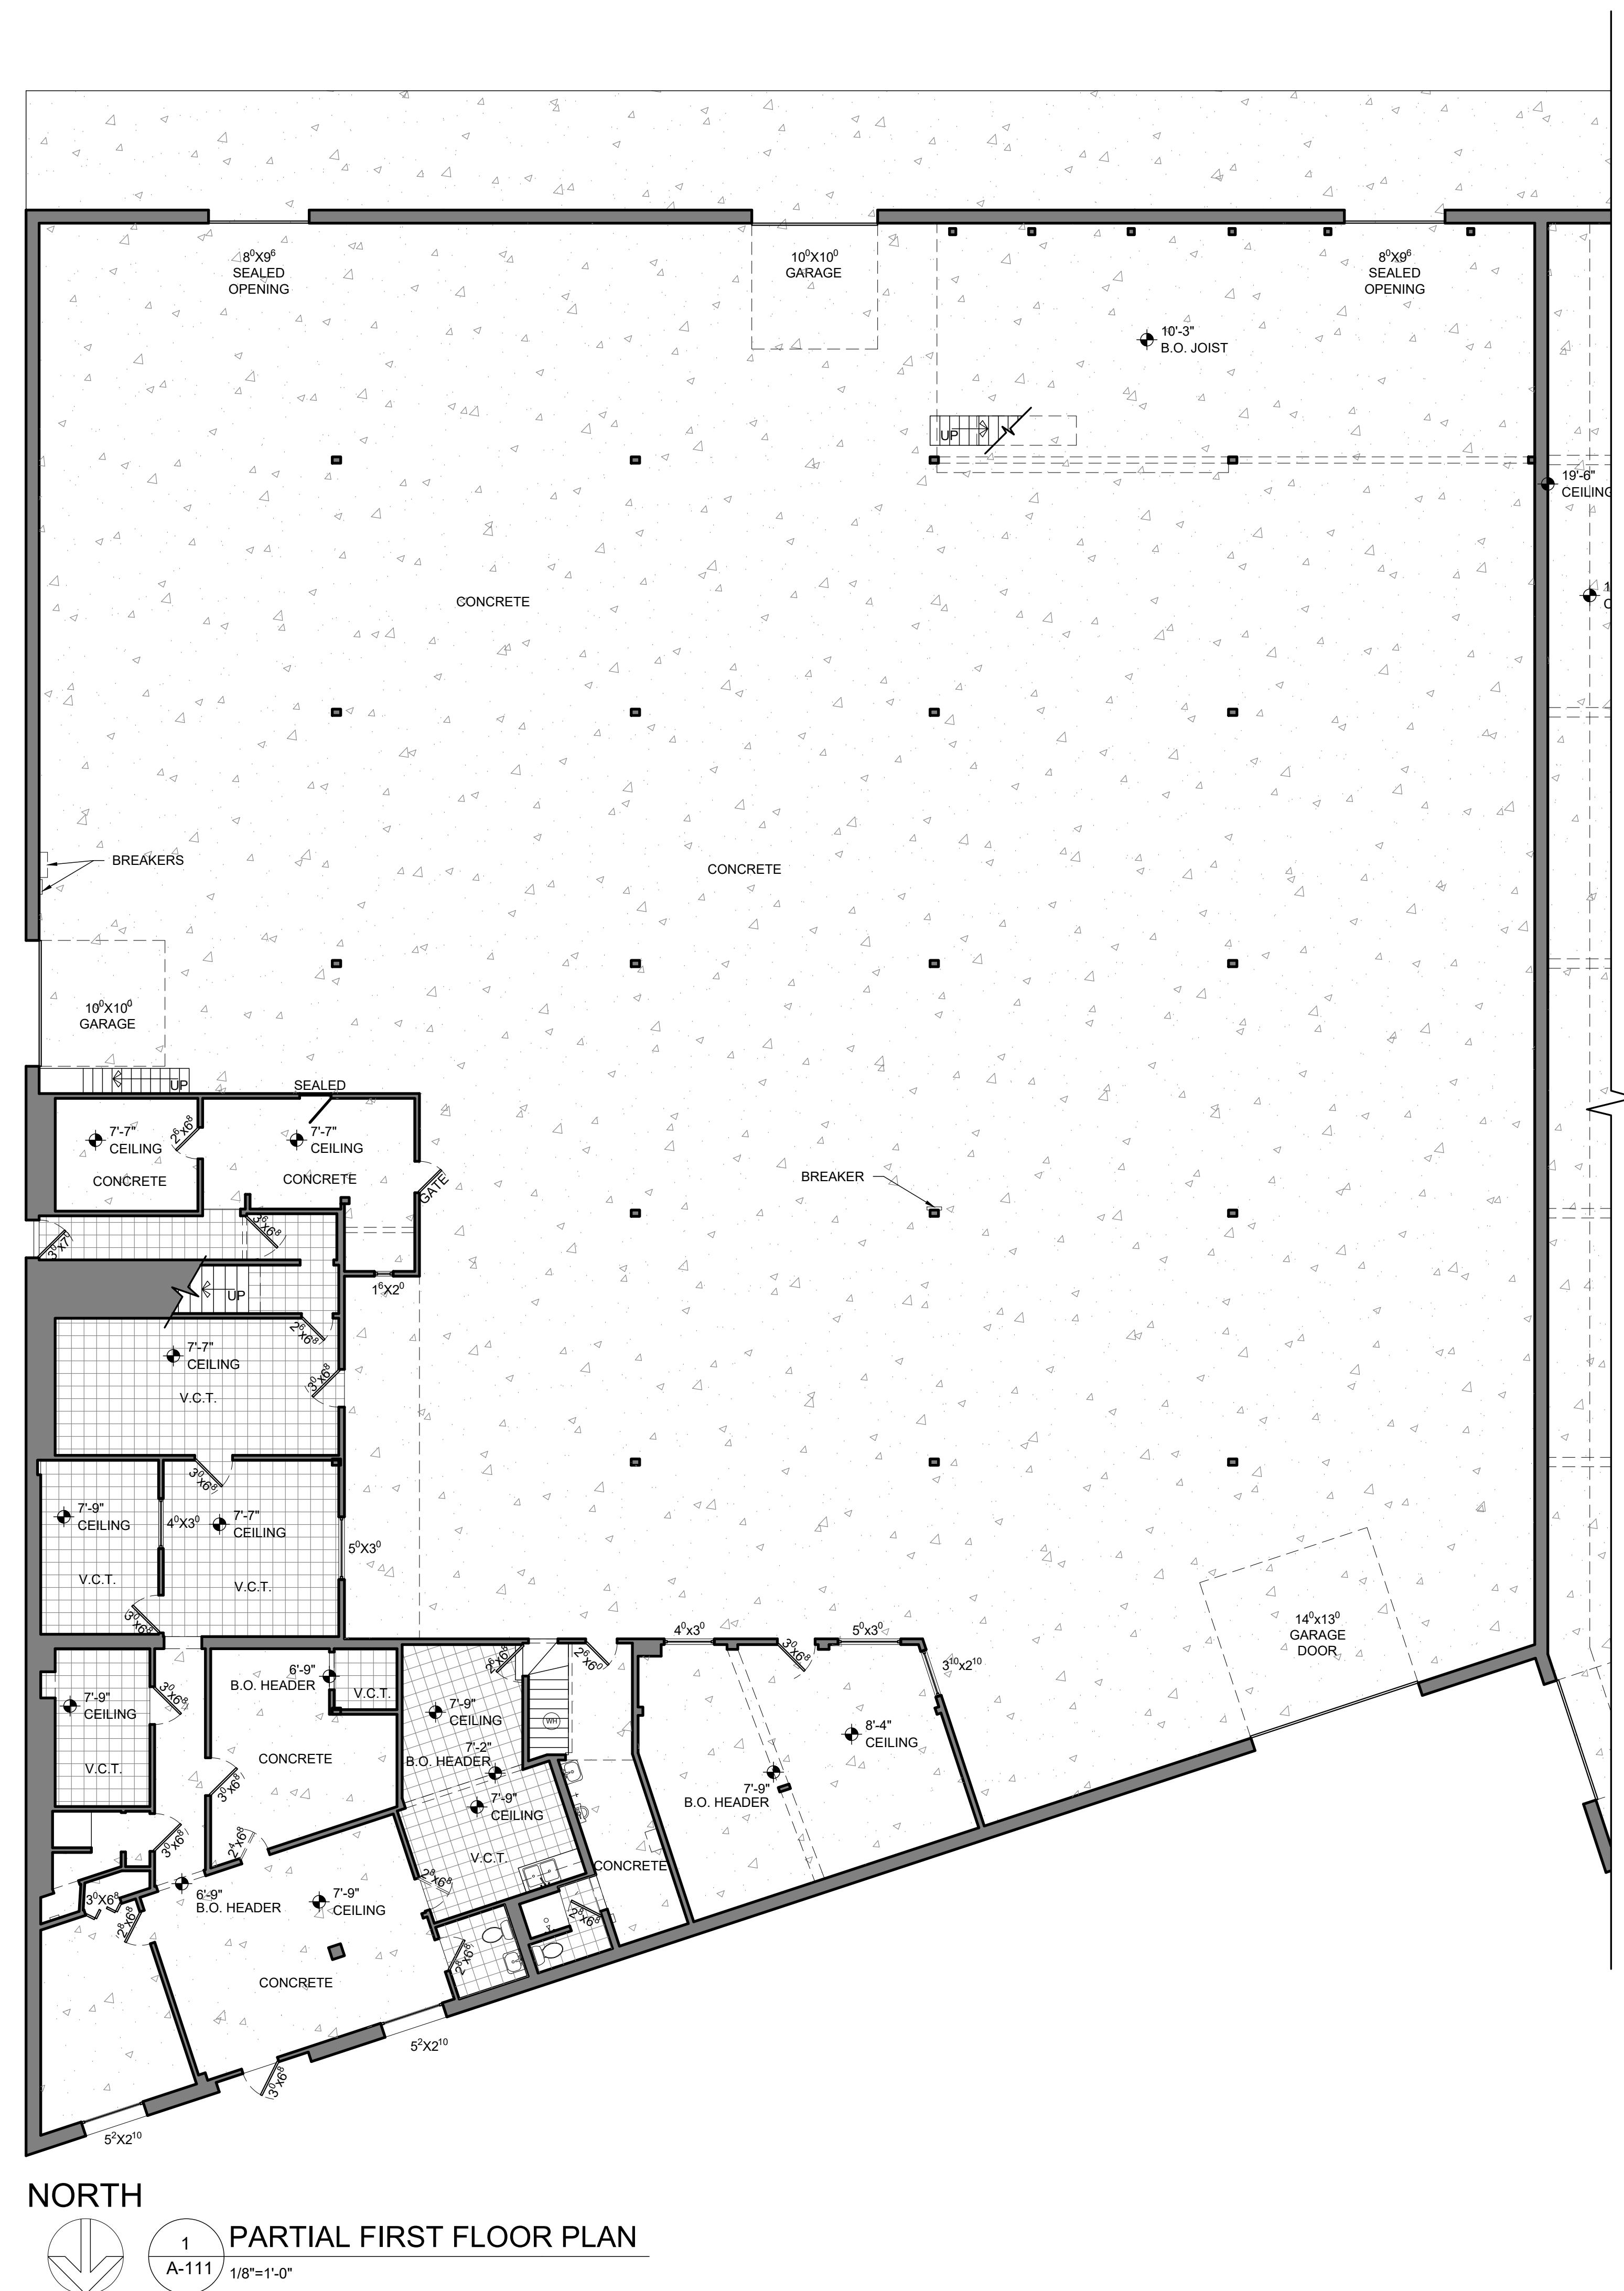

GENERAL NOTES

- ALL WINDOWS ARE APPROXIMATELY REPRESENTED TO THE ROUGH OPENING IN THEIR RESPECTIVE WALLS, ACTUAL WINDOW SIZE TO BE CONFIRMED IN FIELD WHEN PRECISE DIMENSIONS ARE CRITICAL TO THE SCOPE OF WORK
- ALL WALL THICKNESS REPRESENTED DOES NOT INCLUDE TRIM SIZING



210-705-1238 AlamoAsbuilts.com
Asbuilts@alamoasbuilts.com Design@alamoasbuilts.com

200 SEGUIN STREET - AS-BUILT DRAWINGS

200 SEGUIN ST
SAN ANTONIO, TX

AS-BUILT SUITE A
FLOOR PLAN

DATE: 10/16/2025

Sheet Number

AS-BUILTS

A-111

GENERAL NOTES

- ALL WINDOWS ARE APPROXIMATELY REPRESENTED TO THE ROUGH OPENING IN THEIR RESPECTIVE WALLS, ACTUAL WINDOW SIZE TO BE CONFIRMED IN FIELD WHEN PRECISE DIMENSIONS ARE CRITICAL TO THE SCOPE OF WORK

- ALL WALL THICKNESS REPRESENTED DOES NOT INCLUDE TRIM SIZING

