

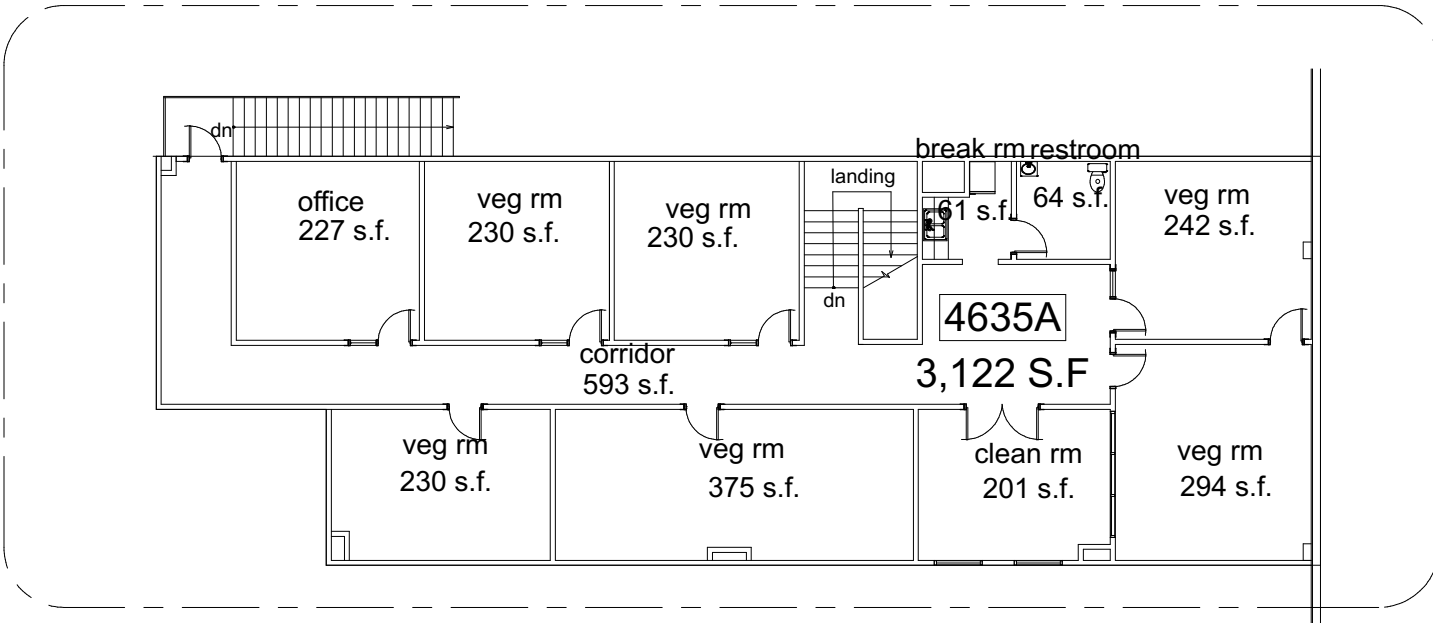
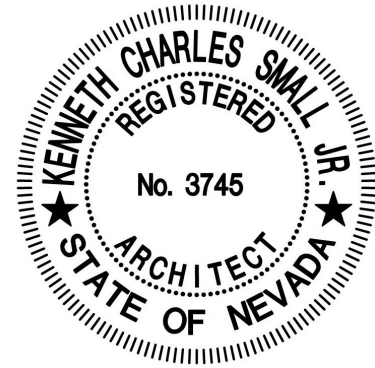
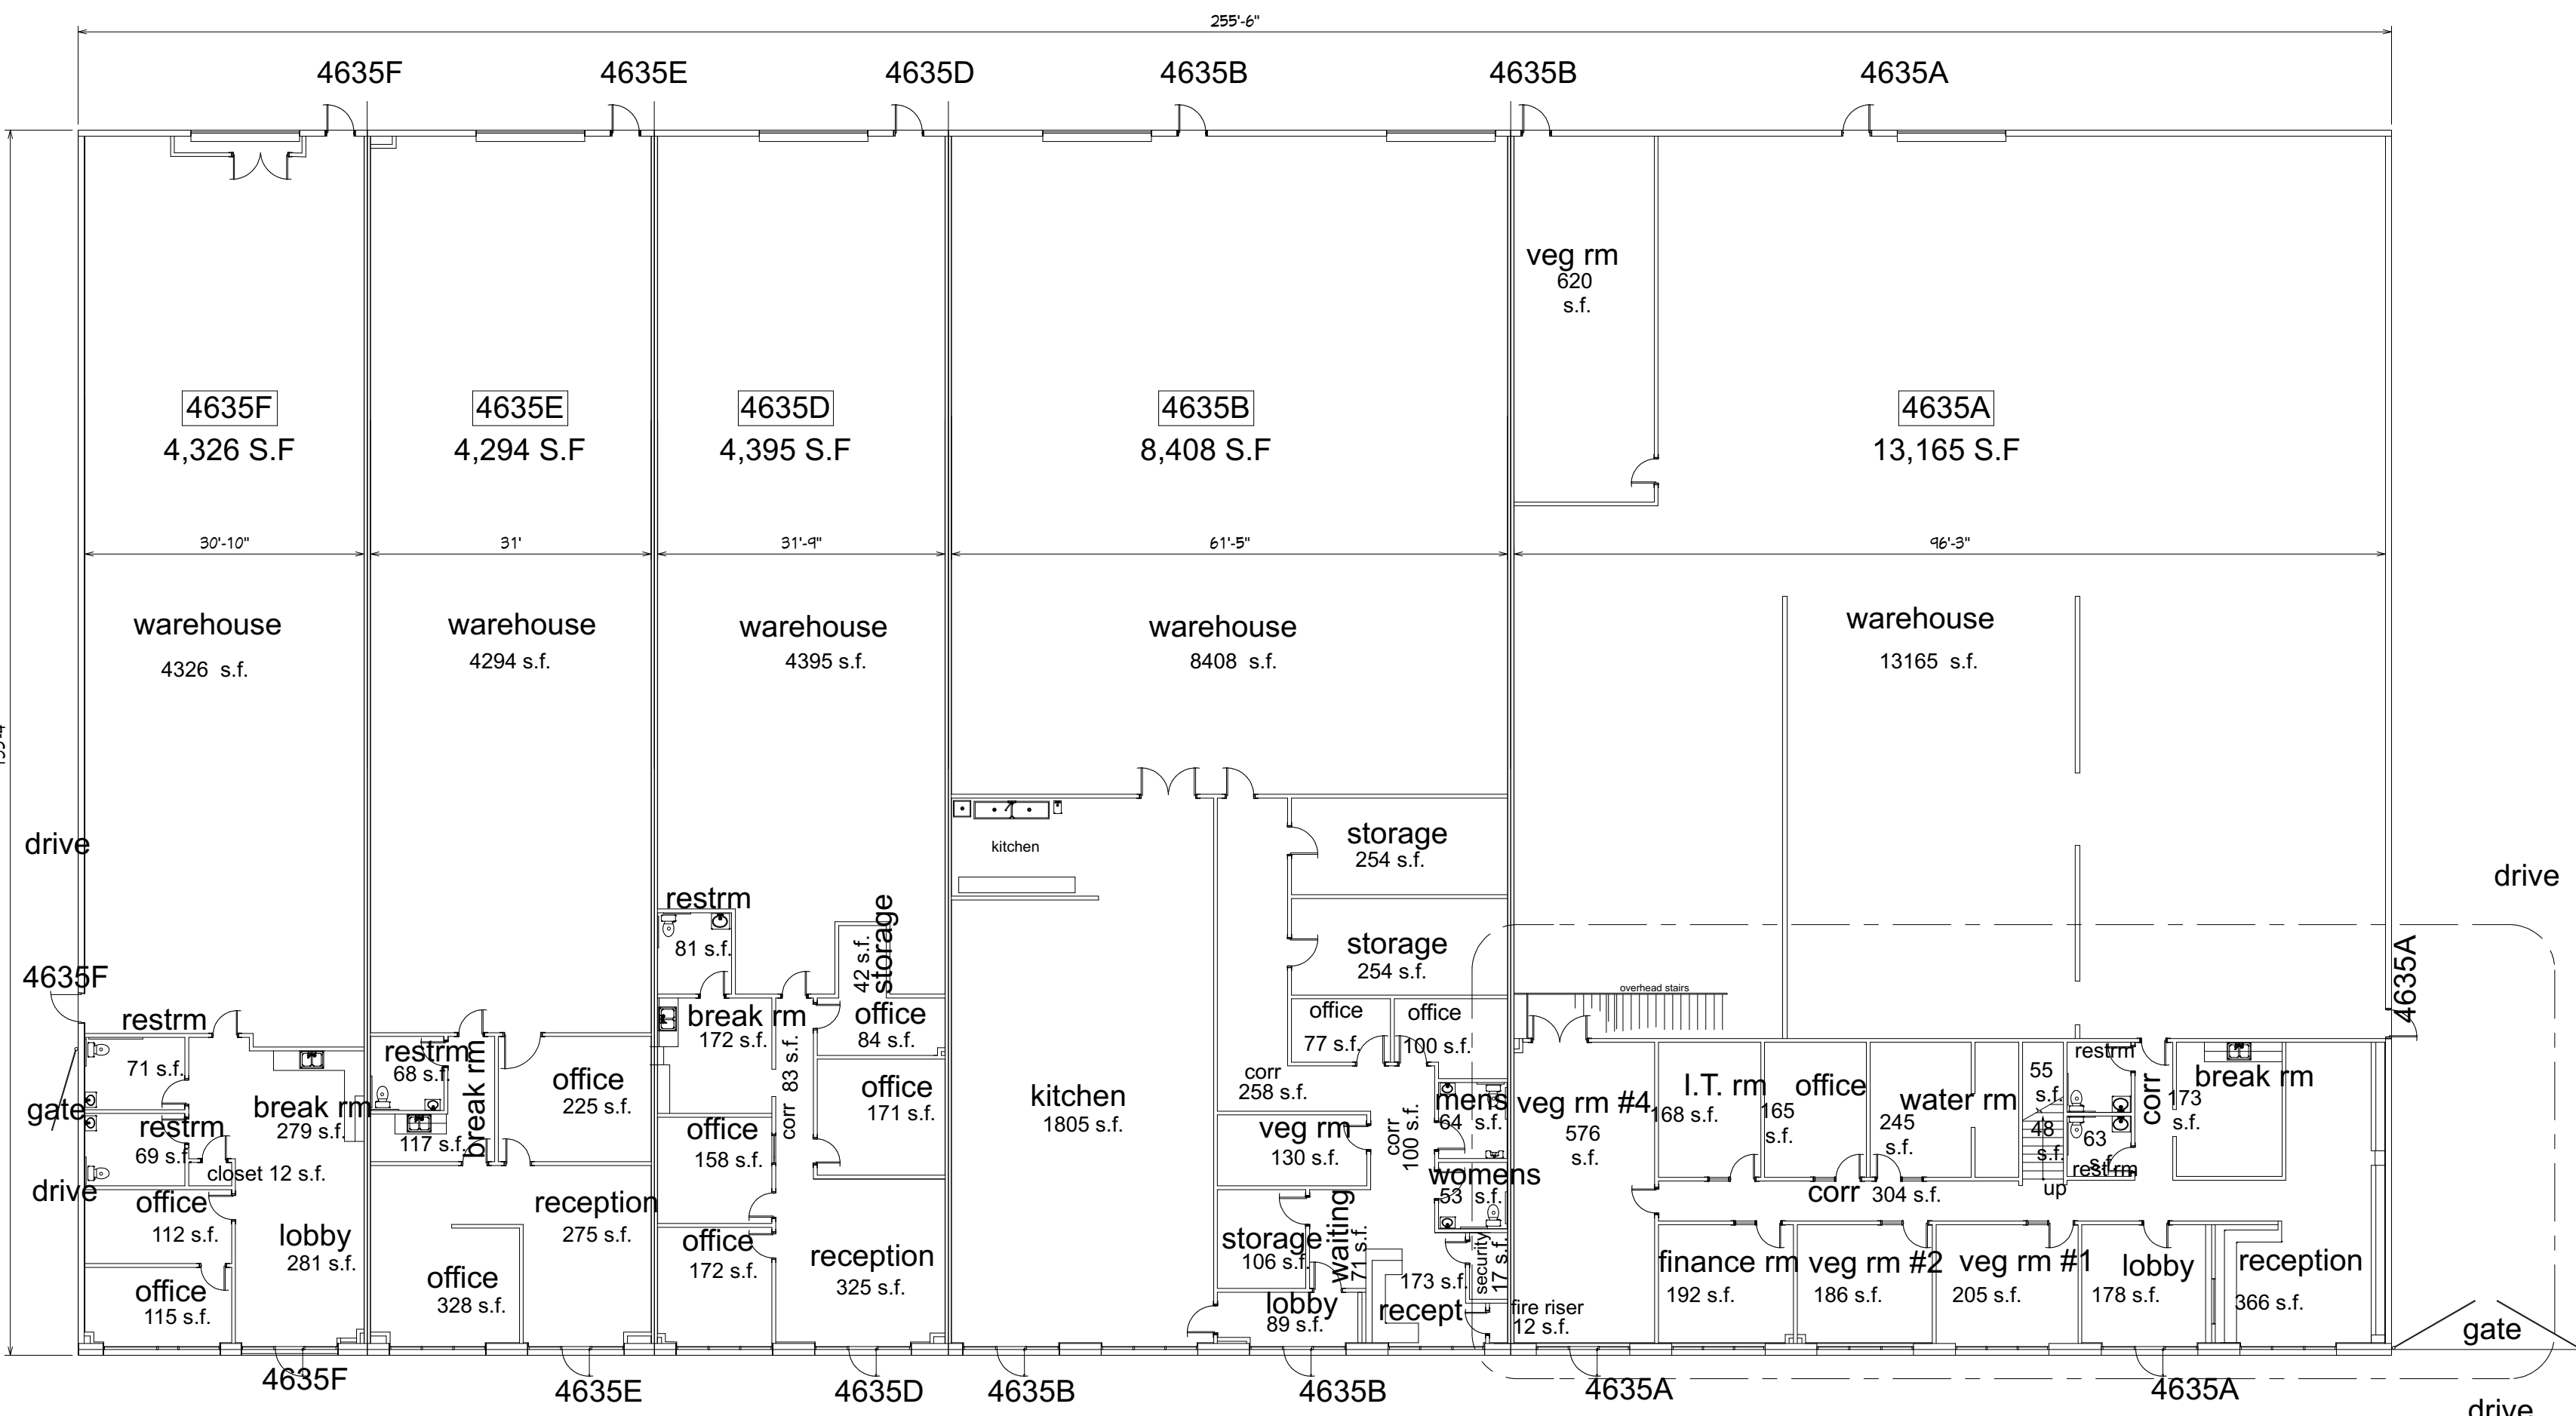



AS-BUILT DRAWINGS
FOR
4365 ANDREWS STREET
NORTH LAS VEGAS, NV

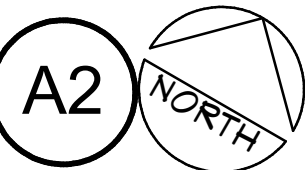

FLOOR PLAN - SECOND FLOOR (4635A)

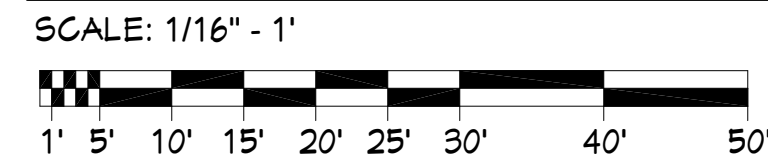

FLOOR PLAN - FIRST FLOOR

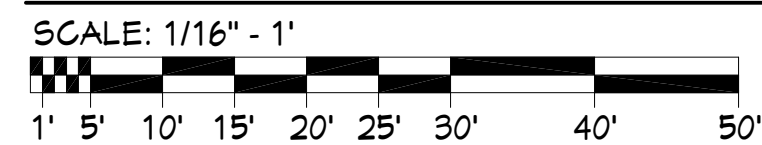

PROJECT:
23ANDREW4635
ADDRESS:
4635 ANDREWS STREET
NORTH LAS VEGAS, NV
APN:
140-06-110-010

SHEET TITLE:

FLOOR PLAN

FIELD
MEASUREMENTS

REVISION	DATE

SHEET NAME:
1 OF 1
AB-1
JOB NO: 23ANDREW4635
RELEASE DATE: 6/6/2023