

NINTH STREET INDUSTRIAL
NINTH STREET - ADDRESS T.B.D.
RANCHO CUCAMONGA, CA

FLOOR PLANS BLDGS F AND G


REVISION:

1	2-24-06	Plan Check
2	12-9-05	Client Rev.
3	2-24-06	Fire Const. Services
5	8-8-06	Client Rev.


DATE SEPTEMBER 8, 2005

JOB NO: 04150
SHEET:

A-2.3
OF SHEETS

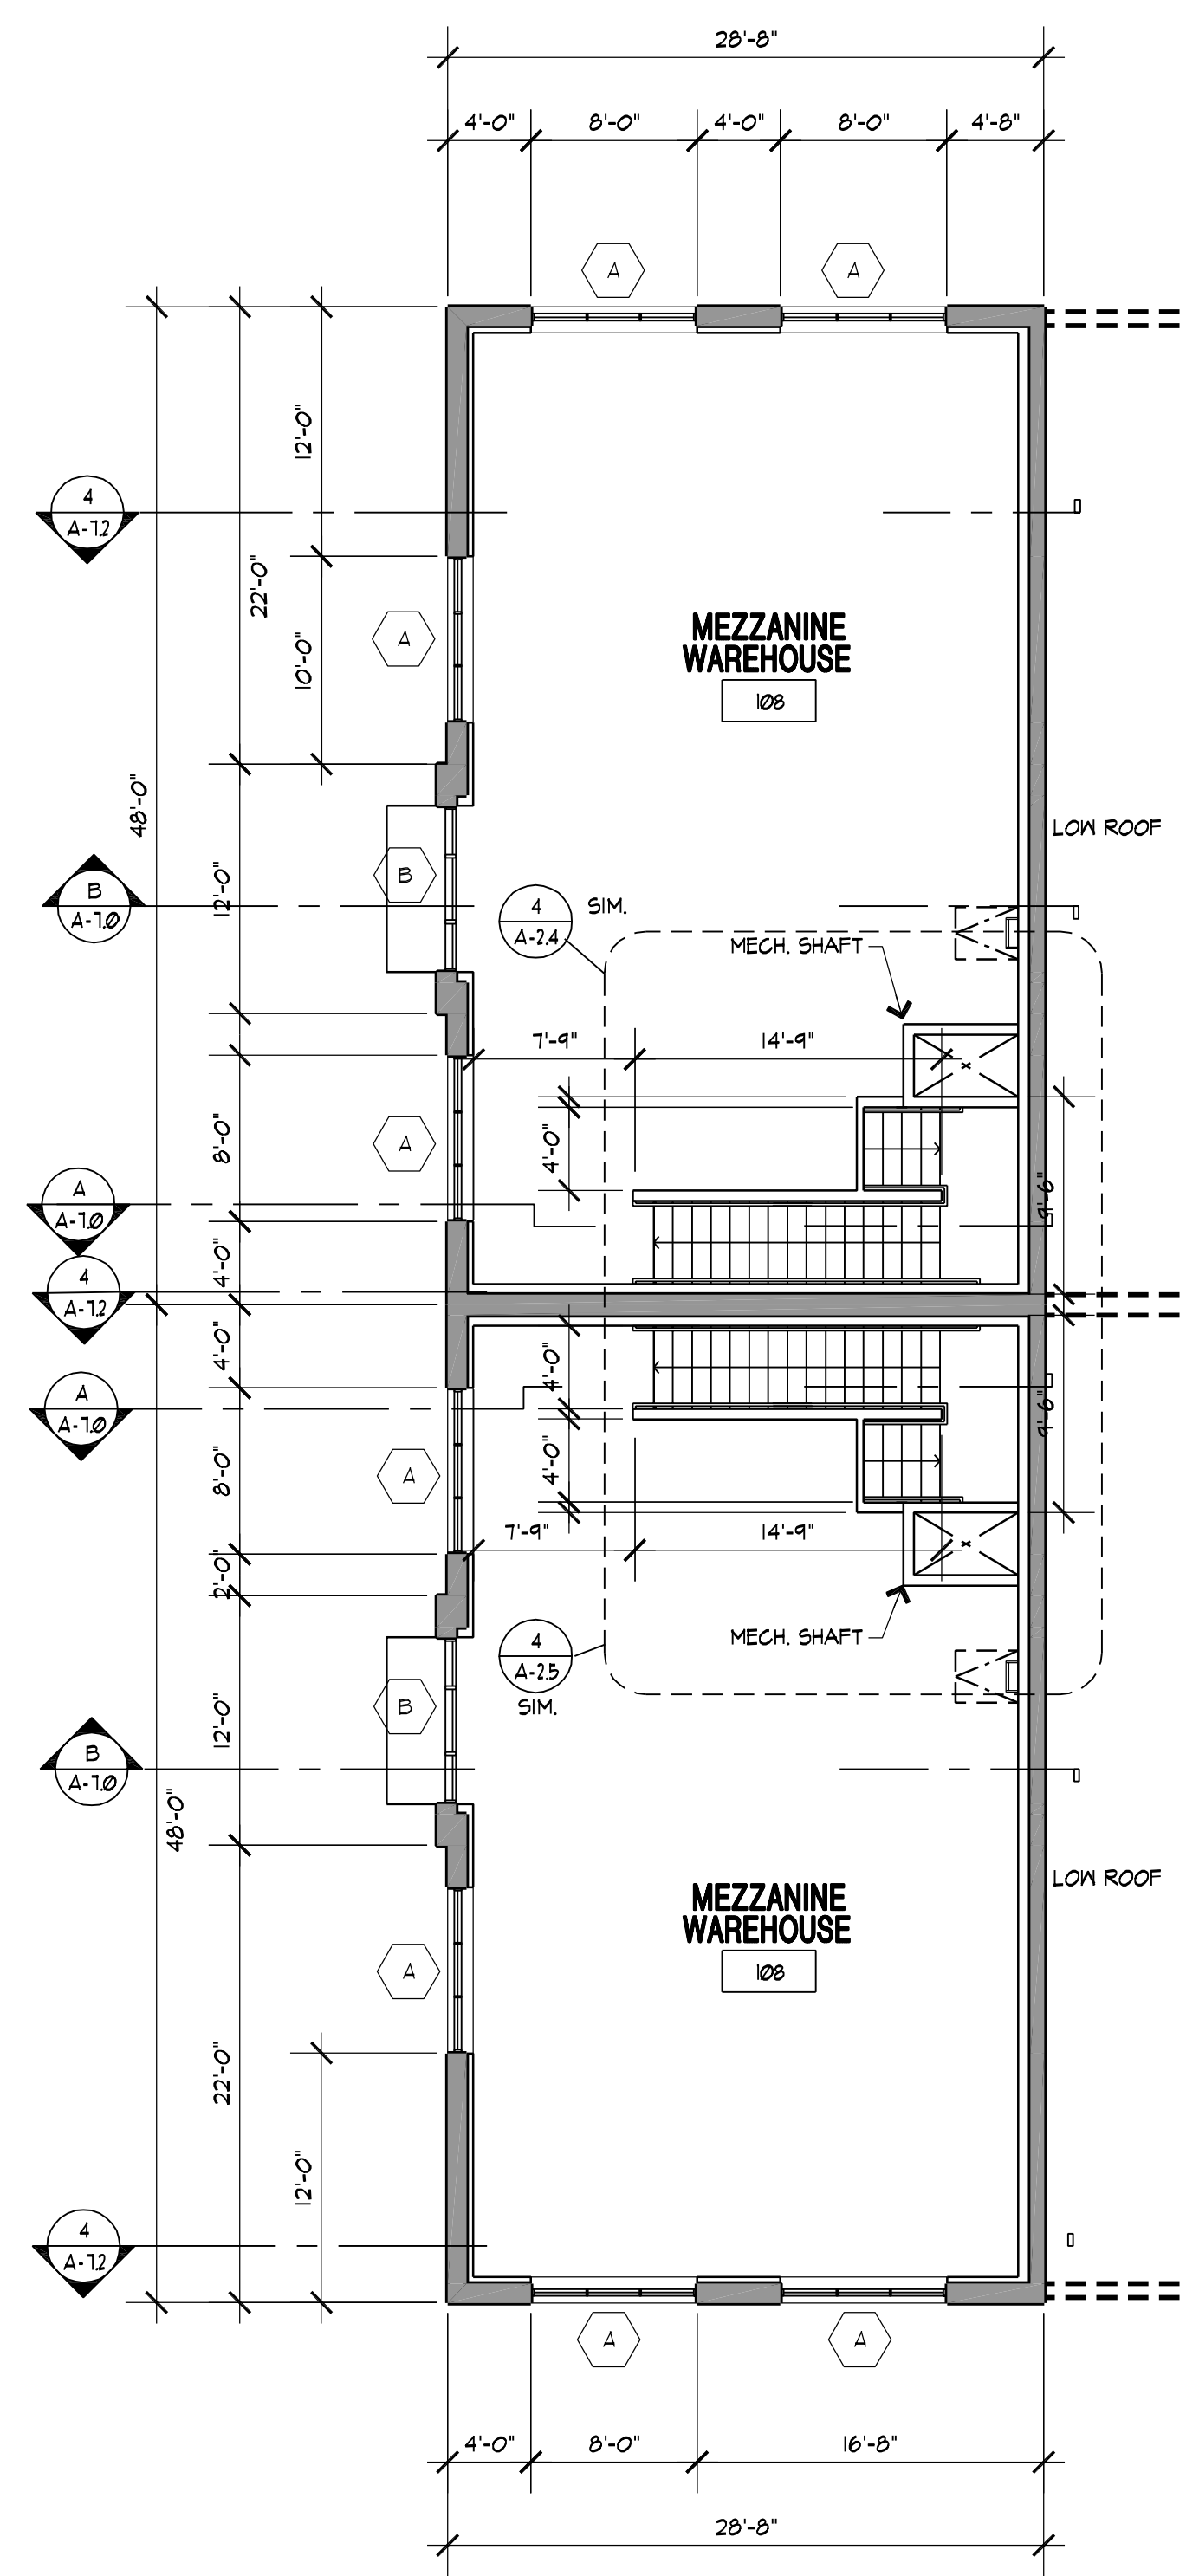


MEZZANINE FLOOR PLAN - BLDGS F & G

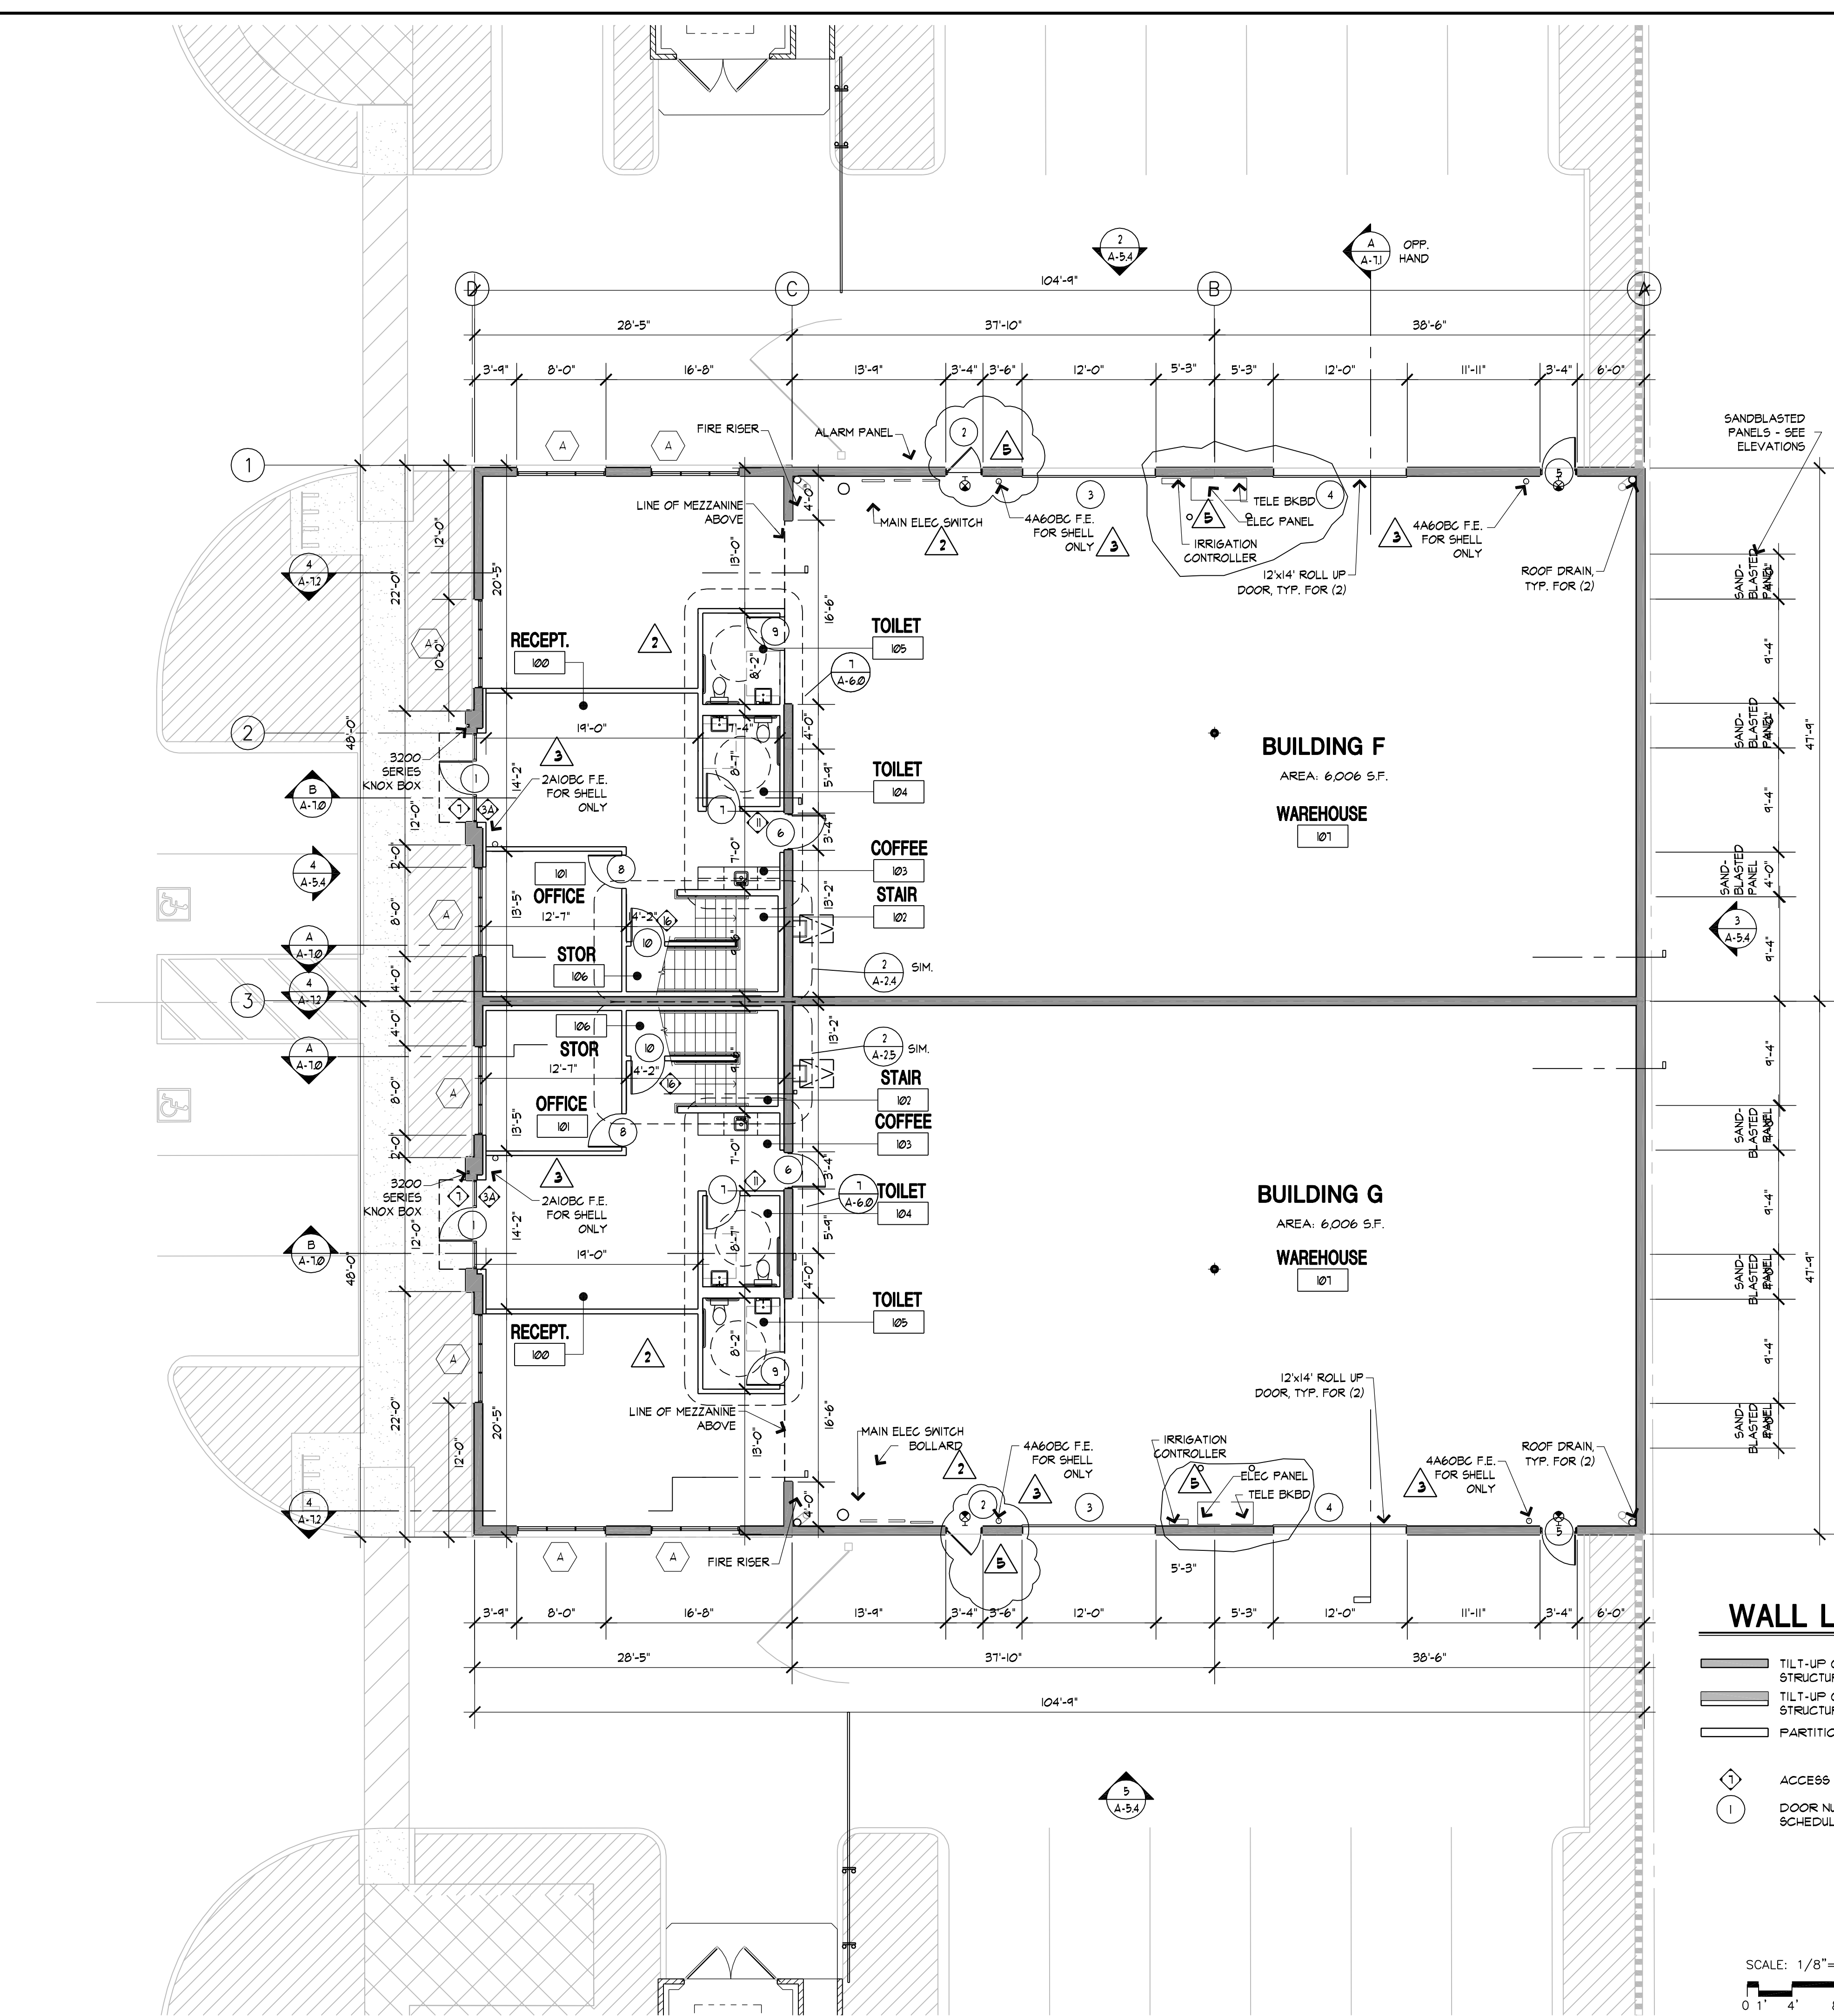

FIRST FLOOR PLAN - BUILDINGS 'F' & 'G'

WALL LEGEND

- TILT-UP CONCRETE PANEL, SEE STRUCTURAL
- TILT-UP CONCRETE PANEL W/ FURRING, SEE STRUCTURAL AND DETAIL
- PARTITION WALL, SEE DETAIL
- ACCESS SIGN, SEE SHEET A9.0
- DOOR NUMBER, SEE DOOR SCHEDULE SHEET A9.1

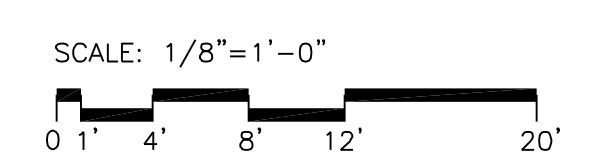

SCALE: 1/8"=1'-0"