

KENNETH J. VILLANO
DESIGNER
MASTER HOME BUILDER

1161 SEAGULL LANE
CHERRY HILL, NJ 08003
2302 ATLANTIC AVE
SULLIVANS ISLAND, SC 29482
KJV: (609) 509-3844
ken@villanobuilders.com *

Reviewed By:
A. Scenna, PE.

Signature:
Date:

COPYRIGHT 2024
THIS DRAWING IS THE PROPERTY OF
KENNETH J. VILLANO. UNAUTHORIZED
USE OF ANY KIND INCLUDING USE
ON OTHER PROJECTS IS PROHIBITED

ERGXD BUILDING
ADDITION & RENOVATION

KV 300 LLC.
300 S. RT. 73
BERLIN, NJ 08009

BLOCK: 1209 LOT: 11
ZONING: C-3
LOT SIZE: 1951 S.F.
ACRAGE: 0.45

KJV: (609) 509-3844
ken@villanobuilders.com *

FILE NAME: ERGXD BUILDING

DESIGNED BY: KJ. VILLANO

DRAWN BY: KJ. VILLANO

CHECKED BY: KJ. VILLANO

REVISION DATE:

REVISION DATE:

REVISION DATE:

REVISION DATE:

PROJECT NO:

SCALE:


DATE: 2-20-2024

SIGNATURE:


AS - BUILTS
BASEMENT & FIRST FLOOR PLANS

DRAWING NO.

A-1.1

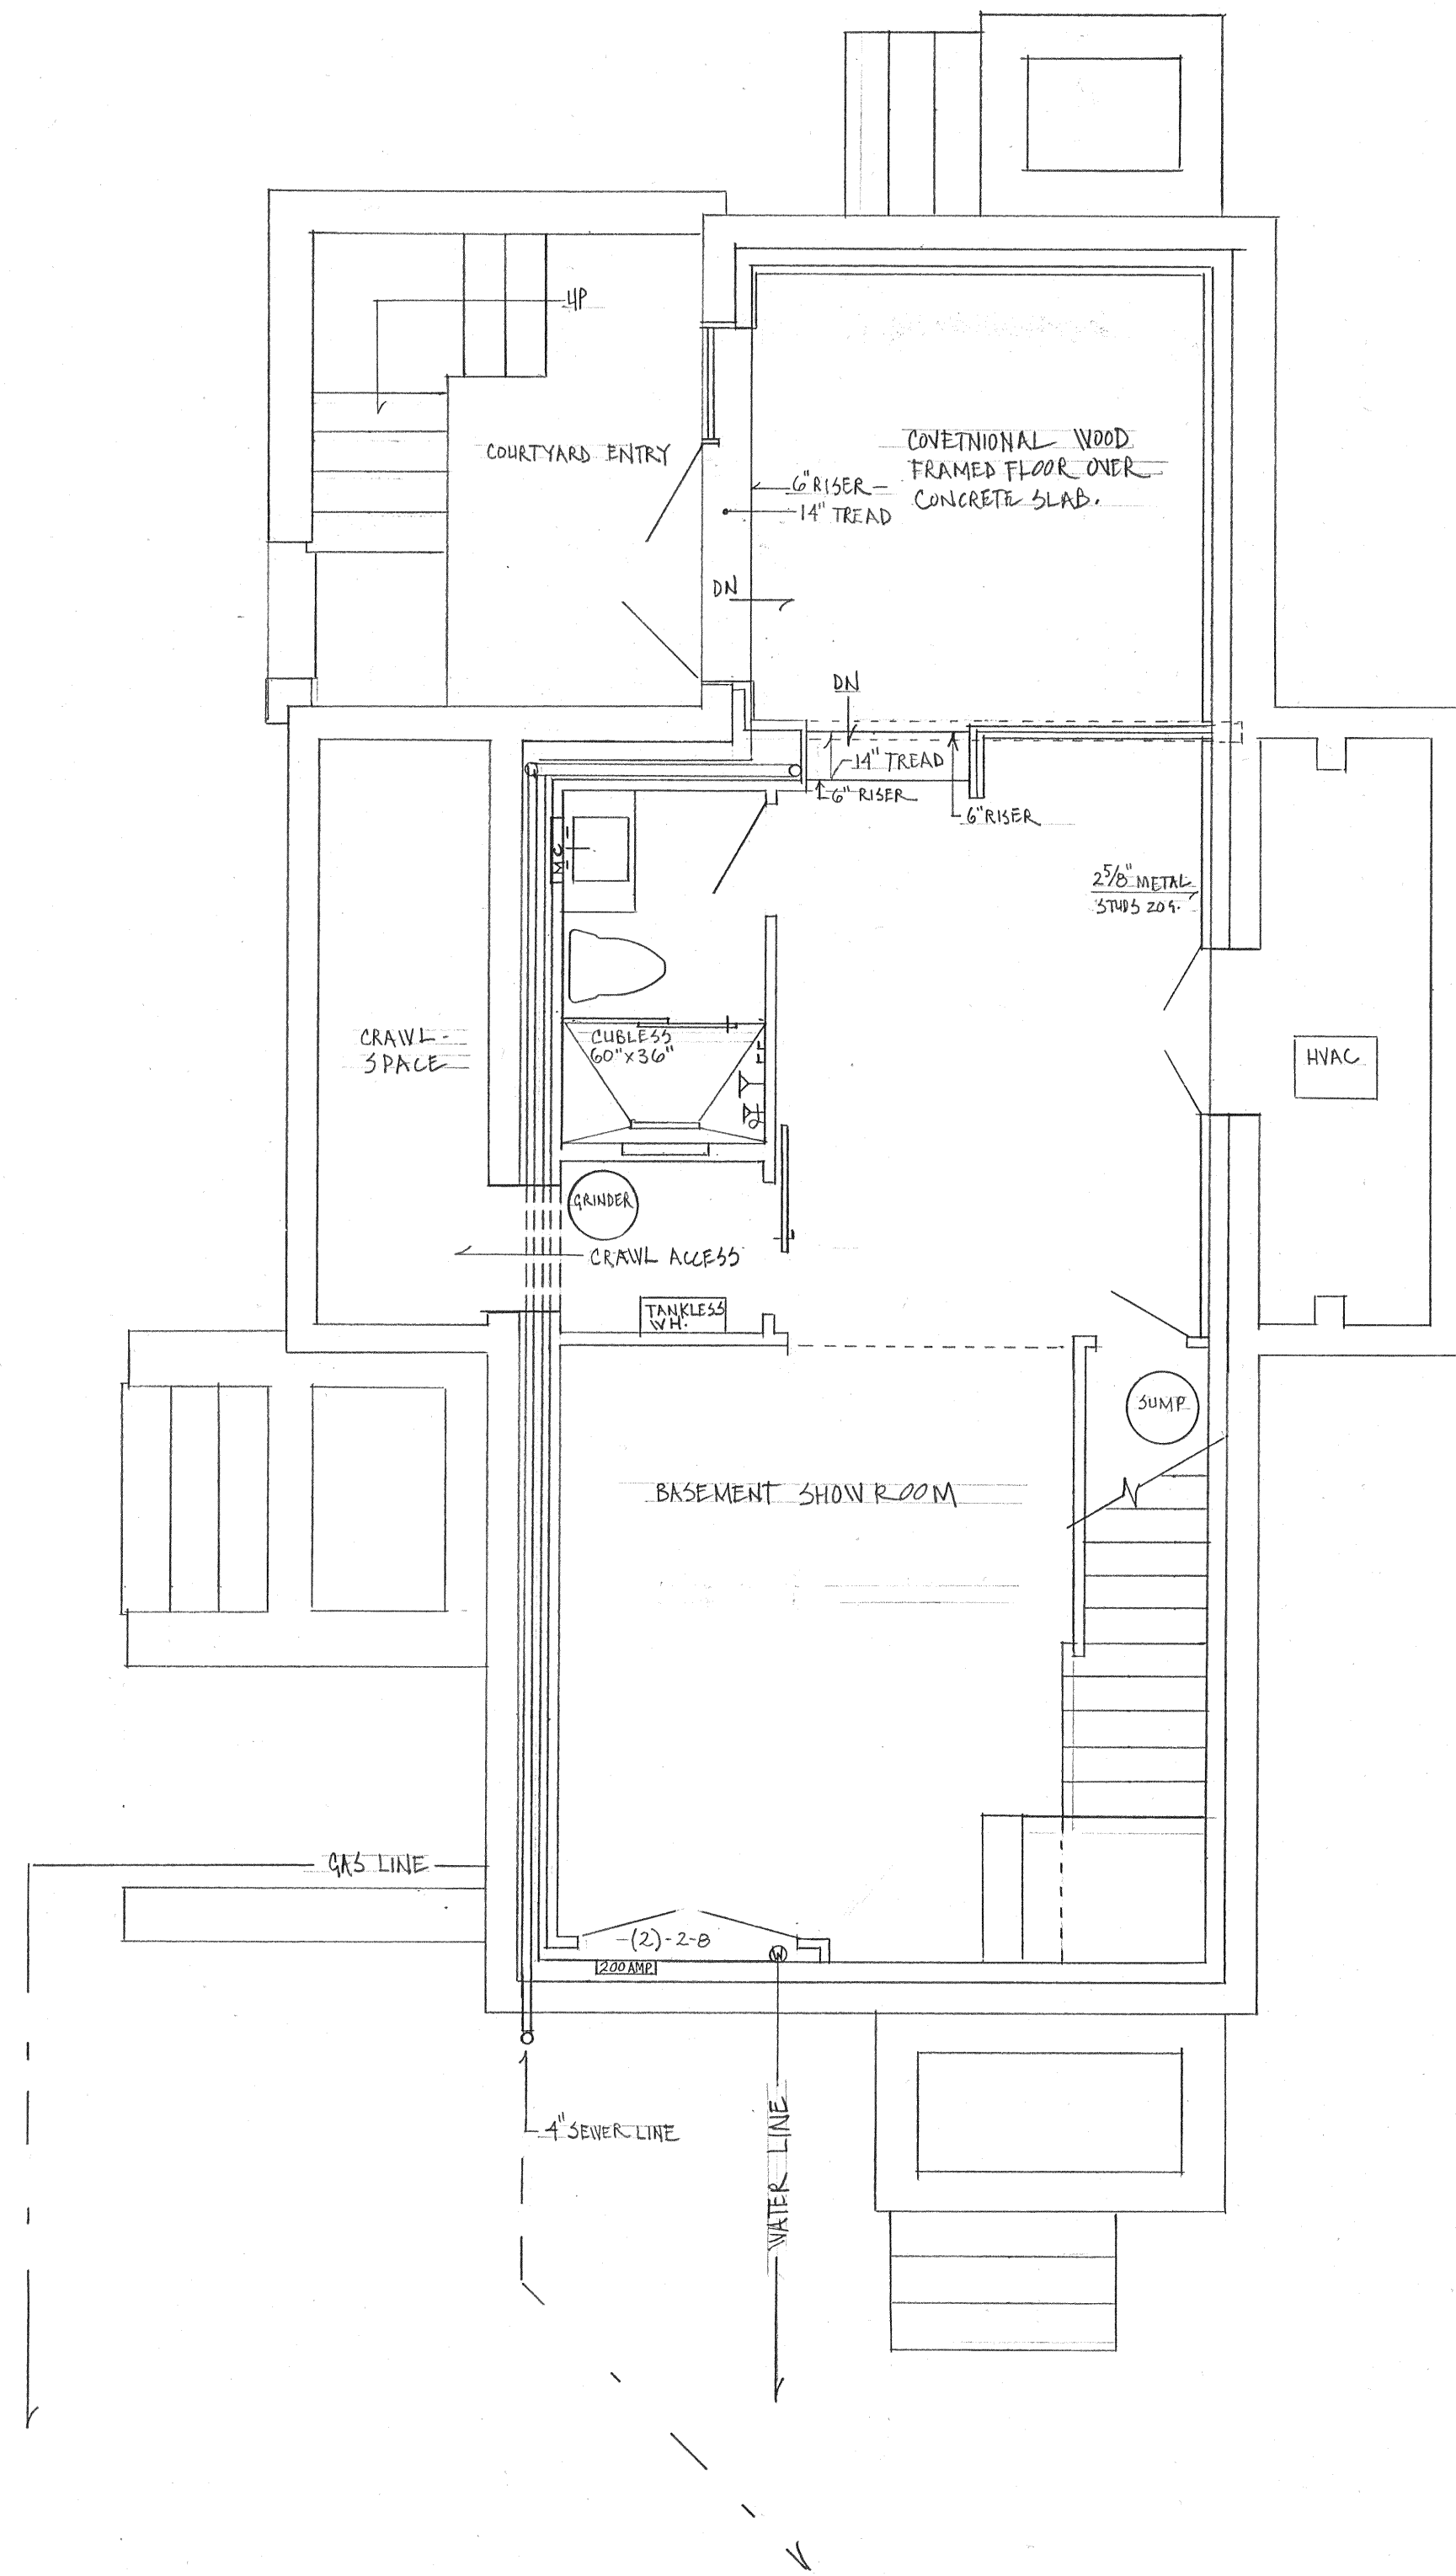

1 BASEMENT FLOOR - AS-BUILT PLAN 1/4"=1'-0"

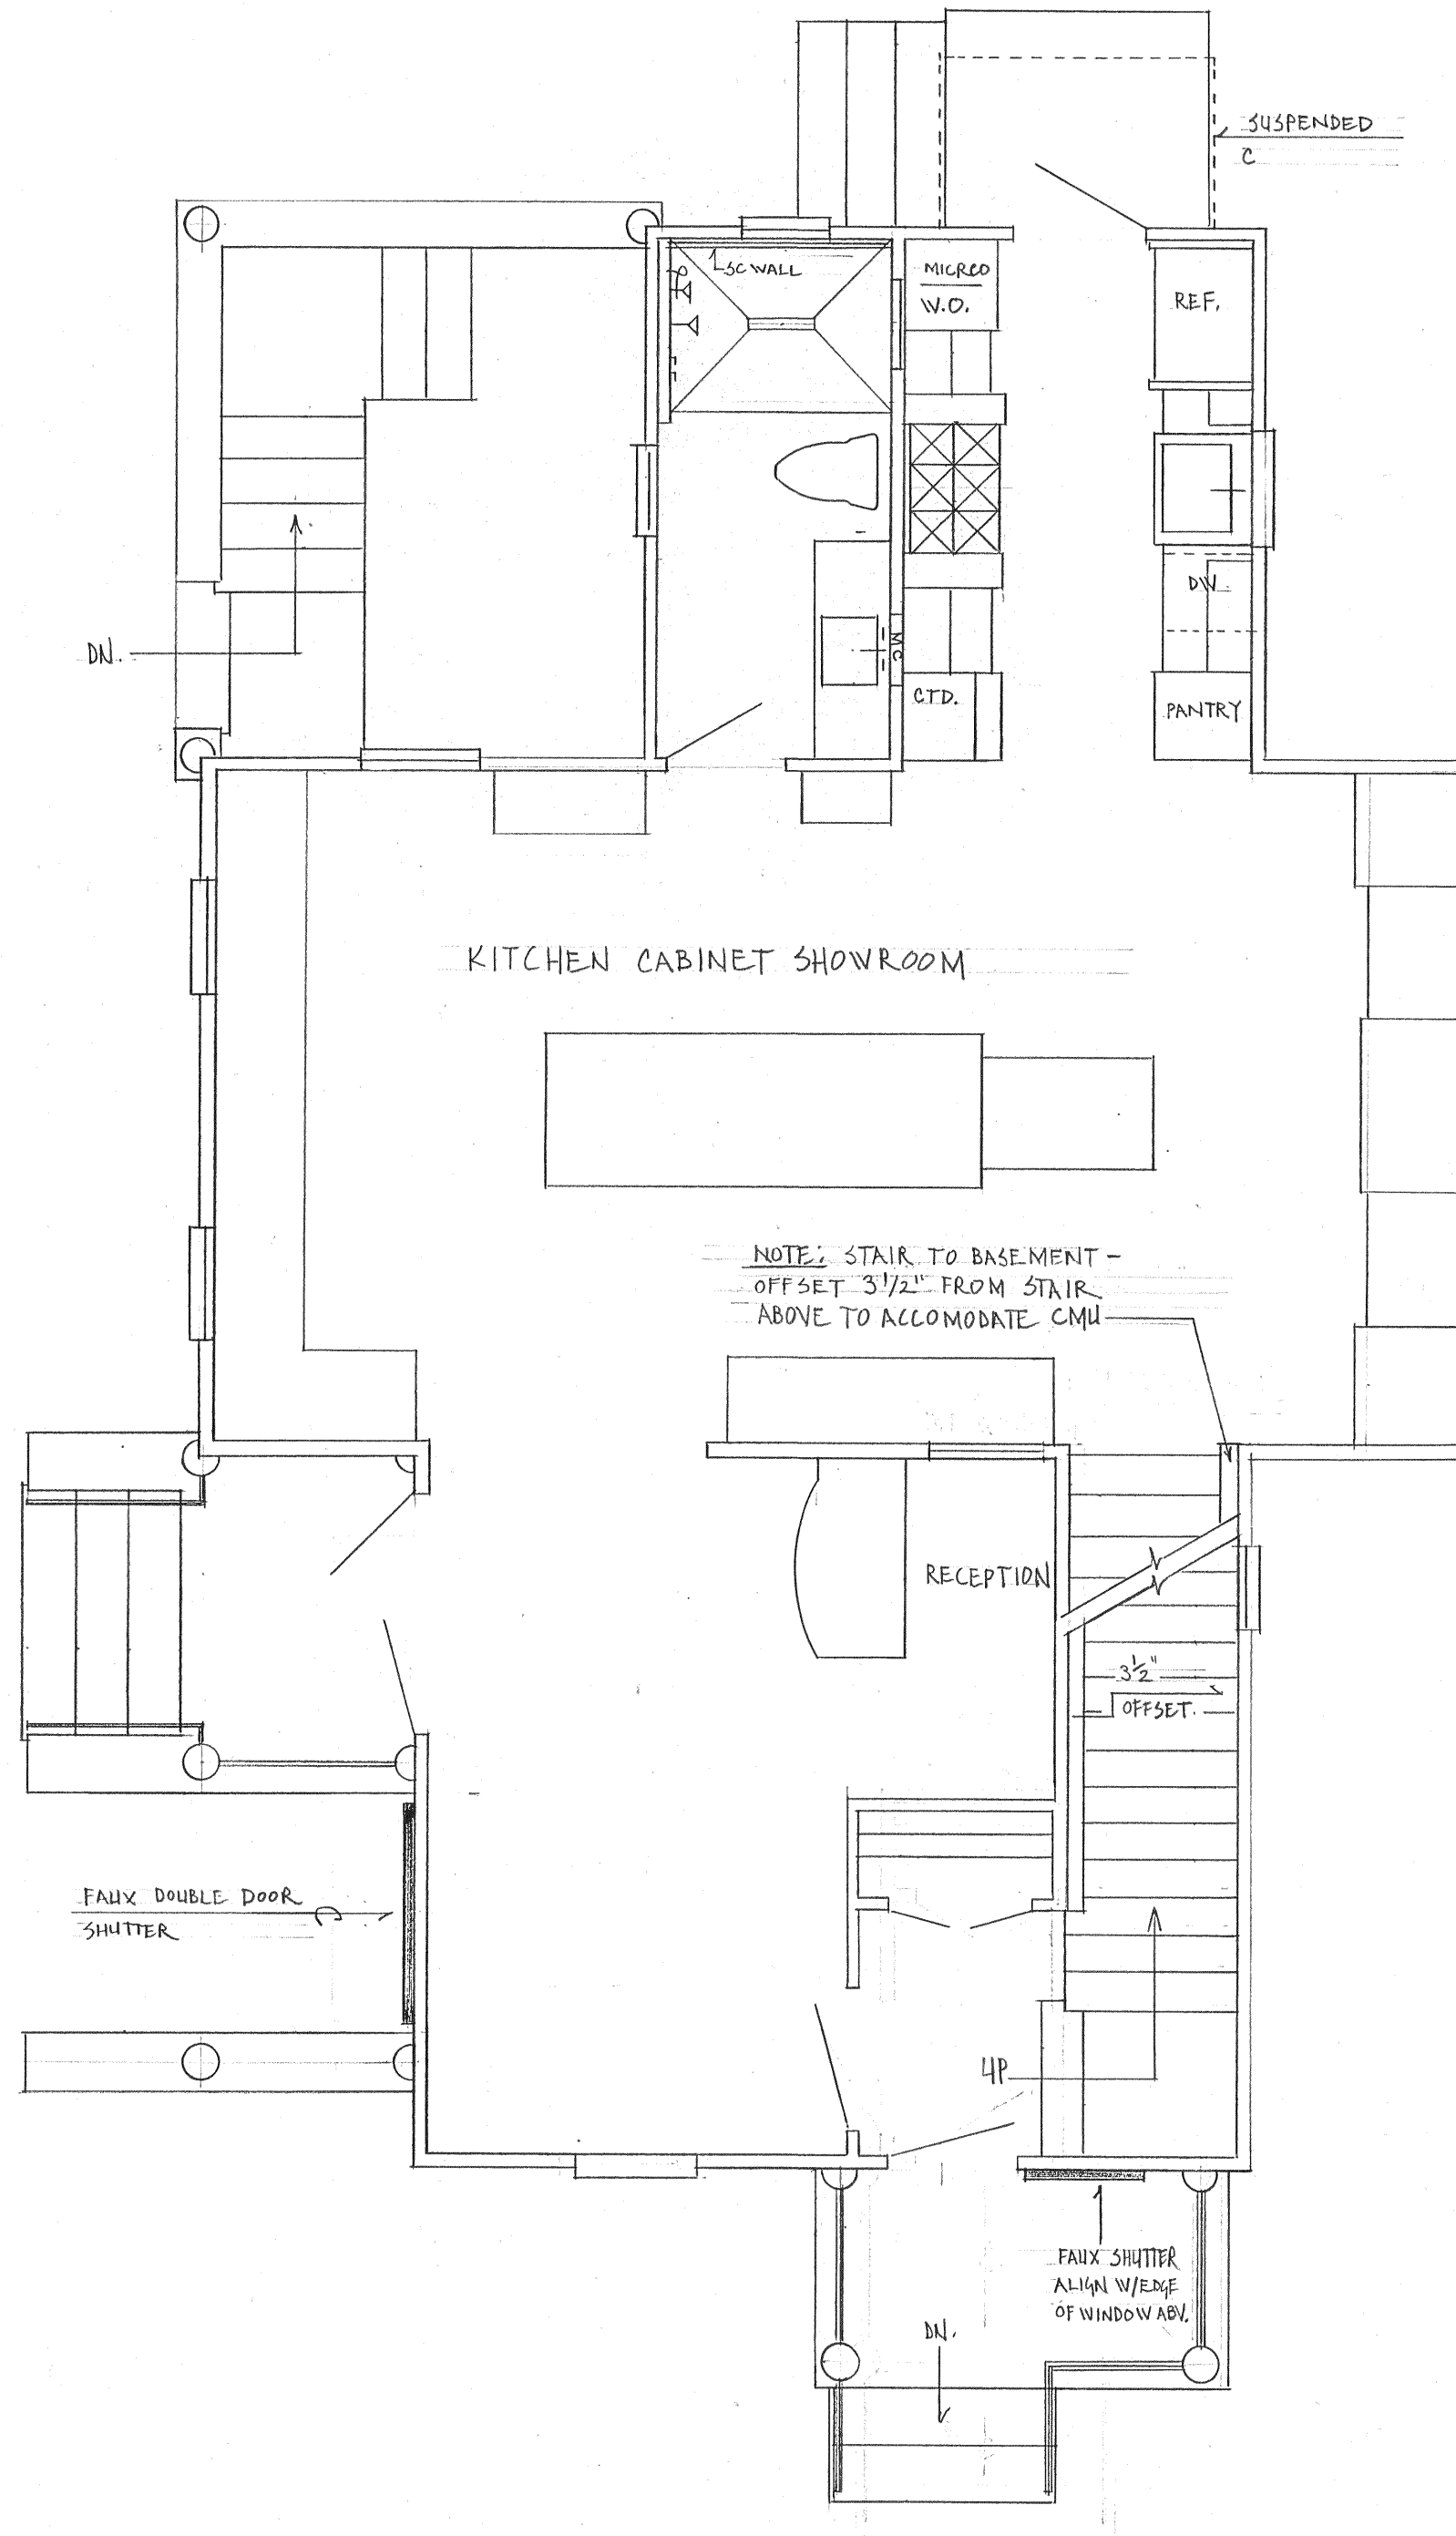

2 FIRST FLOOR - AS-BUILT PLAN