

DOOR SCHEDULE														
DOOR								FRAME		REMARKS				
TAG	OPERATION	EL.	TYPE	SIZE (WxHxTHK)	MAT'L	FINISH	MAT'L	FINISH	LABEL	RATING	HARDWARE	LOCATION	NOTES	
A	SWINGING	1		3'-0"x6'-8"x1 1/2"	WD	PT	WD	PT	NOT	REQUIRED	A,C	ENTRY	SOLID CORE	
B	SWINGING	1		3'-0"x6'-8"x1 1/2"	WD	PT	WD	PT	NOT	REQUIRED	B	ACCESS	HOLLOW CORE	
C	SWINGING	1		3'-0"x6'-8"x1 1/2"	WD	PT	WD	PT	NOT	REQUIRED	B	RESTROOMS	HOLLOW CORE	
D	SWINGING	1		2'-6"x6'-8"x1 1/2"	WD	PT	WD	PT	NOT	REQUIRED	B	BATH	HOLLOW CORE	
E	SWINGING	1		3'-0"x6'-8"x1 1/2"	WD	PT	WD	PT	NOT	REQUIRED	B	MECHANICAL	SOLID CORE	
F	SWINGING	1		3'-0"x6'-8"x1 1/2"	WD	PT	WD	PT	NOT	REQUIRED	B	LAUNDRY	HOLLOW CORE	
G	SWINGING	1		3'-0"x6'-8"x1 1/2"	WD	PT	WD	PT	NOT	REQUIRED	B	STAIRS	SOLID CORE	
H	D.SWINGING	1		3'-6"x6'-8"x1 1/2"	WD	PT	WD	PT	NOT	REQUIRED	B	METERS	HOLLOW CORE	

DOOR HARDWARE:
A - KEYS LOCK WITH LEVER TYPE HANDLES
B - PUSH-BUTTON PRIVACY LOCK.
C - KEYS DEADBOLT WITH LEVER OPERATED RELEASE
D - KEYS LOCK WITH KNURLED KNOB.

ALL INTERIOR DOOR HEADERS TO BE (2) 2x8 W/ 1/2" PLYWOOD FLITCH PLATE UNLESS NOTED OTHERWISE

OCCUPANCY COUNT
(PER 13-055-1301)
MERCANTILE F : FRONT RETAIL STORE
AREA 931 S.F. / 30 = 31 PERSONS
TOTAL = 31 ALLOWED

OCCUPANCY COUNT
(PER 13-055-1301)
MERCANTILE F : SEATING AREA
AREA 850 S.F. / 15 = 56 PERSONS
TOTAL = 56 ALLOWED
(SUMMARY 31+56=87 PERSONS)


NEW WINDOW SCHEDULE					
#	WINDOW TYPE	ROUGH OPENING	MARVIN WINDOWS		
		WIDTH	HEIGHT	LIGHT (SF)	VENT (SF)
1	DOUBLE HUNG	3'-2"	6'-0"	17.1 SQ. FT.	8.5500 SQ. FT.
2	* SKYLIGHT OPERABLE	3'-6"	4'-0"	12.6 SQ. FT.	12.6000 SQ. FT.

* PROVIDE LAMINATED SAFETY GLAZING FOR ALL NEW SKYLIGHTS.

EXISTING WINDOW SCHEDULE					
#	WINDOW TYPE	ROUGH OPENING	MARVIN WINDOWS		
		WIDTH	HEIGHT	LIGHT (SF)	VENT (SF)
1	DOUBLE HUNG	3'-2"	5'-5"	15.4 SQ. FT.	7.7188 SQ. FT.
2	DOUBLE HUNG	9'-8"	5'-5"	47.1 SQ. FT.	23.5625 SQ. FT.
3	DOUBLE HUNG	2'-2"	4'-5"	8.6 SQ. FT.	4.3063 SQ. FT.
4	DOUBLE HUNG	1'-11"	1'-11"	3.3 SQ. FT.	1.6531 SQ. FT.
5	DOUBLE HUNG	3'-2"	6'-2"	17.6 SQ. FT.	17.6 SQ. FT.



LEGEND	
NEW WOOD PARTN. WALL	WINDOW
CONCRETE FOUNDATION	DOOR
EXISTING WALL	STAIRS
DOOR TYPE - SEE SCHEDULE	STOVE
WALL PARTITION - SEE SCHEDULE	SINK
WINDOW TYPE - SEE SCHEDULE	FRIDGE
	LAV
	TUB
	FURNACE
	FLOOR DRAIN
	WATER HEATER
	GAS METER
	ELECTRICAL METER
	WOOD POST
	STEEL POST
	BEAM

DEPARTMENT OF BUILDINGS
STANDARD PLAN REVIEW
CONDITIONAL PERMIT
Construction subject to full compliance with the Municipal Code of Chicago and field inspection by Building Commissioner
By 
CERTIFIED CORRECTIONS

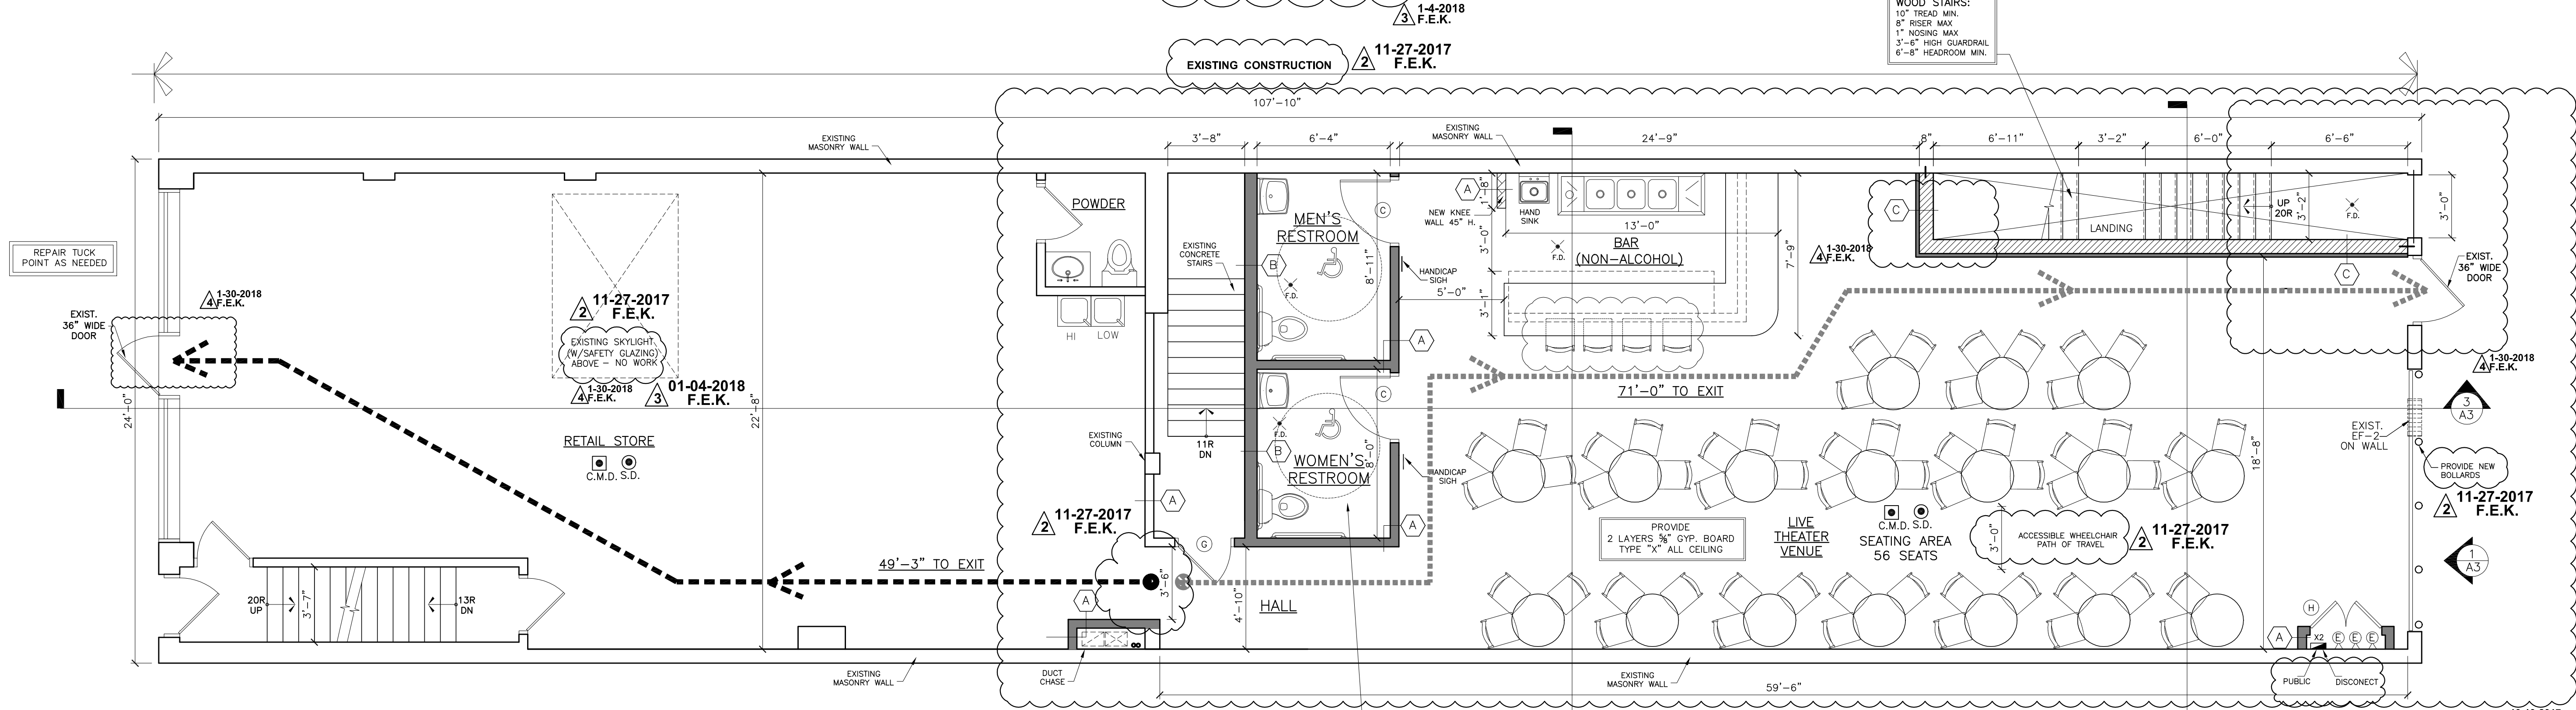



PROPOSED FIRST FLOOR PLAN

SCALE: 1/4" = 1'-0"

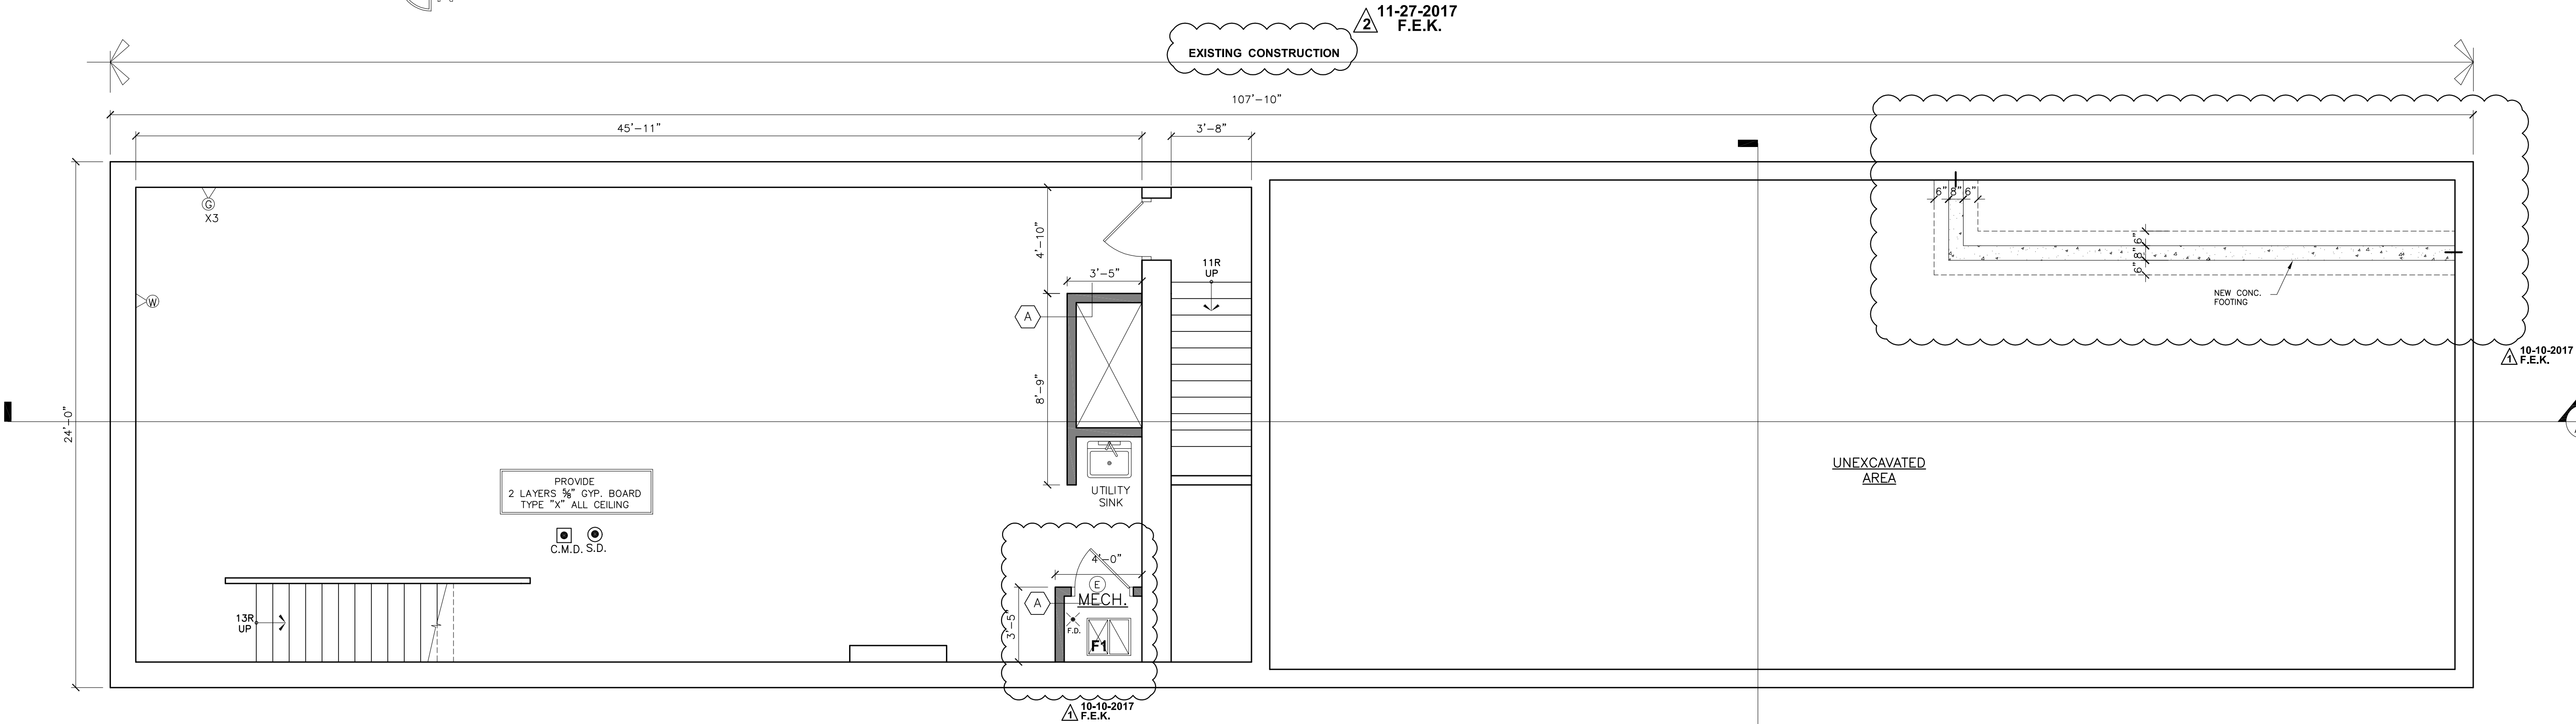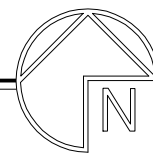

PROPOSED BASEMENT FLOOR PLAN

SCALE: 3/8" = 1'-0"

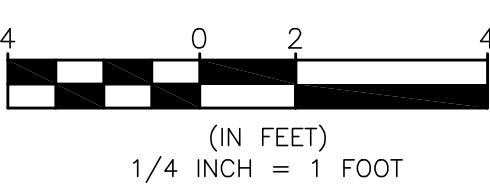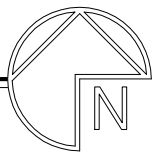

(IN FEET)
1/4 INCH = 1 FOOT

REVISIONS:
10-10-2017 1-30-2018
F.E.K. 4F.E.K.
11-20-2017 1-4-2018
F.E.K. 3F.E.K.
CHECKED BY: F.E.K.
DRAWN BY: A.V.

PROPOSED FLOOR PLANS

1415 N. ASHLAND
CHICAGO, IL.

929 N. Damen Ave.
Chicago IL 60622

773.772.2766
773.772.2854 Fax

ARCHITECTS
ARCHITECTURE
PLANNING
ARCHITECTURAL ENGINEERING

PROJECT:
1415 N. ASHLAND AVE.

SCALE:
1/4" = 1'-0"

DATE:
02-08-17

SHEET:

A1