


ENLARGED FLOOR PLAN

SCALE:  
1/8"=1'-0"

1

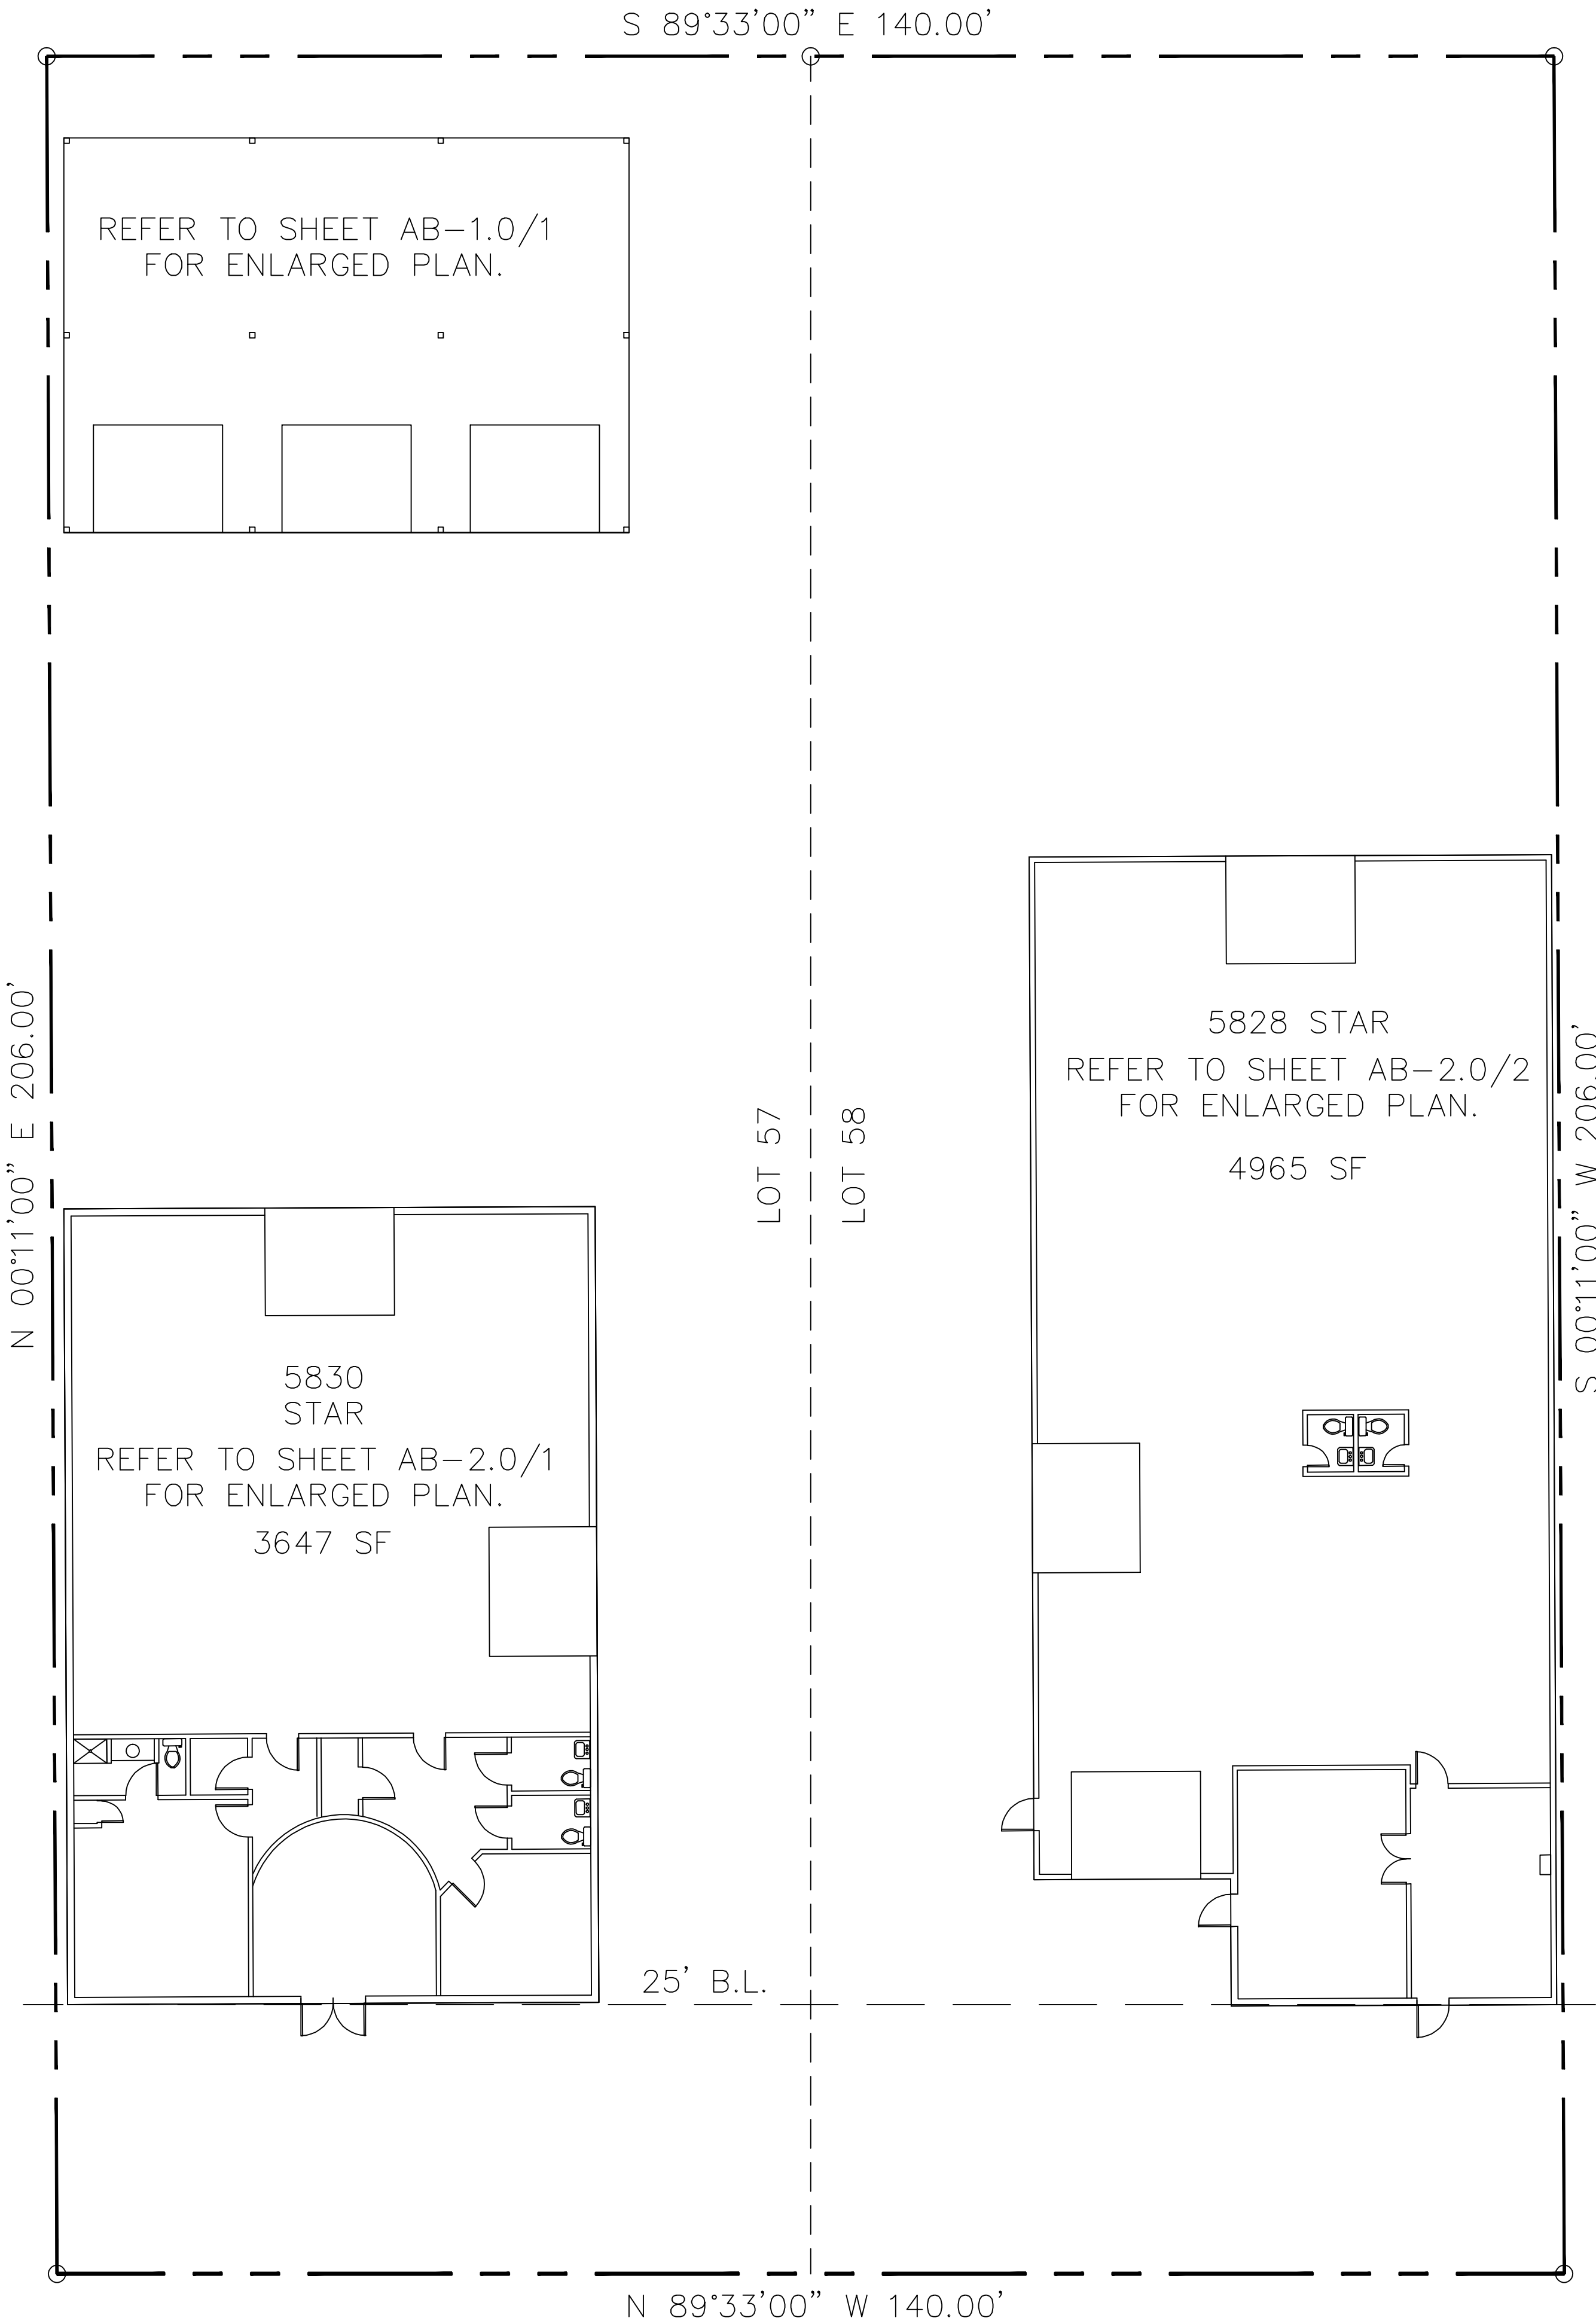

EXISTING SITE PLAN

SCALE:  
3/32"=1'-0"

2

AMC  
DESIGN

• PLANNING  
• DESIGN  
• CONSULTING

1549 Campbell Rd  
Houston, TX 77055  
PHONE: 832-274-4464  
FAX: 281-598-5797  
anthony\_yu@comcast.net

ALL IDEAS, DESIGNS, ARRANGEMENTS AND PLANS INDICATED OR REPRESENTED BY THIS DRAWING ARE OWNED BY AMC AND ARE THE PROPERTY OF THE DESIGNER AND WILL BE KEPT, EVALUATED AND DEVELOPED FOR USE ON AND IN CONNECTION WITH THE SPECIFIED PROJECT. NONE OF SUCH IDEAS, DESIGNS, ARRANGEMENTS, OR PLANS SHALL BE USED BY OR DISCLOSED TO ANY PERSON, FIRM, OR CORPORATION FOR ANY PURPOSE WHATSOEVER WITHOUT THE WRITTEN PERMISSION OF THE DESIGNER. WHEN TAKING NOTES ON THESE DRAWINGS, CONTRACTORS SHALL VERIFY AND BE RESPONSIBLE FOR ALL DIMENSIONS AND CONDITIONS ON THE JOB. THE OFFICE MUST BE NOTIFIED OF ANY VARIATIONS FROM THE DIMENSIONS OR CONDITIONS SHOWN ON THESE DRAWINGS.

LEASE SPACE REMODEL FOR:  
STAR LANE AS-BUILDS  
5830 STAR LANE  
HOUSTON, TX.

DRAWING ISSUED FOR:


REVISIONS

△	DATE:	DESCRIPTION:
△		
△		
△		
△		

DATE: 06/28/19  
DRAWN BY: J.CAMPBOS  
CHECKED BY: A.V./J.F.  
PROJECT: A.V./J.F.  
FILE NO:

SHEET TITLE:  
AS-BUILT  
FLOOR PLAN

SHEET NO:  
AB-1.0