


# 354 MERRIMACK STREET 3RD FLOOR, SUITE 311

AS BUILT PLAN

1,500 SF

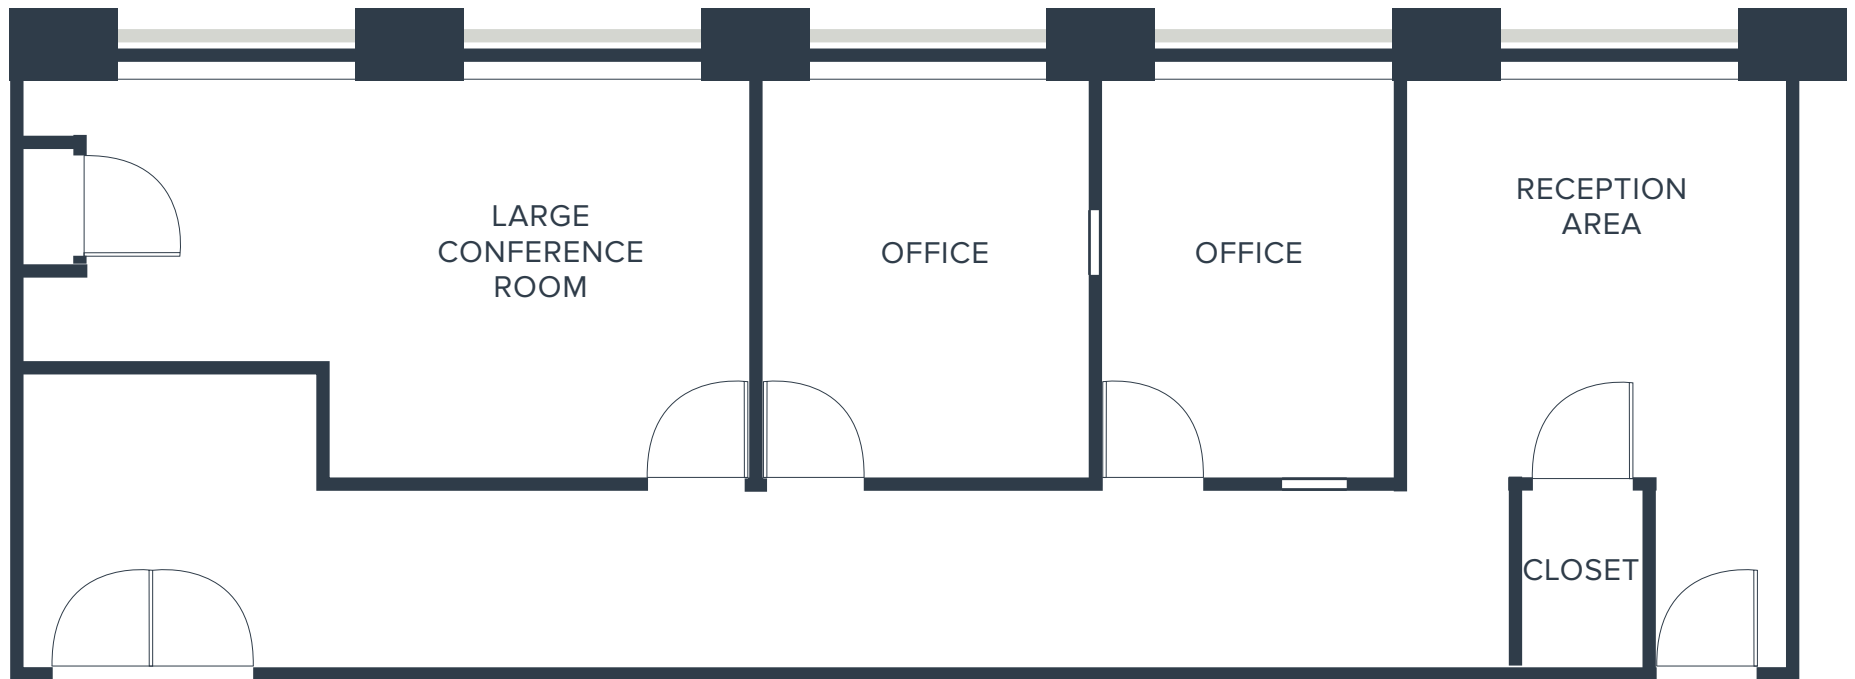

RIVERWALKINNOVATION.COM  
978.681.7777

Not to scale. For marketing purposes only.



RIVERWALK  
INNOVATION DISTRICT